

Wisconsin Registered Land Surveyor S-1594


W4056 BRAY RD.
ELKHORN, WI. 53121
PHONE: (262) 723-4260 (OFFICE)
(262) 723-7209 (FAX)
Email: abernathy@elknet.net

Lots 6727 - 6731 inclusive of Block 115
of Lake Como Beach Subdivision located in
Section 28, Town 2 North, Range 17 East,
Walworth County, Wisconsin.

Owner: Ron Gazija
367 Kerry Way
Grayslake, Il. 60030

 FOUND IRON PIPE
 FOUND IRON ROD
 FOUND BRASS CAPPED MONUMENT
 FOUND CONCRETE MONUMENT
 CHISEL CUT IN CONCRETE
 SET IRON ROD, 24" LONG, WEIGHING
1.5 LBS./LINEAL FT., 3/4" DIA.
 SET IRON ROD, 30" LONG, WEIGHING
4.5 LBS./LINEAL FT., 1-11/16" DIA.
x x) RECORDED AS DIMENSION|
x x EXISTING FENCE

9993 sq. ft. (0.23 ac.)
Tax Key No. JLCB - 1411

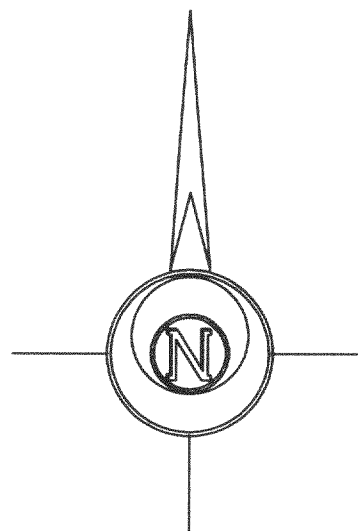

SCALE: 1" = 40 FEET

"I hereby certify that the above described property has been surveyed by me or under my direction and that the above map is a true representation thereof and shows the size and location of the property, its exterior boundaries, the location of all visible structures and dimensions of all principal buildings thereon, boundary fences, apparent easements, roadways and visible encroachments, if any."

"This survey is made for the use of the present owners of the property, and also those who purchase, mortgage, or guarantee the title thereto within one year from the date hereof."

Kent B. Buck

KENNETH B. ABERNATHY, JR. S-1594
WISCONSIN REGISTERED LAND SURVEYOR.

DATED June 12, 2002 Job No. 02.601A

Revised April 22, 2003
Proposed Residence
and Garage added.

Revised December 4, 2003
Residence & Garage
under construction
"As Built"

RECEIVED
FEB 23 1971
088

217-2744