

PLAT OF SURVEY


J.K. SURVEYING INC.
FORMERLY KOLB LAND CONSULTING
N3705 WILLOW BEND LN. LAKE GENEVA
(262) 248-3697

DATE OF LAST REVISION : 12 / 12 / 2003

DATE: 10/2/1998

ORDERED BY: BOB CAMPS
W3465 HWY.H NORTH
LAKE GENEVA, WI 53147


DESCRIPTION: LOTS 4498-4507 INCLUSIVE AND 4523- 4526 INCLUSIVE BLOCK 78 LAKE COMO BEACH A SUBDIVISION LOCATED IN
T2N, R17E, WALWORTH COUNTY, WISCONSIN

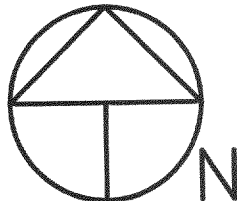

SCALE 1"=30'
BEARINGS REFERENCED TO RECORD
PLAT OF LAKE COMO BEACH SUBDIVISION

LEGEND


- FOUND IRON PIPE
- SET RAILROAD SPIKE
- SIREN POLE
- (XXX) RECORDED AS
- ▣ SIGN

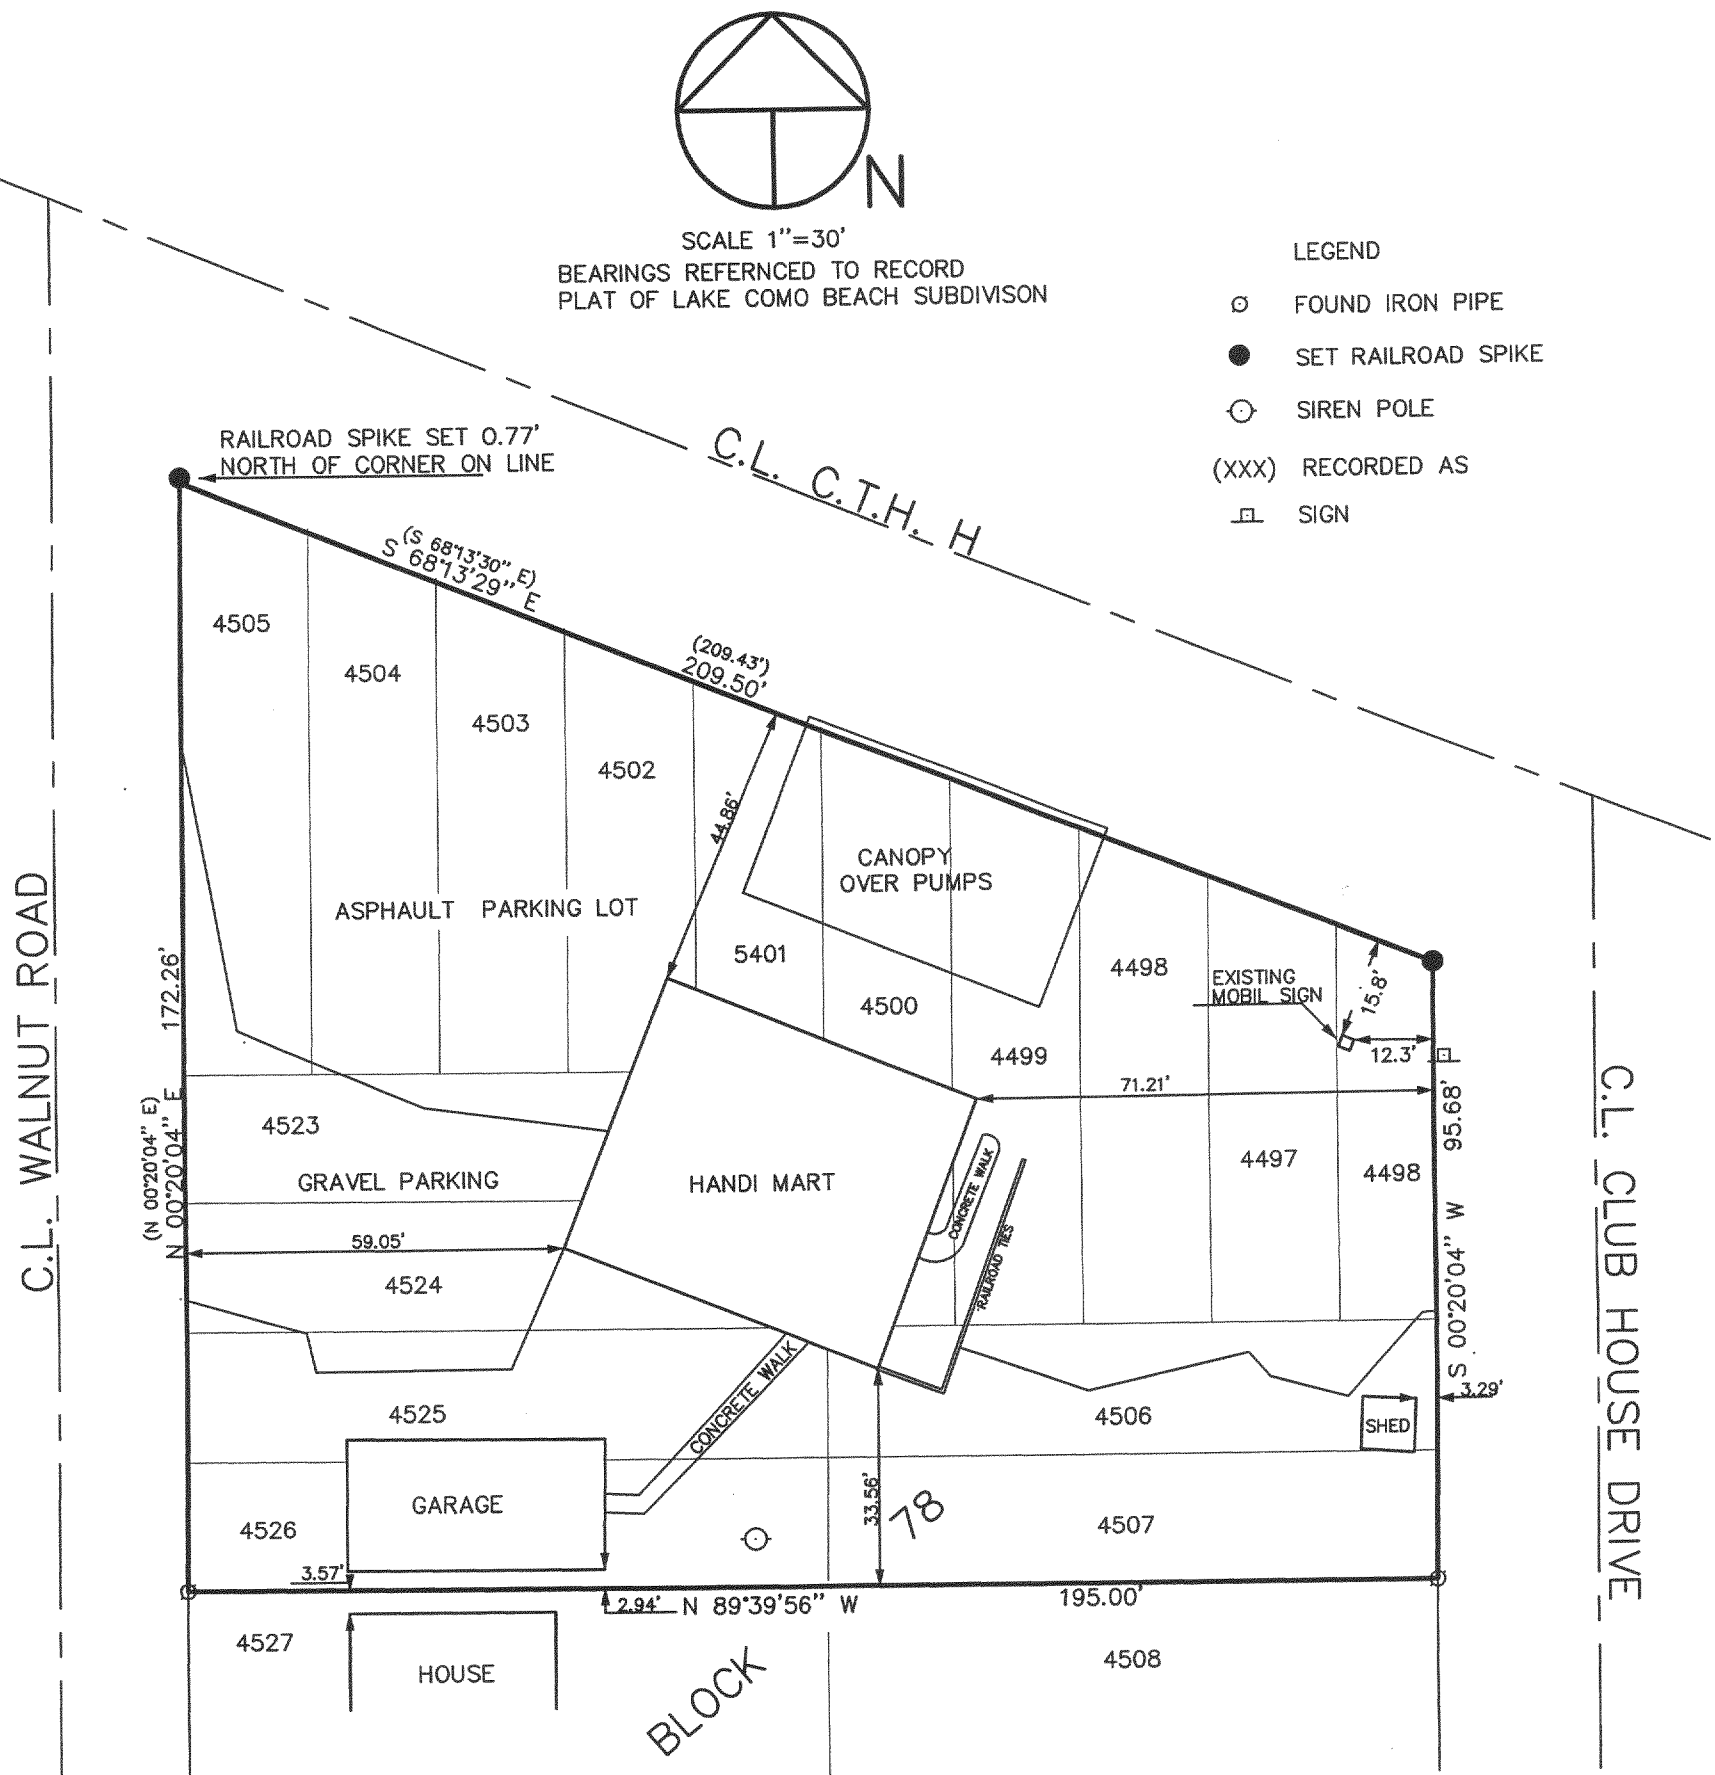

THE ABOVE MAP IS A TRUE REPRESENTATION THEREOF AND
SHOWS THE SIZE AND LOCATION OF ALL THE PROPERTY,
EXTERIOR BOUNDARIES, THE LOCATION OF ALL VISIBLE
BOUNDARY FENCES, APPARENT EASEMENTS, ROADWAYS
AND VISIBLE ENCROACHMENTS, IF ANY

THIS SURVEY IS MADE FOR THE USE OF THE PRESENT
OWNERS OF THE PROPERTY, AND ALSO THOSE WHO
PURCHASE, MORTGAGE OR GUARANTEE TITLE THERETO
WITHIN ONE (1) YEAR FROM DATE HERETO.

JOHN P. KROTT, R.L.S. 2258

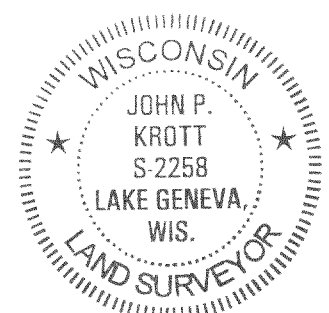

NOTE: THIS IS NOT A CERTIFIED COPY
UNLESS SEAL IS IN RED.
JOB NUMBER #98180 JLCB 888

JLCB-888

217-2759