

ABERNATHY and ASSOCIATES

Kenneth B. Abernathy Jr.

Wisconsin Registered Land Surveyor S-1594

W4056 BRAY RD.
ELKHORN, WI. 53121
PHONE: (262) 723-4260 (OFFICE)
(262) 723-7209 (FAX)
Email: abernathy@elknet.net


PLAT OF SURVEY

Legal Description

Lot 3 and Lot 4 of Block 2 of Hawthorne Hills Subdivision,
Located in part of the Northwest 1/4 and part of the
Southwest 1/4 of Section 26, Town 2 North, Range 17 East,
Town of Geneva, County of Walworth, State of Wisconsin.


Marshall Lane

66' Wide

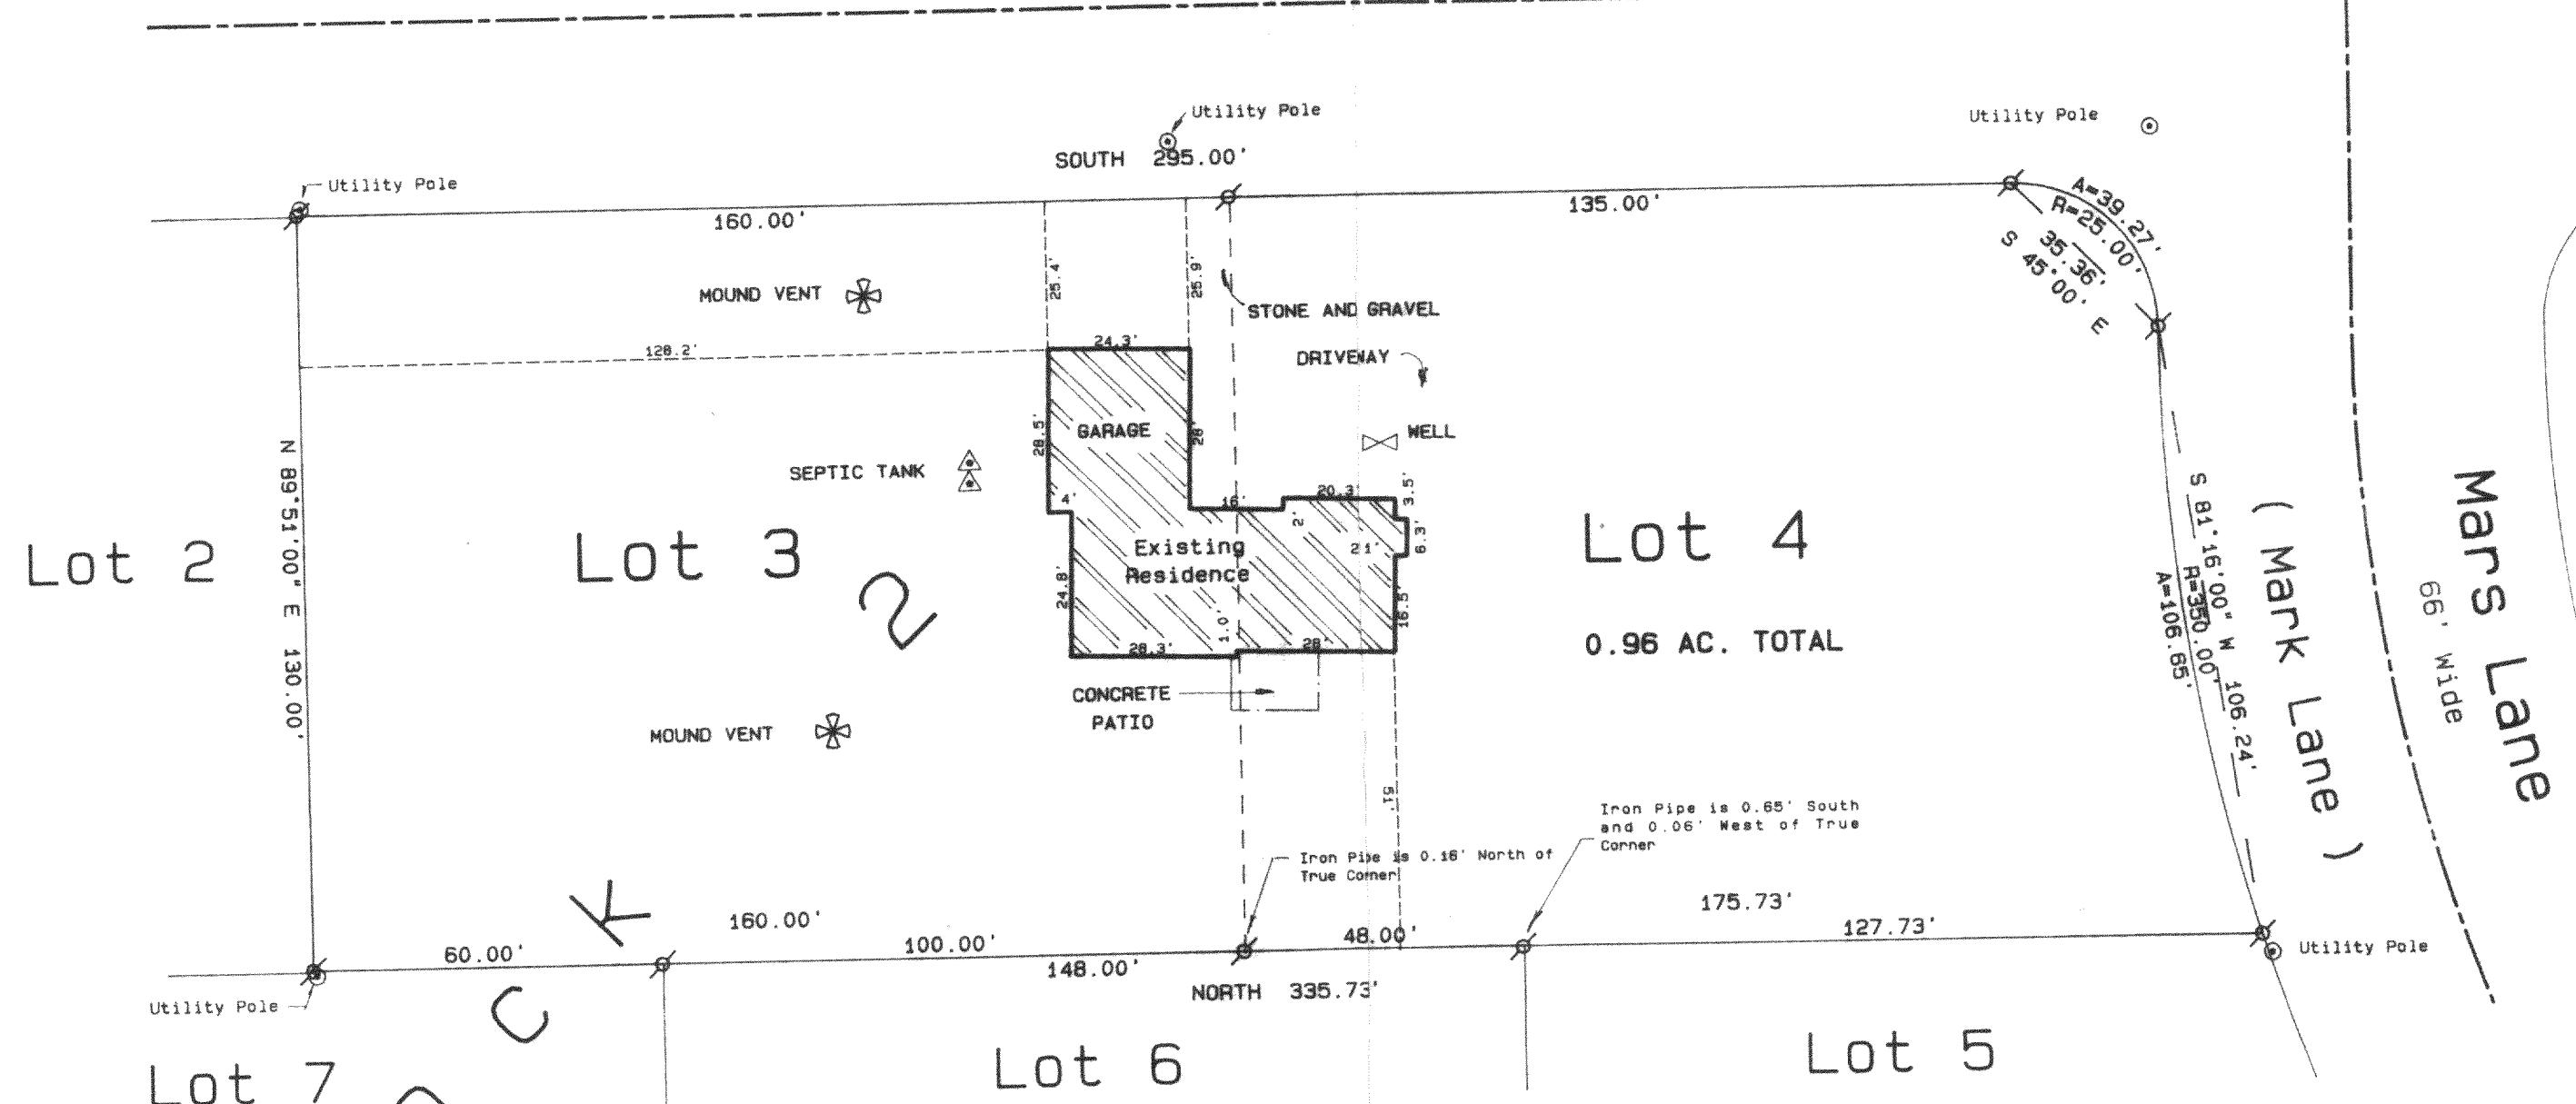

ORDERED BY: DONNA BAUMBACH
PRUDENTIAL SELECT PROPERTIES
623 MAIN STREET
LAKE GENEVA, WI 53147

REVISED 5/18/2004

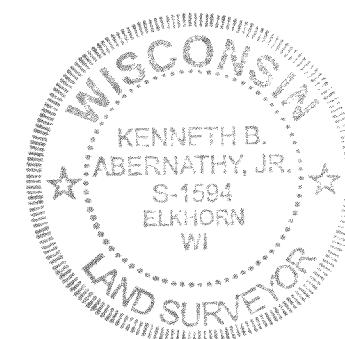

SCALE: 1"=30 FEET

I hereby certify that the above described property has been surveyed
by me or under my direction and that the above map is a true
representation thereof and shows the size and location of the property,
its exterior boundaries, the location of all visible structures and
dimensions of all principal buildings thereon, boundary fences, apparent
easements, roadways and visible encroachments, if any.
This survey is made for the use of the present owners of the property,
and also those who purchase, mortgage, or guarantee the title thereto
within one year from date hereof.

Kenneth B. Abernathy

KENNETH B. ABERNATHY, JR.
WISCONSIN REGISTERED LAND SURVEYOR,
S-1594

Date: MAY 6, 1993 Job No. 93-213

