

PREPARED FOR : JOHN SUHAJDA
W 3786 LOCUST DR.
LAKE GENEVA WI. 53147


PLAT OF SURVEY

- OF -


LOTS 4723-4725, 4736-4743, AND 4759-4763, BLOCK 83, LAKE COMO BEACH,
LOCATED IN SECTION 21, T2N, R17E, TOWN OF GENEVA, WALWORTH
COUNTY, WI.

DAHLIA DRIVE (40' WIDE ROAD)

J.K. SURVEYING INC.
N3705 WILLOWBEND LANE
LAKE GENEVA, WI, 53147
262-248-3697

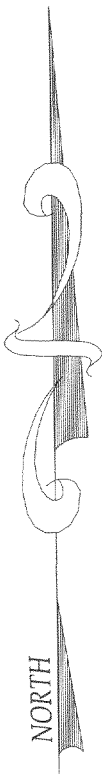

C.L. COMO ROAD (50' WIDE ROAD)

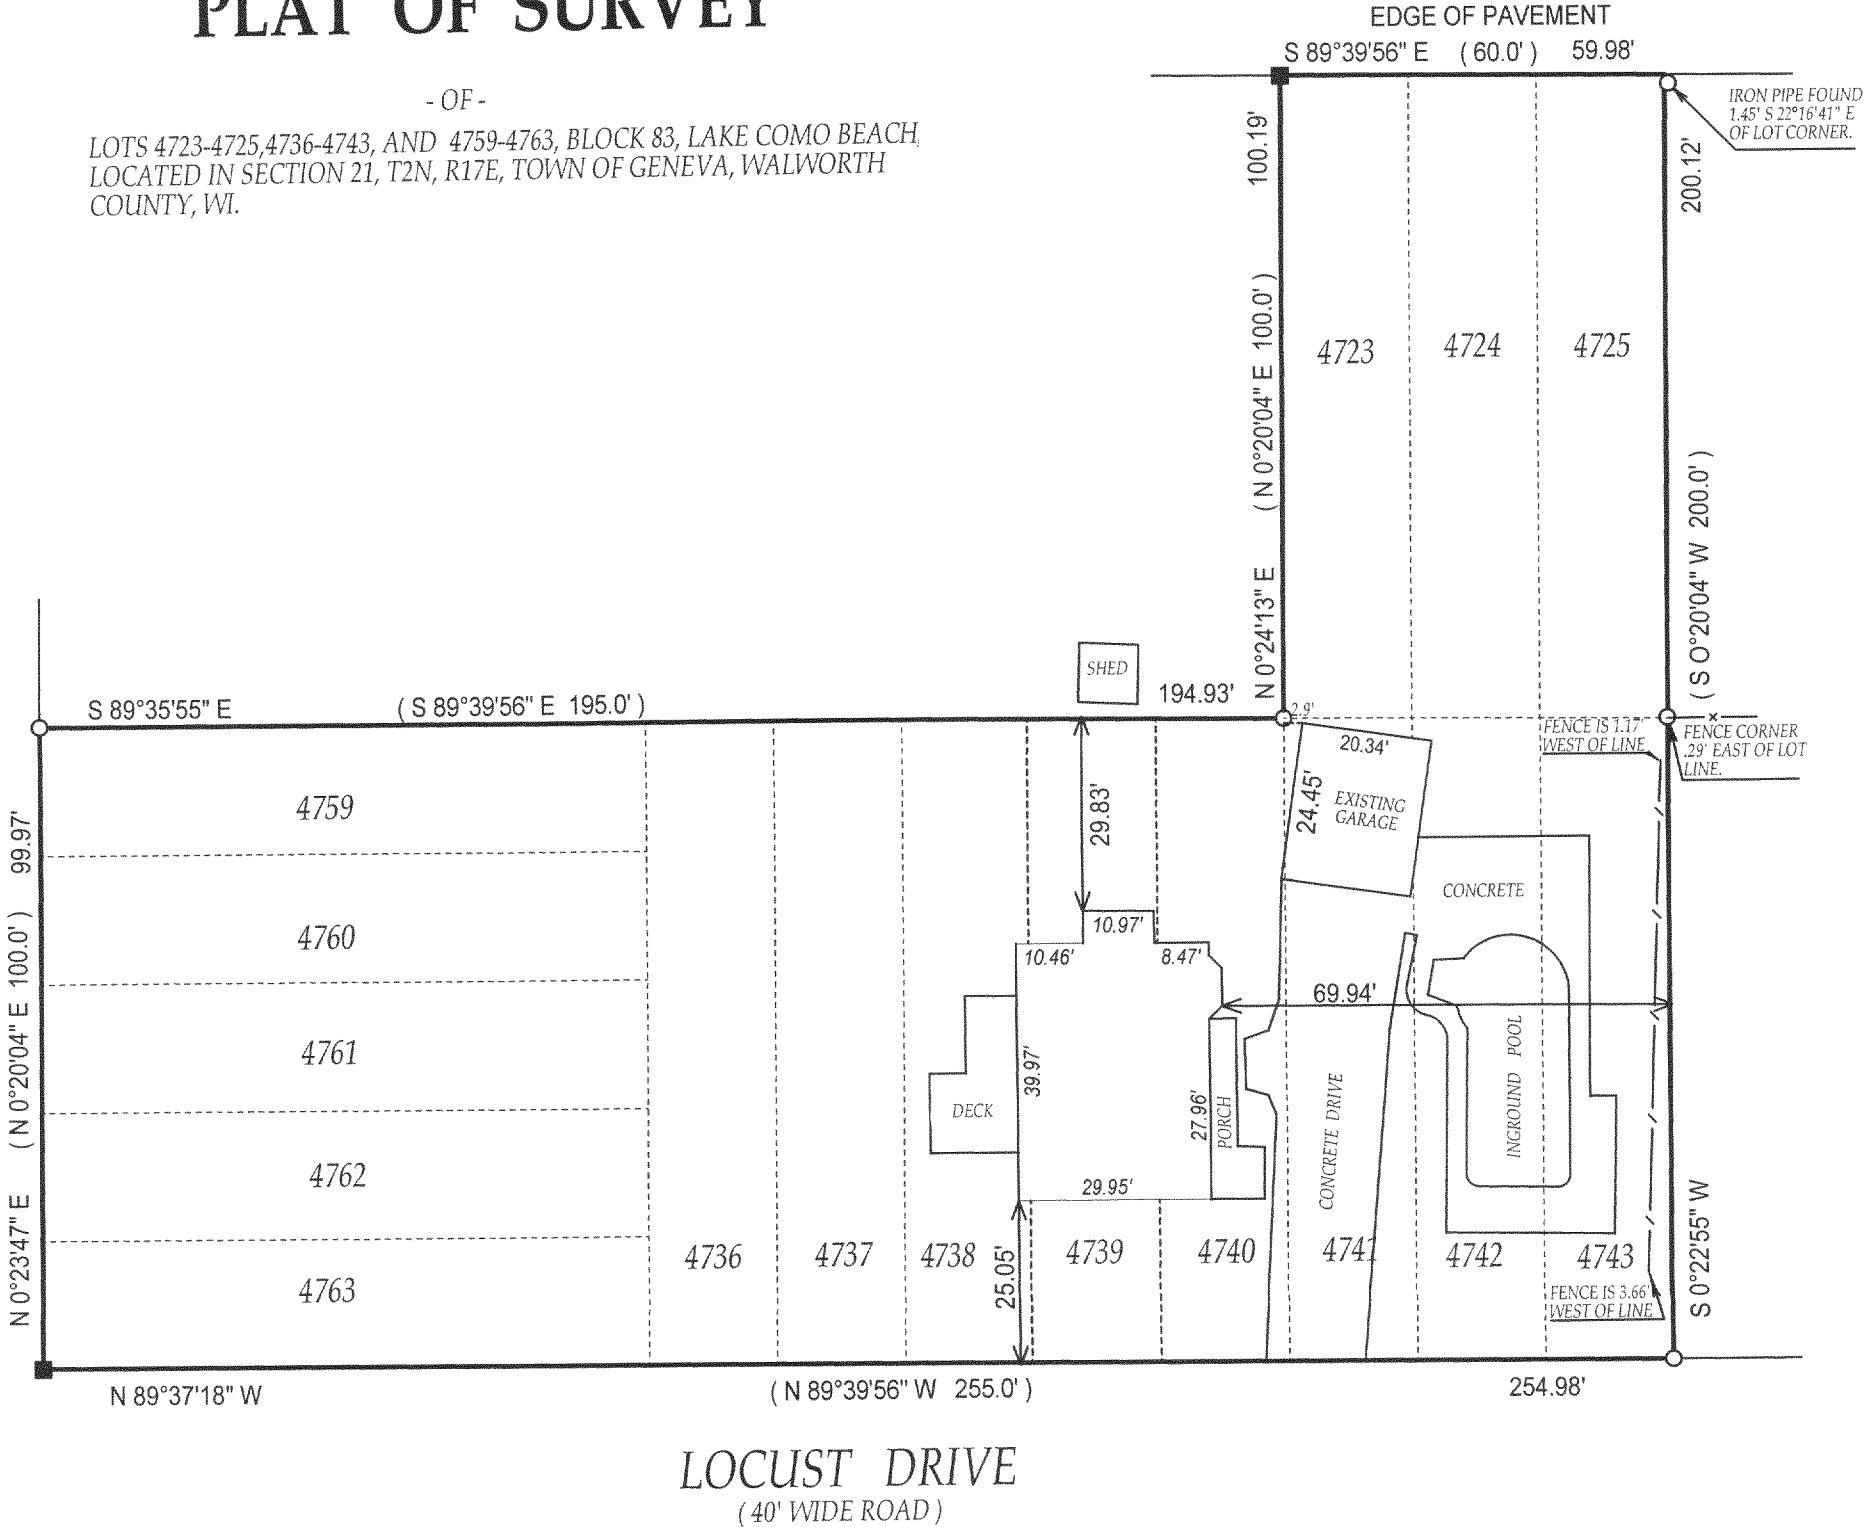

- () = recorded as
- = found iron bar
- = found iron pipe
- = set iron pipe
- = set iron bar

SCALE 1" = 30'



JOB # 03-184UPDATE

TAX ID # JLCB 00937

COMPARE LEGAL DESCRIPTION ABOVE AND DRAWING WITH DEED. FOR BUILDING RESTRICTIONS AND
EASEMENTS NOT SHOWN. REFER TO DEED, ABSTRACT SOURCES AND LOCAL MUNICIPAL CODES. NOTIFY
THE SURVEYOR IMMEDIATELY OF ANY DISCREPANCY.

"I hereby certify that I have surveyed the above described property and that
the above map is a true representation thereof and shows the size and
location of all visible structures, apparent easements and encroachments
if any."

This survey is made for the present owners of the property, and those who
purchase, mortgage, or guarantee the title thereto, within one year from
the date hereof. DATED THIS 25 TH, DAY OF APRIL 20 03.

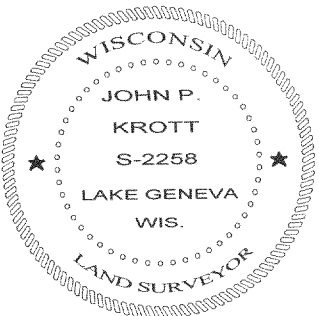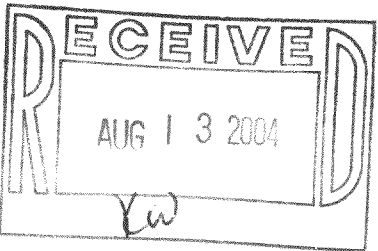

John P. Krott
JOHN KROTT S - 2258
Wisconsin Registered Land Surveyor
(original if signed in red)
REVISED 06/23/03
REVISED 09/11/03
DATE OF LAST REVISION 08/12/04

217-2863