


N

ROAD

FERN

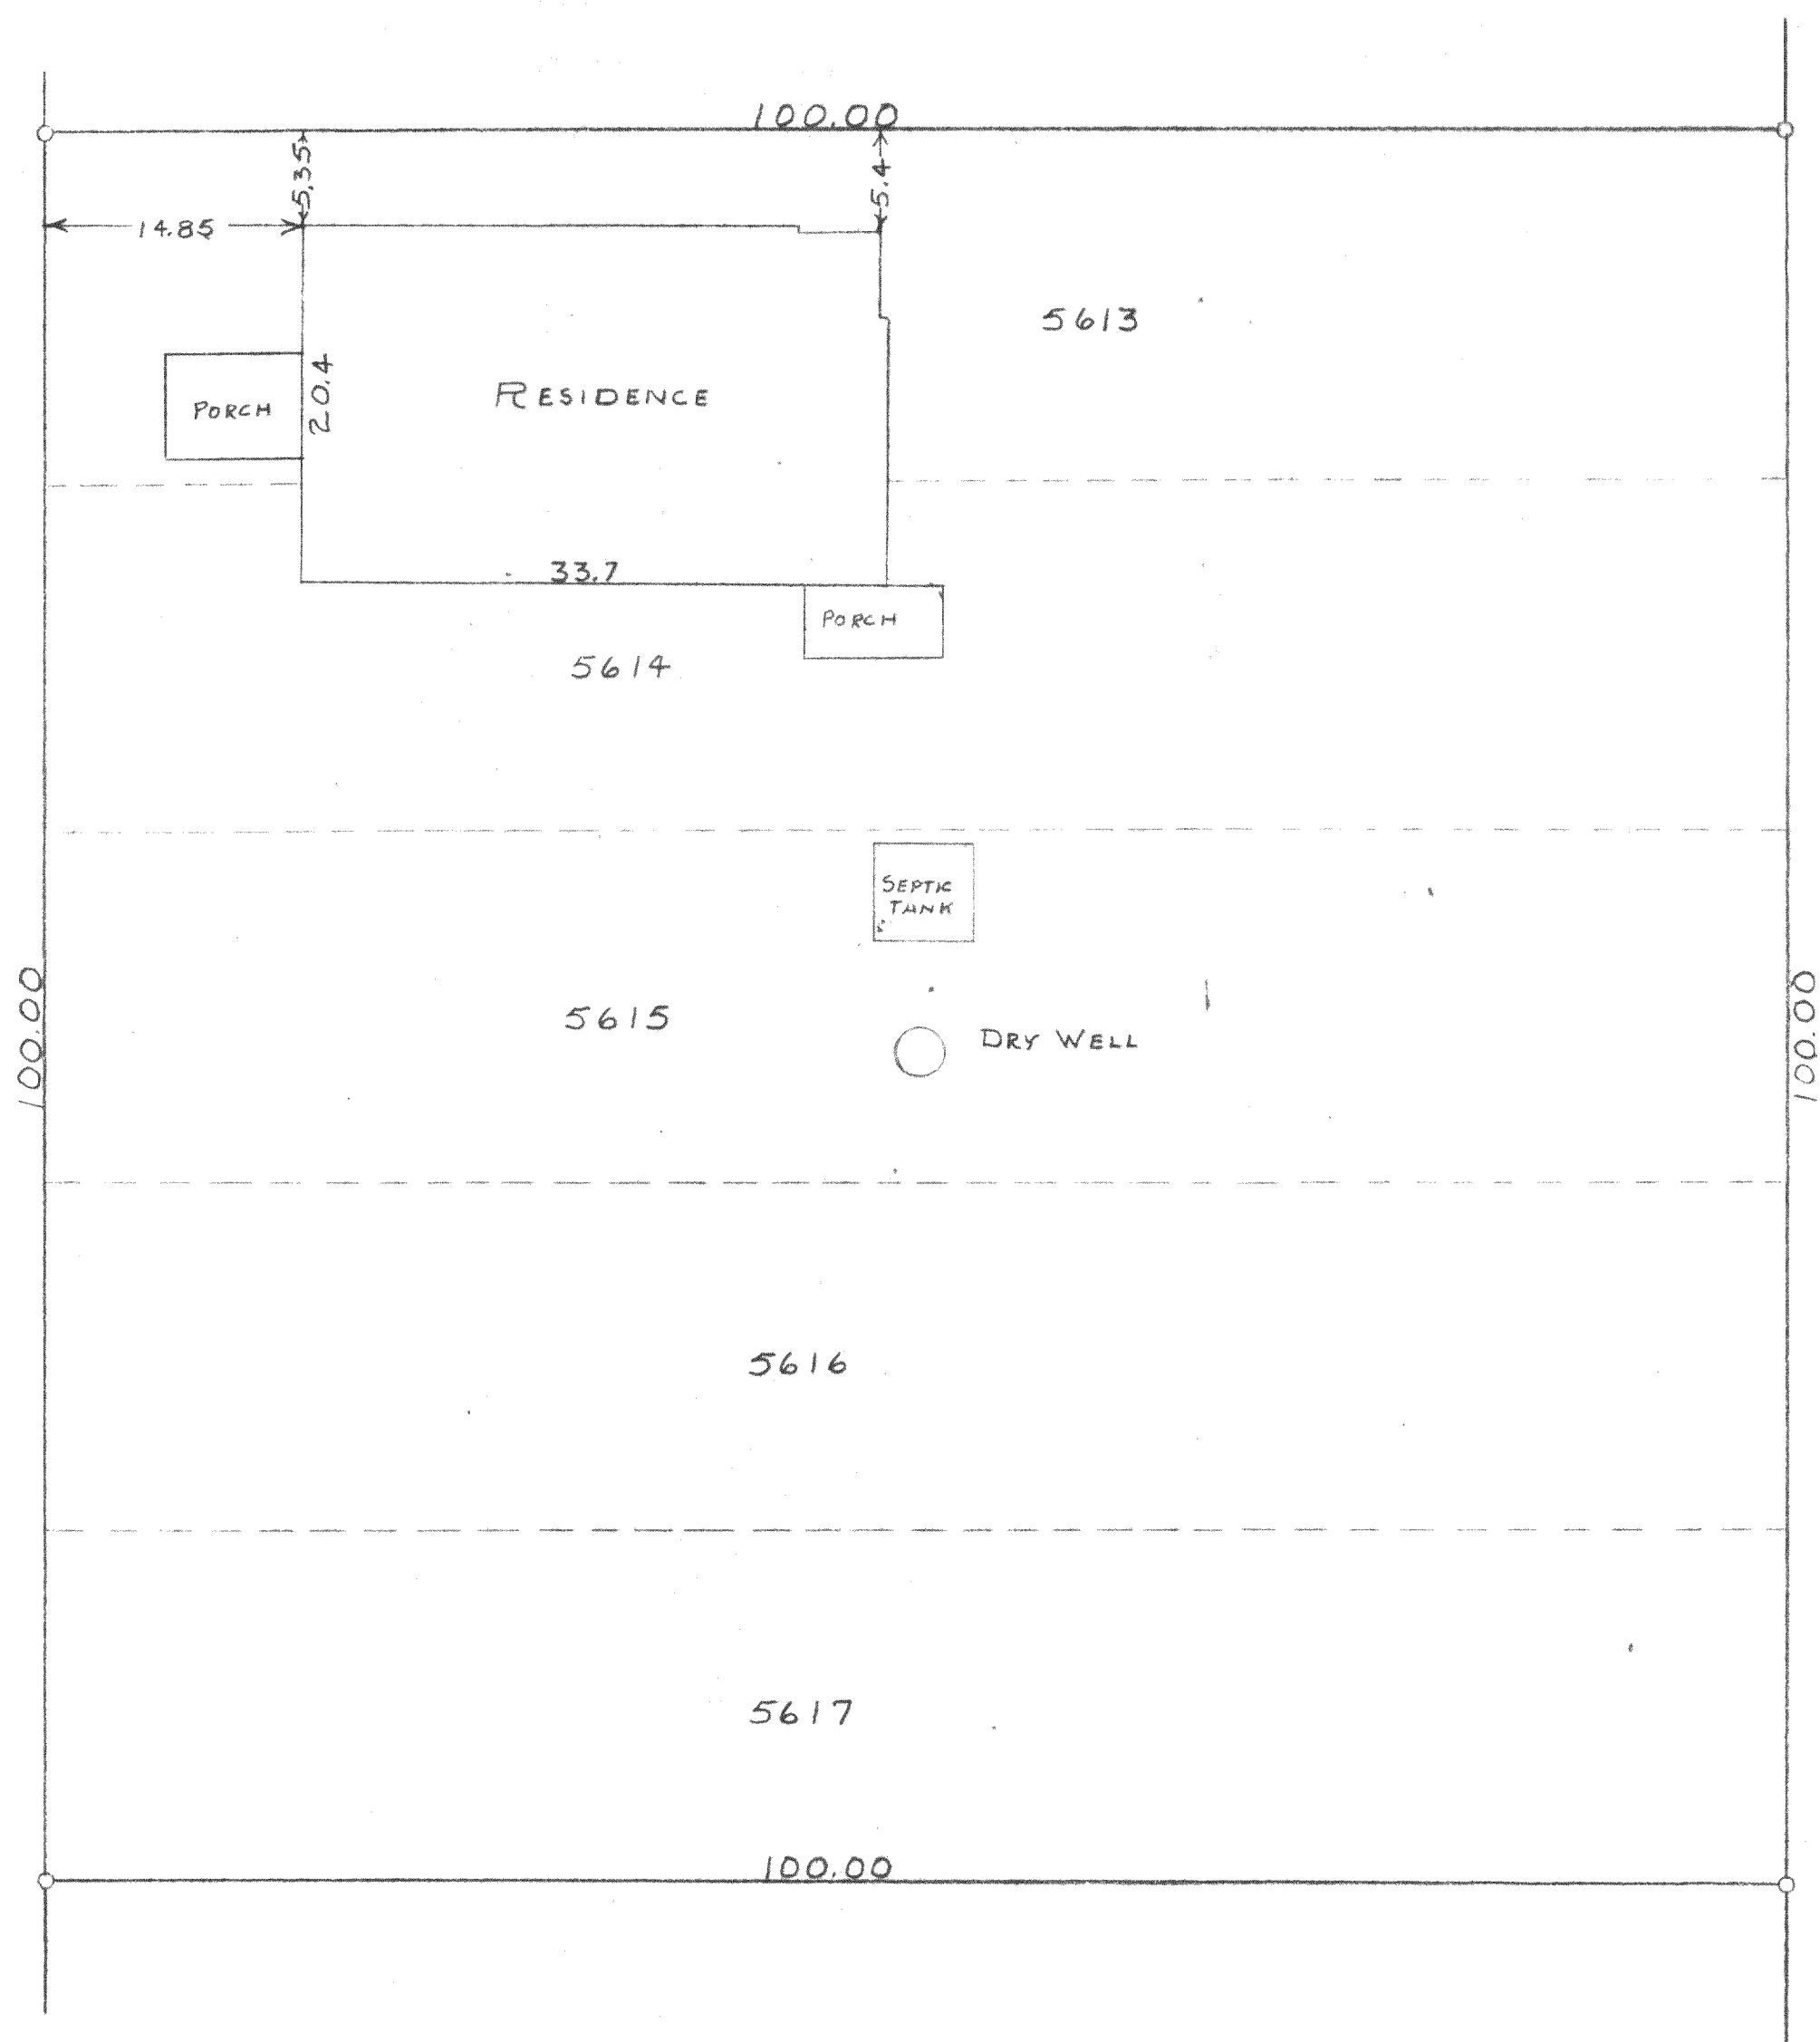

SCALE-1"=10'
O=IRON PIPE

PLAT OF SURVEY OF LOTS 5613-5617 INCLUSIVE OF LAKE COMD BEACH SUBDIVISIONS
LOCATED IN THE TOWN OF GENEVA, WALWORTH COUNTY, WISCONSIN.
OCT 13, 1958

George F. Dunham
GEORGE F. DUNHAM, SURVEYOR
DELAVER, WISCONSIN