




SCALE - 1" = 20'  
O = IRON PIPE

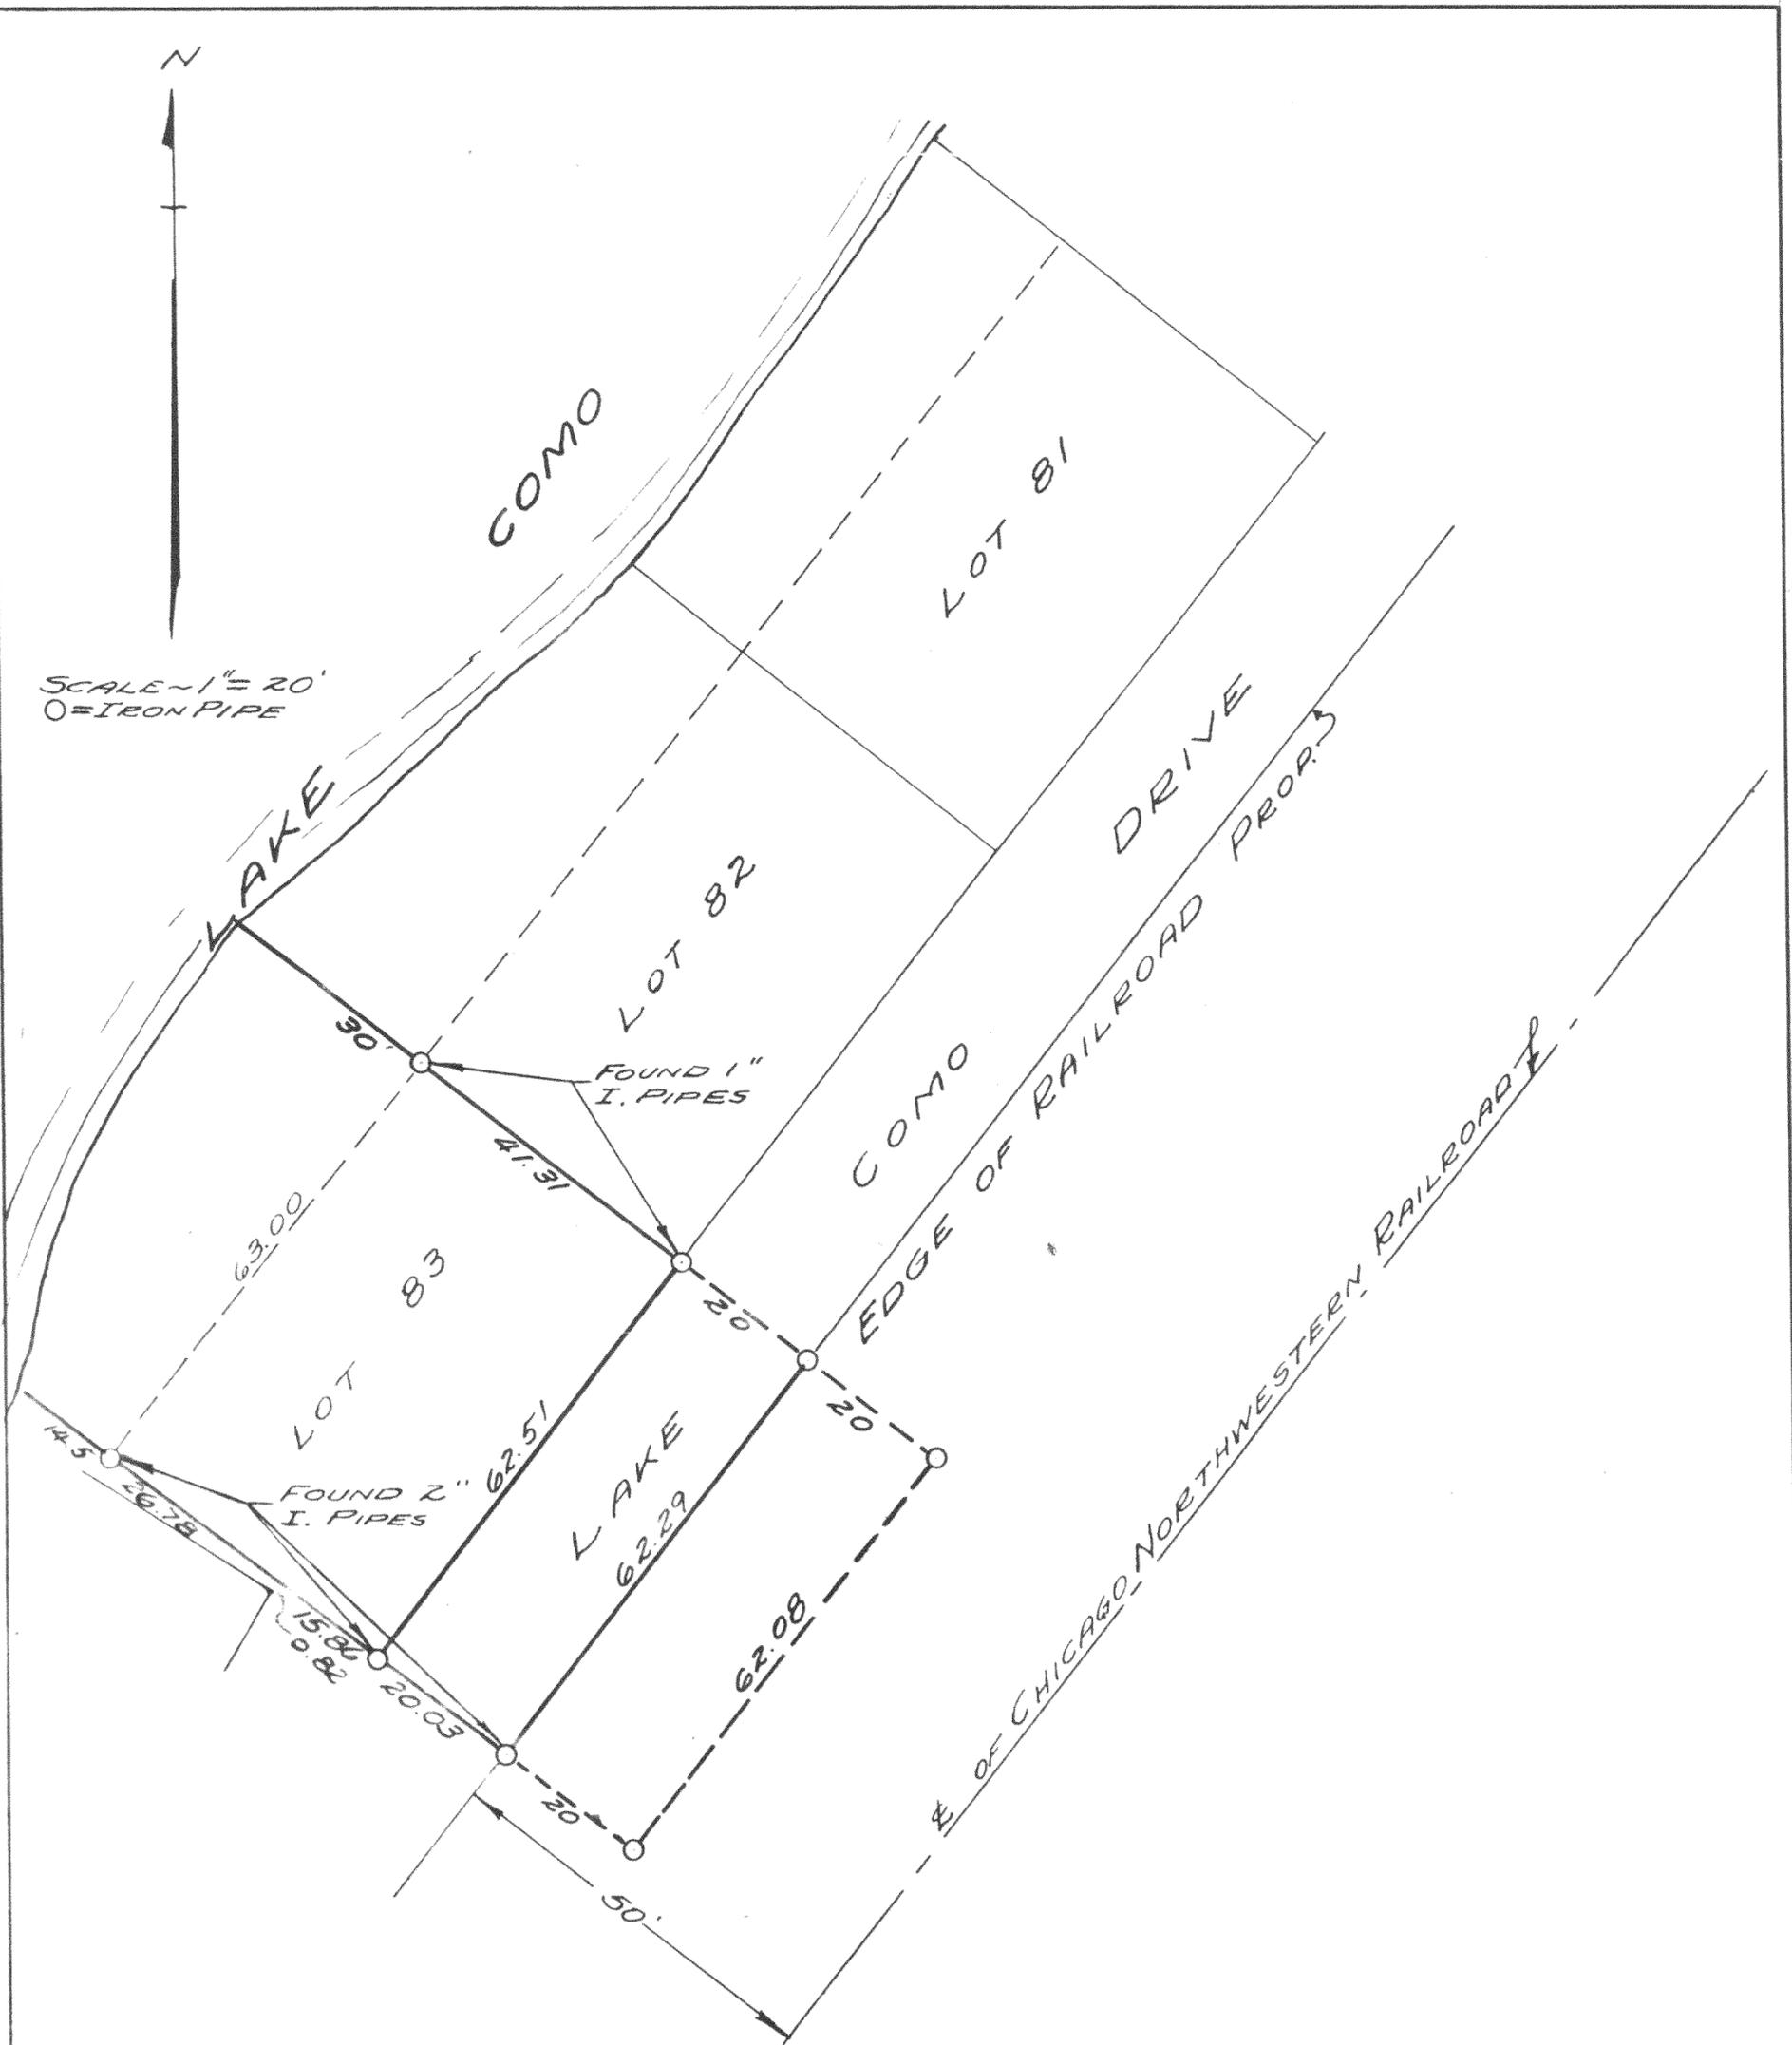

PLAT OF SURVEY OF LOT 83 OF THE CONSUMER'S COMPANY  
SUBDIVISION, T2N, R1E, WALWORTH COUNTY, WISCONSIN.

SEPT, 1946

*H. E. Johnson*  
SURVEYOR