


PLAT OF SURVEY

UNIT 20-19
GENEVA NATIONAL CONDOMINIUM
NO. 20

LOCATED IN TOWN 2 NORTH, RANGE 17 EAST
WALWORTH COUNTY, WISCONSIN

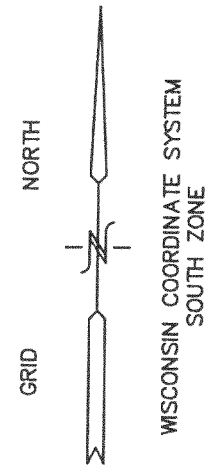

BENCH MARK
RIM SANITARY
MANHOLE
ELEV.=1010.79'
[IE=1002.89']

EXISTING
HYDRANT

EDGE OF
PAVEMENT

MASTERS ROAD
66' WIDE PRIVATE R.O.W.

SWITCH
VALVE BOX
SPRINKLER
N 03° 56' 25" W
A=63.36'
C=58.91'
R=55.00'

EXISTING RESIDENCE
F.F.=1016.1'

DECK

UNIT 20-20

UNIT 20-19
21,049 S.F.

EXISTING
RESIDENCE
G.E.=1012.8'
F.F.=1014.7'

50' GOLF CLUB GROUNDS SETBACK


EDGE OF CART PATH

GOLF CLUB GROUNDS

IE=1005.8'

EXTG. 8" PVC PIPE

IE=1005.2'

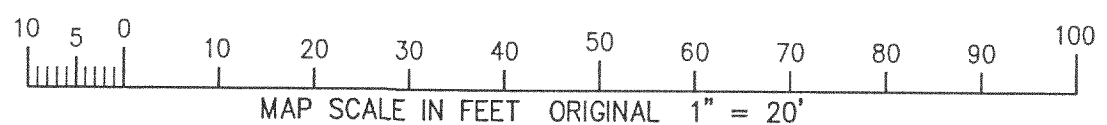

LEGEND


- = FOUND IRON REBAR STAKE
- (xxx) = RECORDED AS

NOTE: COPIES OF THIS MAP TO WHICH THE FOLLOWING CERTIFICATE WILL APPLY SHOW SURVEYOR'S ORIGINAL SEAL AND SIGNATURE IN RED INK. COPIES BY ANY OTHER MEANS MAY HAVE ALTERATIONS WHICH DO NOT REPRESENT THE SURVEYOR'S WORK PRODUCT.

I HEREBY CERTIFY THAT THE ABOVE DESCRIBED PROPERTY HAS BEEN SURVEYED UNDER MY DIRECTION AND THAT THE ABOVE MAP IS A TRUE REPRESENTATION THEREOF AND SHOWS THE SIZE AND LOCATION OF THE PROPERTY, ITS EXTERIOR BOUNDARIES, THE LOCATION OF ALL VISIBLE STRUCTURES, AND DIMENSIONS OF ALL PRINCIPLE BUILDINGS THEREON, BOUNDARY FENCES, APPARENT EASEMENTS, ROADWAYS, AND VISIBLE ENCROACHMENTS, IF ANY. THIS SURVEY IS MADE FOR THE USE OF THE PRESENT OWNERS OF THE PROPERTY, AND ALSO THOSE WHO PURCHASE, MORTGAGE, OR GUARANTEE THE TITLE THERETO WITHIN ONE YEAR FROM THE DATE HEREOF.

DATED: JUNE 17, 2004

Peter S. Gordon
PETER S. GORDON R.L.S. 2101

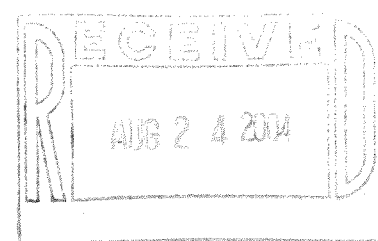

WORK ORDERED BY
JUDY LIDNER - RESORT REALTY
1201 SOUTH GENEVA NATIONAL AVENUE
LAKE GENEVA, WI 53147

FARRIS, HANSEN & ASSOCIATES, INC.
Engineering, Architecture, Surveying
7 Ridgway Court P.O. Box 437
ELKHORN, WISCONSIN 53121
Office: (262) 723-2098
Fax: (262) 723-5886

REVISIONS

PROJECT NO.
3269.20.19
DATE:
05-13-04
SHEET NO.
1 OF 1

JGN 2000019

217-2913