


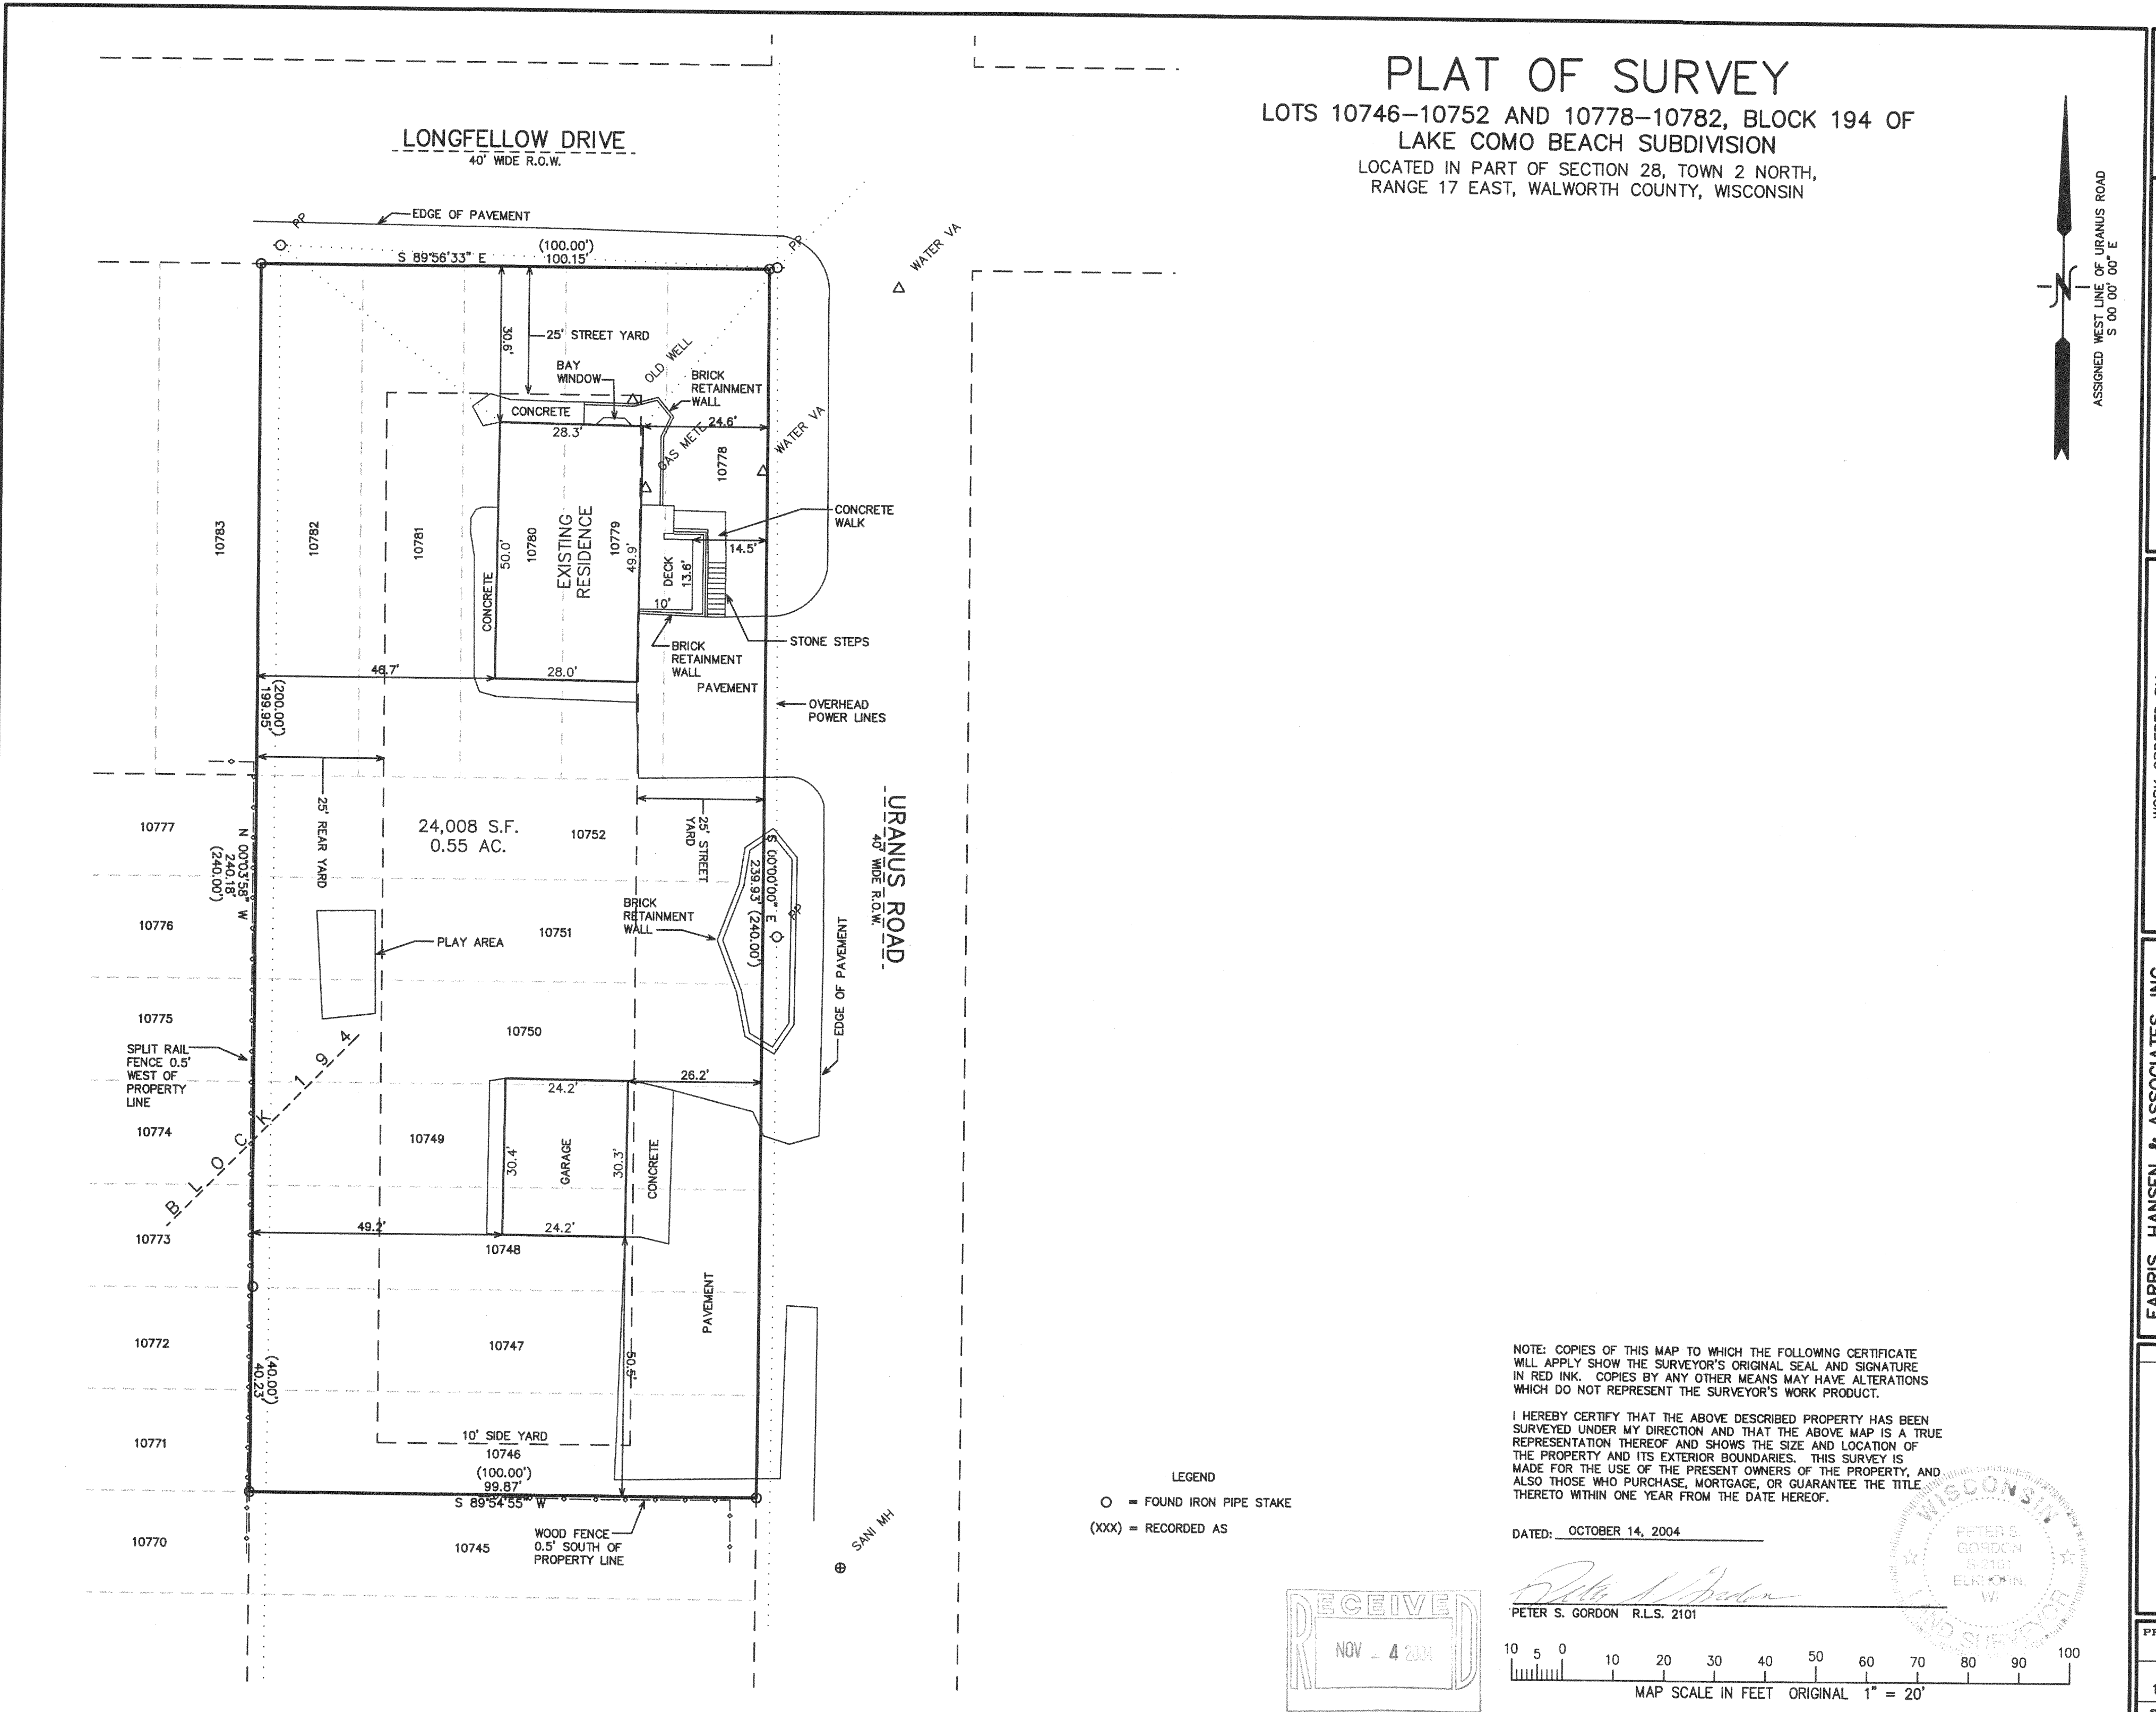

— WORK ORDERED BY —
MICHAEL & DENISE LYONS
505 MARANGO AVENUE
FOREST PARK, IL 60130

FARRIS, HANSEN & ASSOCIATES, INC.
ENGINEERING — ARCHITECTURE — SURVEYING
7 RIDGWAY COURT P.O. BOX 437
ELKHORN, WISCONSIN 53121
OFFICE: (262) 723-2098 FAX: (262) 723-5886

REVISIONS

PROJECT NO. 6655
DATE: 10/14/04
SHEET NO. 1 OF 1