


PLAT OF SURVEY

UNIT 3-57
GENEVA NATIONAL CONDOMINIUM
NO. 3

LOCATED IN TOWN 2 NORTH, RANGE 17 EAST
WALWORTH COUNTY, WISCONSIN

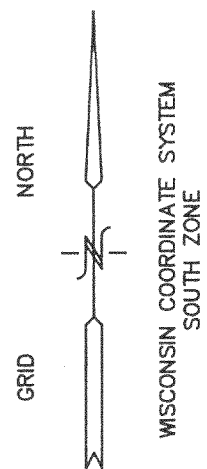

GENEVA NATIONAL CONDOMINIUM NO. 4

UNIT 3-56

UNIT 3-21

UNIT 3-20

UNIT 3-58

DRAINAGEWAY

SARATOGA LANE
66' PRIVATE ROADWAY


ZURICH DRIVE
66' PRIVATE ROADWAY

SANITARY SEWER
MANHOLE
NORTH RIM
ELEV: 1029.94
I.E.: 1015.08

BENCHMARK
X ON NORTH RIM
SANITARY SEWER
MANHOLE
ELEV: 1000.63
I.E.: 991.29

*NOTE: ELEVATIONS REFERENCED TO U.S.G.S.
VERTICAL DATUM, 1929 ADJUSTMENT

- LEGEND
- = FOUND IRON REBAR STAKE
 - = SET STEEL PIN W/CAP
 - (xxx) = RECORDED AS
 - ⊙ = STREET LIGHT POLE

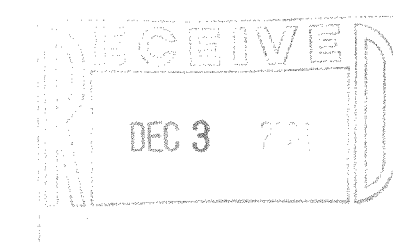

NOTE: COPIES OF THIS MAP TO WHICH THE FOLLOWING CERTIFICATE WILL APPLY SHOW SURVEYOR'S ORIGINAL SEAL AND SIGNATURE IN RED INK. COPIES BY ANY OTHER MEANS MAY HAVE ALTERATIONS WHICH DO NOT REPRESENT THE SURVEYOR'S WORK PRODUCT.

I HEREBY CERTIFY THAT THE ABOVE DESCRIBED PROPERTY HAS BEEN SURVEYED UNDER MY DIRECTION AND THAT THE ABOVE MAP IS A TRUE REPRESENTATION THEREOF AND SHOWS THE SIZE AND LOCATION OF THE PROPERTY, ITS EXTERIOR BOUNDARIES, THE LOCATION OF ALL VISIBLE STRUCTURES, AND DIMENSIONS OF ALL PRINCIPLE BUILDINGS THEREON, BOUNDARY FENCES, APPARENT EASEMENTS, ROADWAYS, AND VISIBLE ENCROACHMENTS, IF ANY. THIS SURVEY IS MADE FOR THE USE OF THE PRESENT OWNERS OF THE PROPERTY, AND ALSO THOSE WHO PURCHASE, MORTGAGE, OR GUARANTEE THE TITLE THERETO WITHIN ONE YEAR FROM THE DATE HEREOF.

DATED: NOVEMBER 30, 2004

PETER S. GORDON R.L.S. 2101

MAP SCALE IN FEET ORIGINAL 1" = 20'

MH SANITARY SEWER
MANHOLE
RIM ELEV: 980.37
I.E.: 962.57

WORK ORDERED BY
GN COMMUNITY ASSOCIATION
PO BOX 926
LAKE GENEVA, WI. 53147

FARRIS, HANSEN & ASSOCIATES, INC.
Engineering, Architecture, Surveying
7 Ridgway Court P.O. Box 437
ELKHORN, WISCONSIN 53121
Office: (414) 723-2098
Fax: (414) 723-5886

REVISIONS

PROJECT NO.
3269.3-57
DATE:
7/10/98
SHEET NO.
1 OF 1

JGN 30057

217-2953