


PLAT OF SURVEY

UNIT 16-32 OF GENEVA NATIONAL CONDOMINIUM NO. 16

LOCATED IN TOWN 2 NORTH, RANGE 17 EAST, WALWORTH COUNTY, WISCONSIN

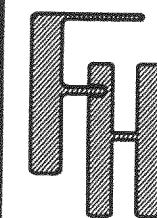


SITE, GRADING, DRAINAGE,
& EROSION CONTROL PLAN

WORK ORDERED BY -
COLDWELL BANKER - PRIMUS
226 BROAD STREET
LAKE GENEVA, WI. 53147


FARRIS, HANSEN & ASSOCIATES, INC.
Engineering, Architecture, Surveying
7 Ridgway Court P.O. Box 437
ELKHORN, WISCONSIN 53121
Office: (262) 723-2098
Fax: (262) 723-5886

REVISIONS
6/13/02 - LK
REVISED
LAYOUT

PROJECT NO.
3269.16-32
DATE:
05/09/2002
SHEET NO.
1 OF 1

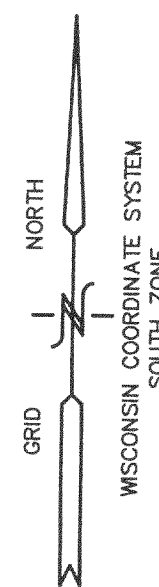

- LEGEND
- = FOUND IRON REBAR STAKE
 - ⊕ = SANITARY MANHOLE LOCATED
 - (XXX) = RECORDED AS

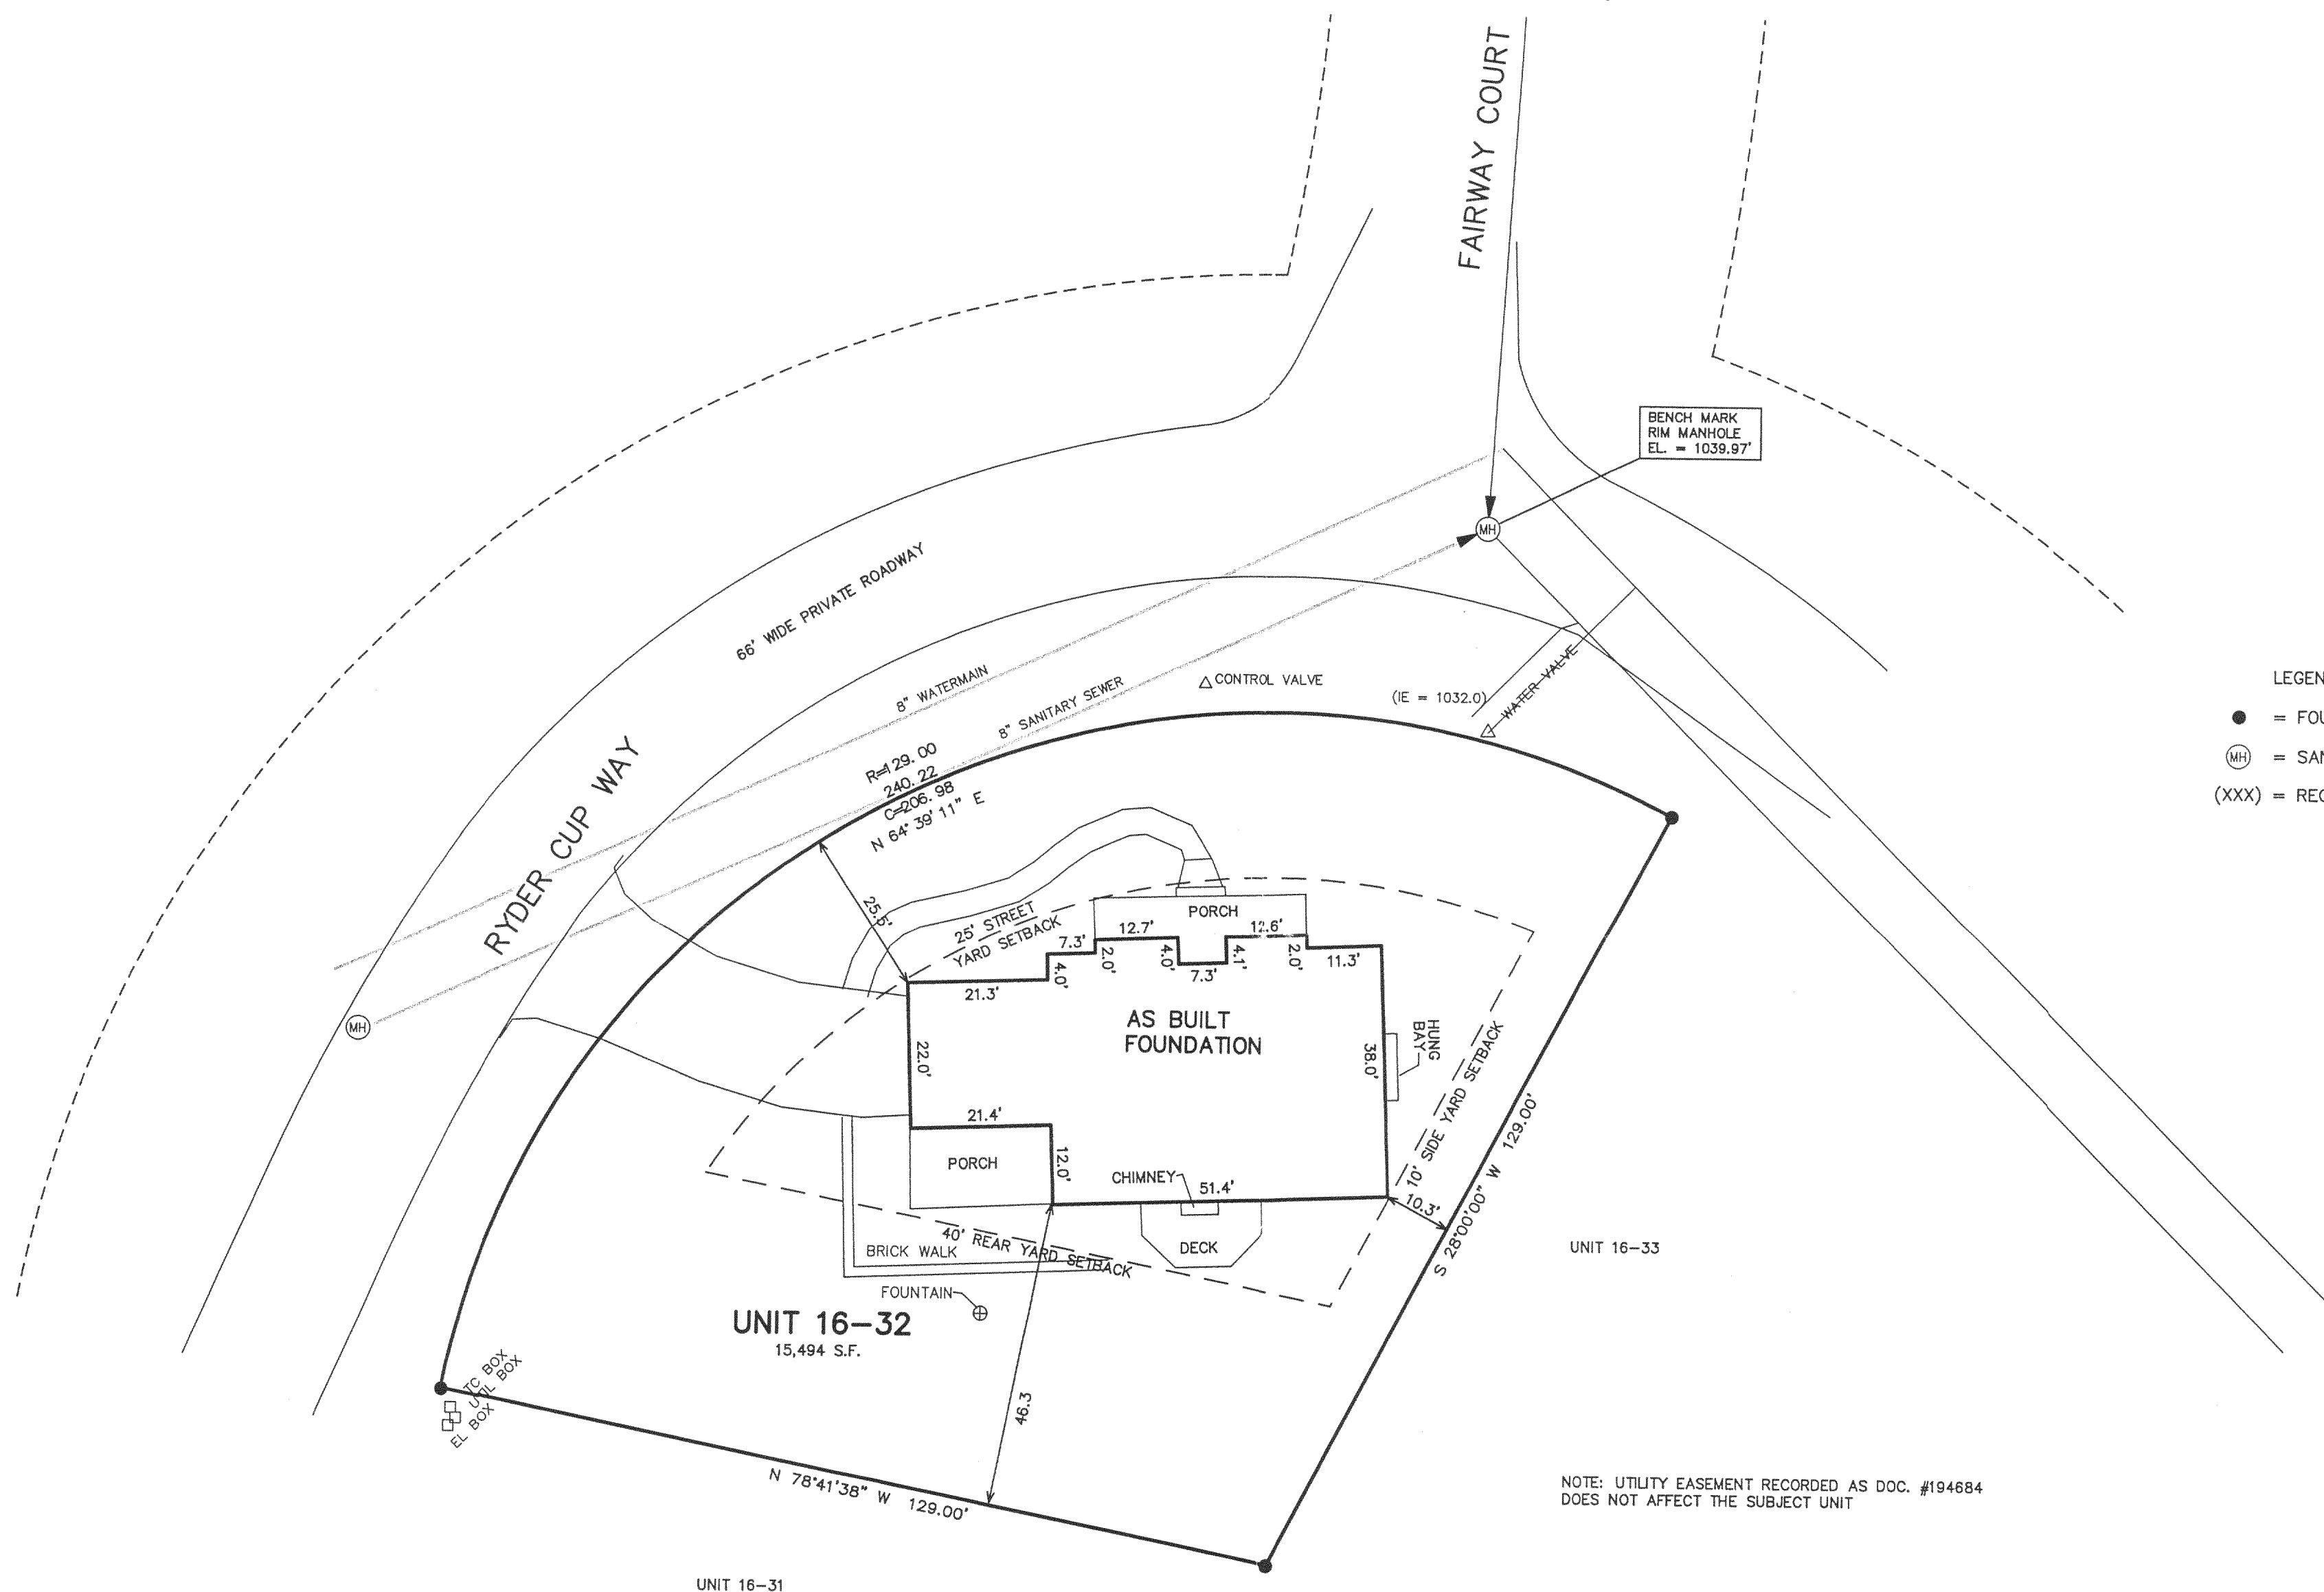




NOTE: UTILITY EASEMENT RECORDED AS DOC. #194684
DOES NOT AFFECT THE SUBJECT UNIT

NOTE: COPIES OF THIS MAP TO WHICH THE FOLLOWING CERTIFICATE WILL APPLY SHOW SURVEYOR'S ORIGINAL SEAL AND SIGNATURE IN RED INK. COPIES BY ANY OTHER MEANS MAY HAVE ALTERATIONS WHICH DO NOT REPRESENT THE SURVEYOR'S WORK PRODUCT.

I HEREBY CERTIFY THAT THE ABOVE DESCRIBED PROPERTY HAS BEEN SURVEYED UNDER MY DIRECTION AND THAT THE ABOVE MAP IS A TRUE REPRESENTATION THEREOF AND SHOWS THE SIZE AND LOCATION OF THE PROPERTY, ITS EXTERIOR BOUNDARIES, THE LOCATION OF ALL VISIBLE STRUCTURES, AND DIMENSIONS OF ALL PRINCIPLE BUILDINGS THEREON, BOUNDARY FENCES, APPARENT EASEMENTS, ROADWAYS, AND VISIBLE ENCROACHMENTS, IF ANY. THIS SURVEY IS MADE FOR THE USE OF THE PRESENT OWNERS OF THE PROPERTY, AND ALSO THOSE WHO PURCHASE, MORTGAGE, OR GUARANTEE THE TITLE THERETO WITHIN ONE YEAR FROM THE DATE HEREOF.

DATED: OCTOBER 21, 2004

PETER S. GORDON R.L.S. 2101

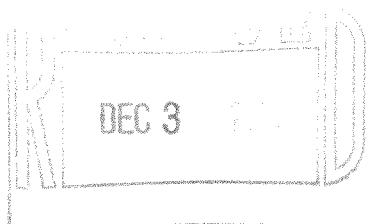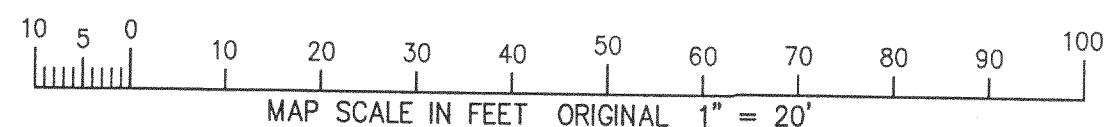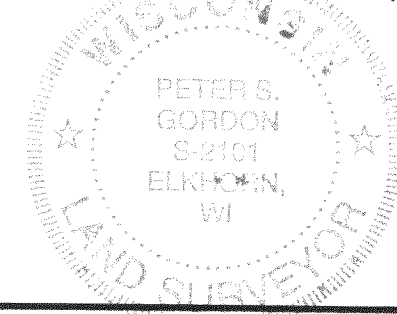

OCT 25 2004

JGN 1600032

217-2963