

Wisconsin Registered Land Surveyor S-2582


**N9330 Knuteson Drive
Whitewater, WI 53190
Phone: (262) 495-3284
FAX : (262) 495-8421
LAND-MARKSURVEYING.COM**

**LOTS 10073 THROUGH 10077 OF
BLOCK 184 OF LAKE COMO BEACH**

A subdivision located in the Southwest 1/4 of Section 28, Town 2 North, Range 17 East, Town of Geneva, Walworth County, Wisconsin.

**Ordered by: Schauder Building, Inc.
4115 North U.S. Highway 51
Janesville, Wi. 53545-9674**

Owners: Fred and Bernice Lucille Atterbury

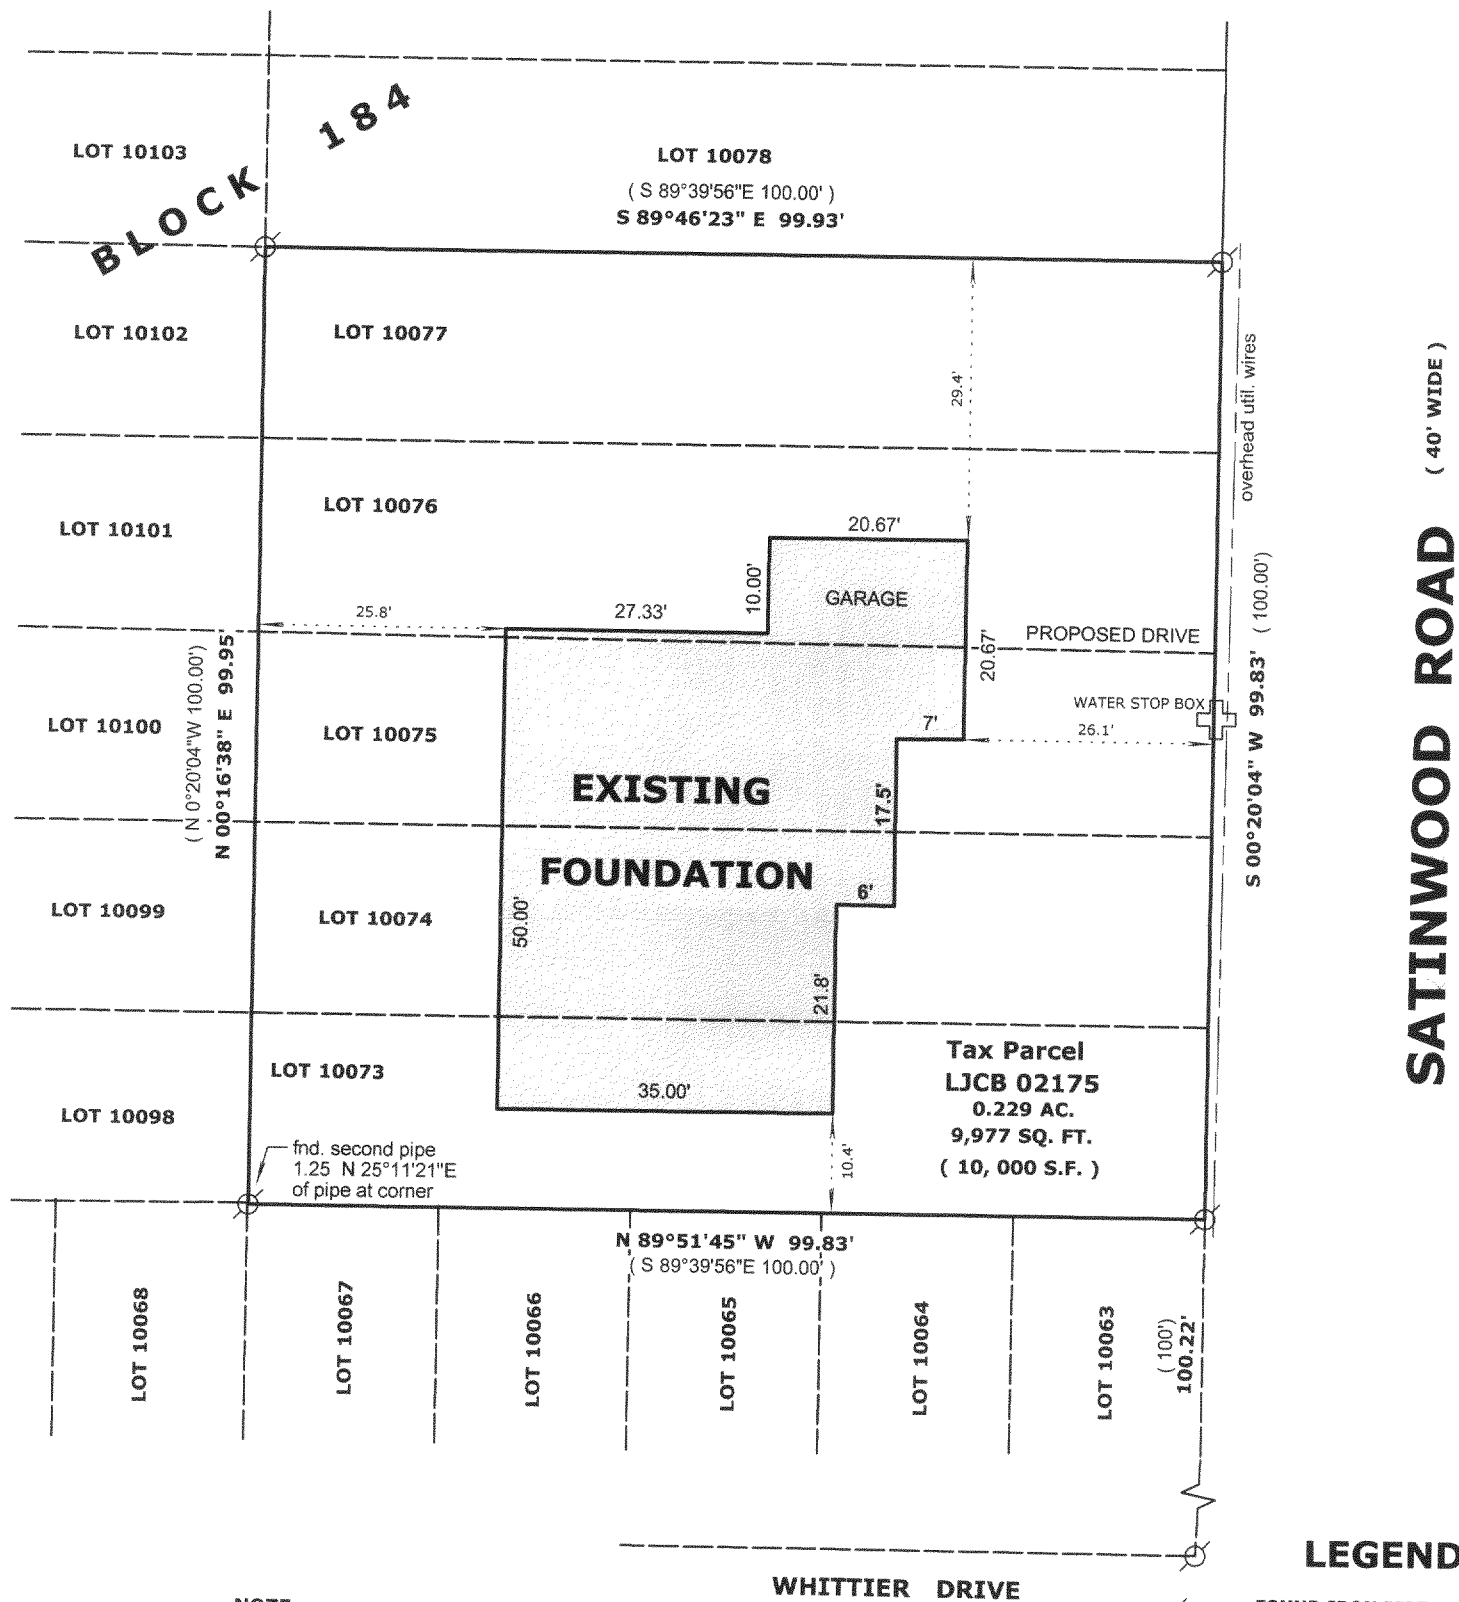

FOUND IRON PIPE
FOUND IRON ROD
10' OFFSET STAKE
FOUND CONCRETE MONUMENT
CHISEL CUT IN CONCRETE
SET IRON ROD, 24" LONG, WEIGHING
1.5 LBS./LINEAL FT., 3/4" DIA.
RECORDED AS DIMENSION
EXISTING FENCE

SCALE: 1" = 20 FEET

"I hereby certify that the above described property has been surveyed by me or under my direction and that the above map is a true representation thereof and shows the size and location of the property, its exterior boundaries, the location of all visible structures and dimensions of all principal buildings thereon, boundary fences, apparent easements, roadways and visible encroachments, if any."


"This survey is made for the use of the present owners of the property, and also those who purchase, mortgage, or guarantee the title thereto within one year from date hereof."

Mark L. Miritz
 MARK L. MIRITZ
 WISCONSIN REGISTERED
 LAND SURVEYOR S-2582

DATE: OCT. 5, 2004 JOB NO. 04.1005

NOTE:

1) This survey retraces a previous plat of survey prepared by Doug Olson, RLS 2093, dated July 29, 2004 as Job no. 2004.117, a copy of which was supplied by the owner to assist in the preparation of this plat.

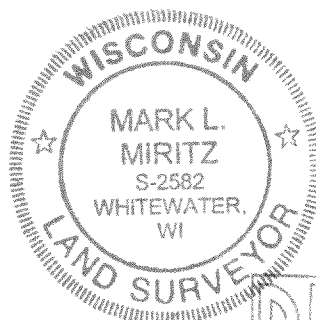

RECEIVED
JAN - 6

JLCB-a175

REVISED NOV. 19, 2004 TO SHOW FOUNDATION AS BUILT

217-2971