

Plat of Survey



of

Lots 10,222 through 10,231 of Block 186 of Lake Como Beach,
a subdivision located in the Northwest 1/4 of Section 28, Town 2 North,
Range 17 East, Town of Geneva, Walworth County, Wisconsin.

Surveyed for:

Century 21 Affiliated

50 West Geneva Street * P.O. Box 367
Williams Bay, Wisconsin. 53191

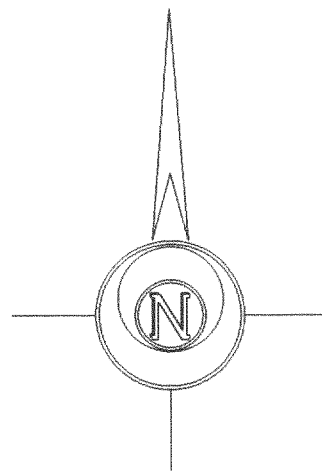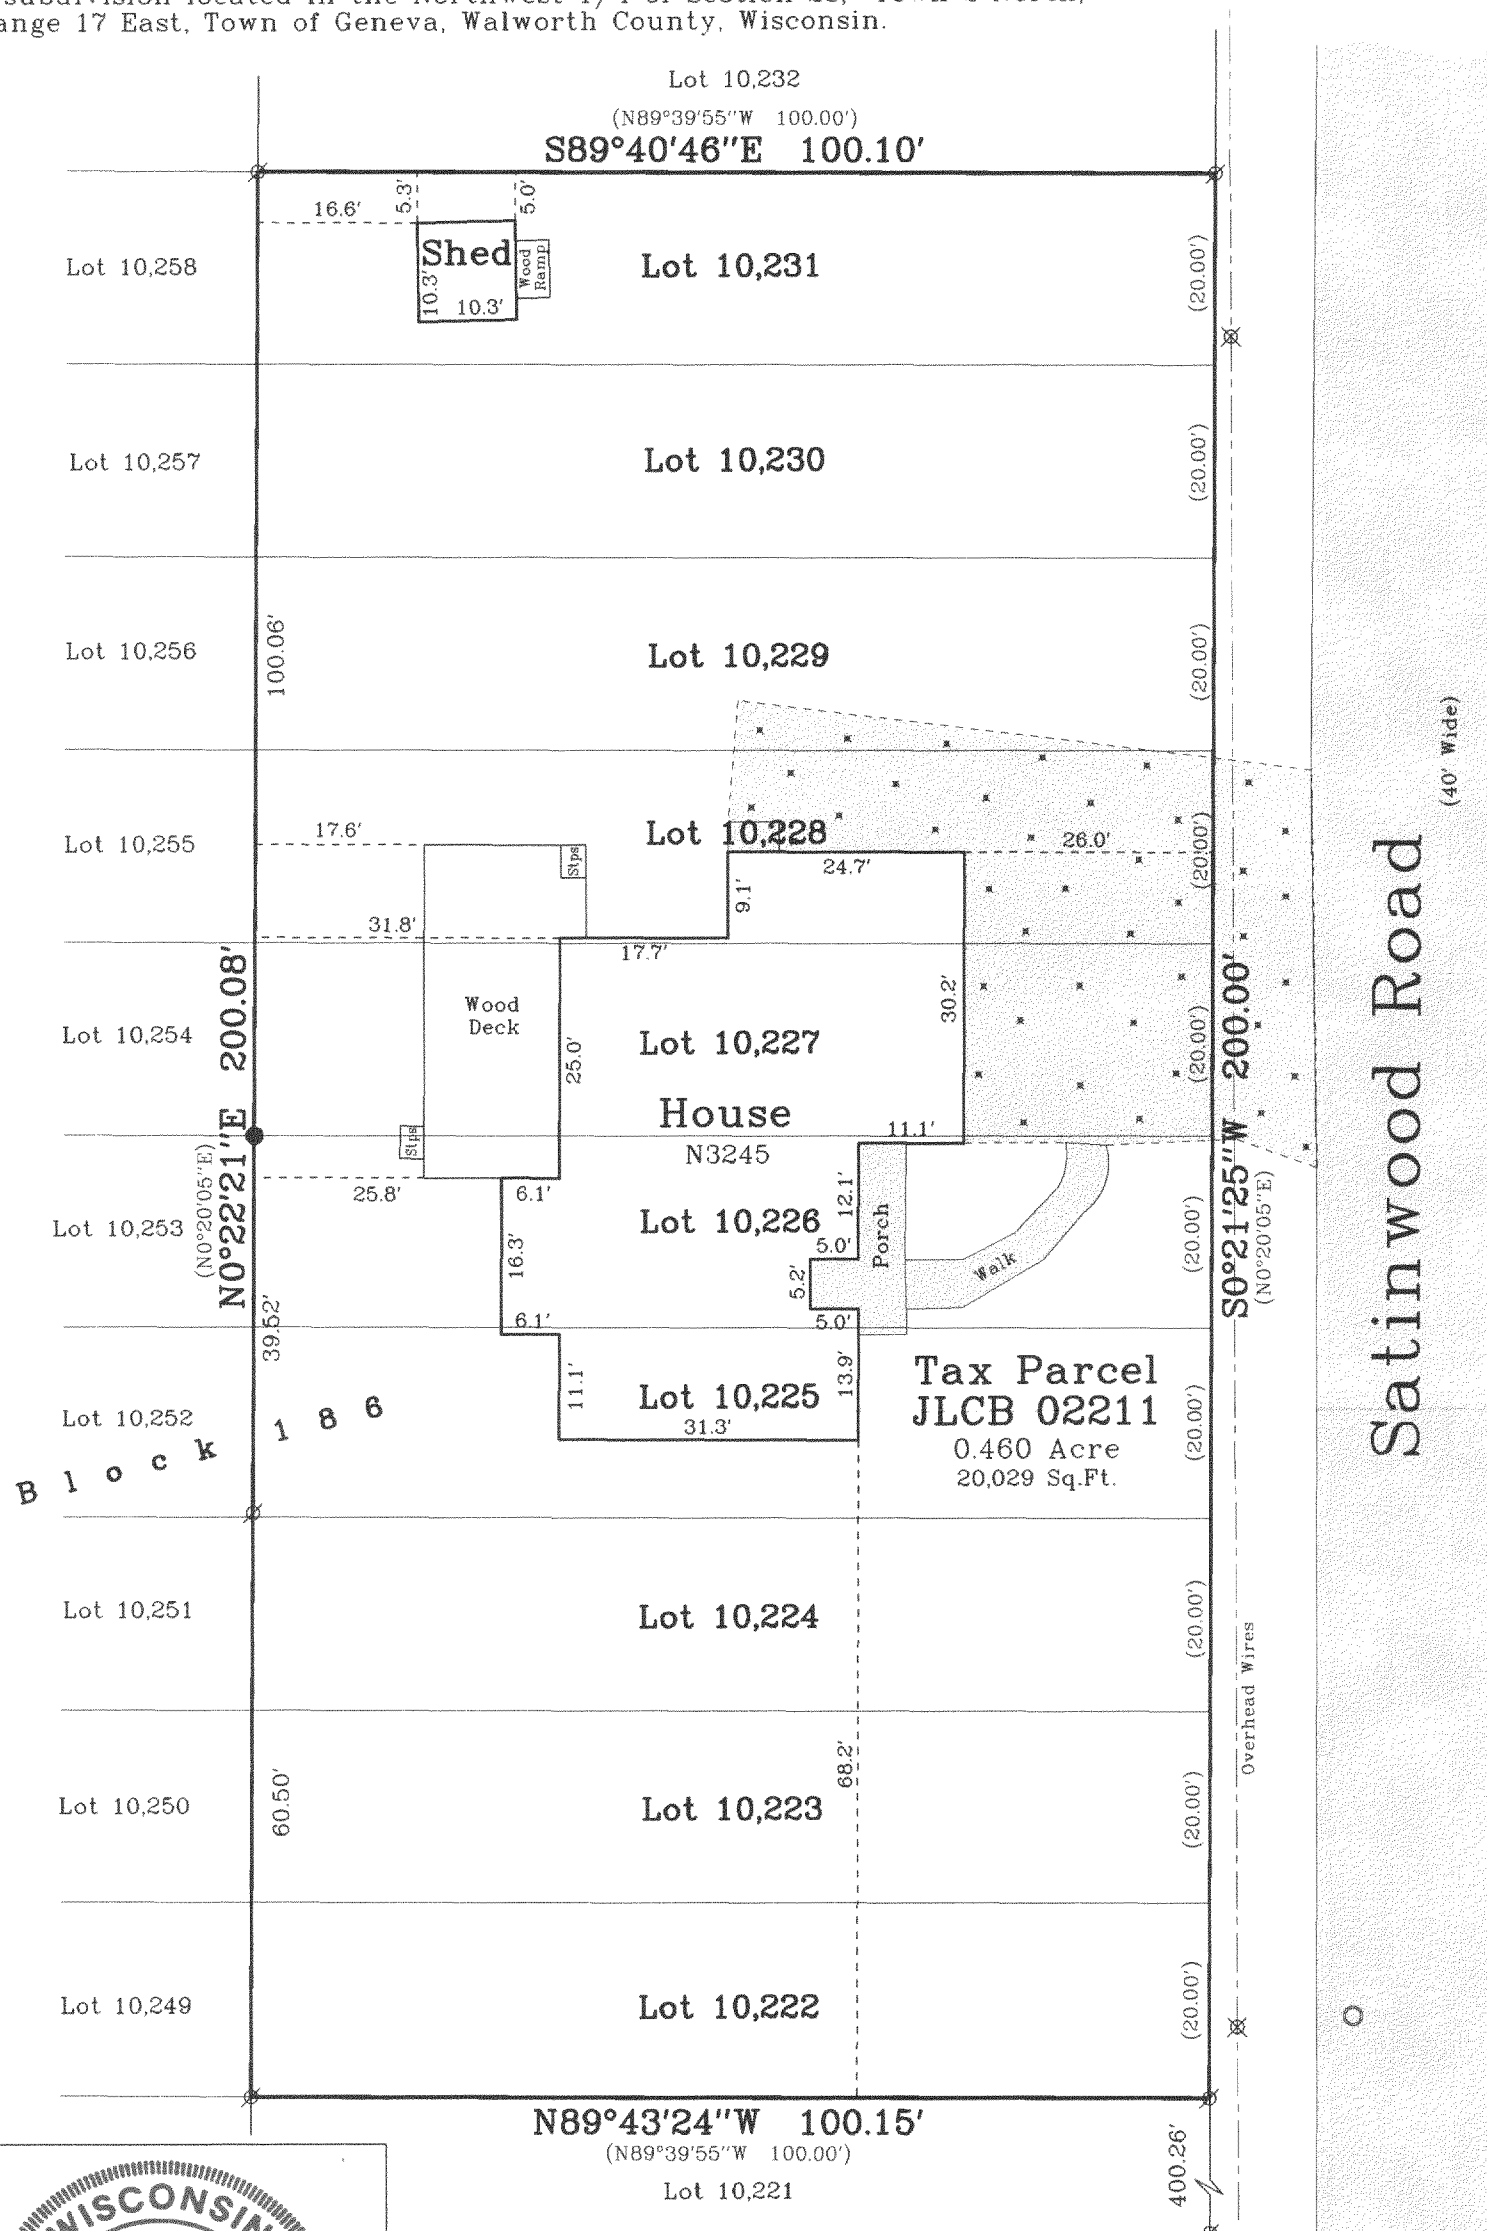


Bearings referenced to
the Subdivision Plat.

Note:

The location of paved or gravel
surfaces shown on this plat are
approximate due to existing
snow cover on the property at
the time of the field survey.

There may be additional im-
provements or encroachments
on the property which were
not visible at the time of the
field survey and are not shown
on this plat.

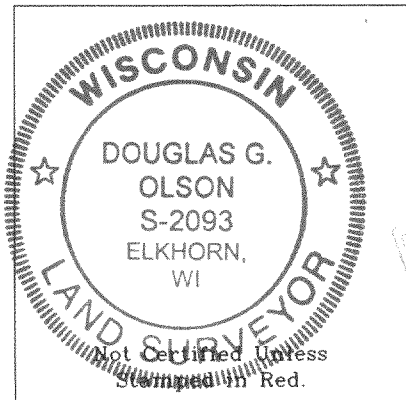

Notes:

- 1) This survey plat is not certified unless signed and sealed in red ink.
- 2) This survey is subject to Wisconsin lien laws. This Plat of Survey is the notice of intent to file lien. Lien waiver required.

Copyright c 2004 by Jensen & Olson Land Surveying, LLC.

All rights reserved. No part of this survey plat may be reproduced or transmitted in any form by any means - graphic, electronic, or mechanical, including photocopying, tracing, or information storage and retrieval systems - without permission in writing from Douglas G. Olson, Jensen & Olson Land Surveying, LLC.

I hereby certify that I have surveyed the above described property and the map hereon is correct to the best of my professional knowledge and belief and shows the size and location of the property, its exterior boundaries, the location and dimensions of all visible structures thereon, boundary fences, apparent easements and roadways and visible encroachments, if any.

This survey is made for the exclusive use of the present owners of property, and also those who purchase, mortgage or guarantee title thereto, within one year from the date hereof.

Douglas G. Olson
Wisconsin Registered Land Surveyor - 2093

Legend

- Ø Found Iron Pipe
- Found Iron Rod
- () Recorded Information
- ⊗ Utility Pole
- Manhole
- Asphalt Surface
- Concrete Surface
- Gravel Surface

Jensen & Olson Land Surveying, LLC

45 South Wisconsin Street P.O. Box 322
Elkhorn, Wisconsin. 53121
Telephone: (262) 723-3434
Facsimile: (262) 723-8044

Scale: 1" = 20'



Survey date: December 3, 2004.

Revisions:

Sheet 1 of 1 Sheets.

Job Reference Number:

2004.196 217-2993