


GEORGE T. DUNHAM
SURVEYING & SUBDIVIDING
DELAVER, WISCONSIN

N

Scale - 1" = 20'
○ = Iron Pipe

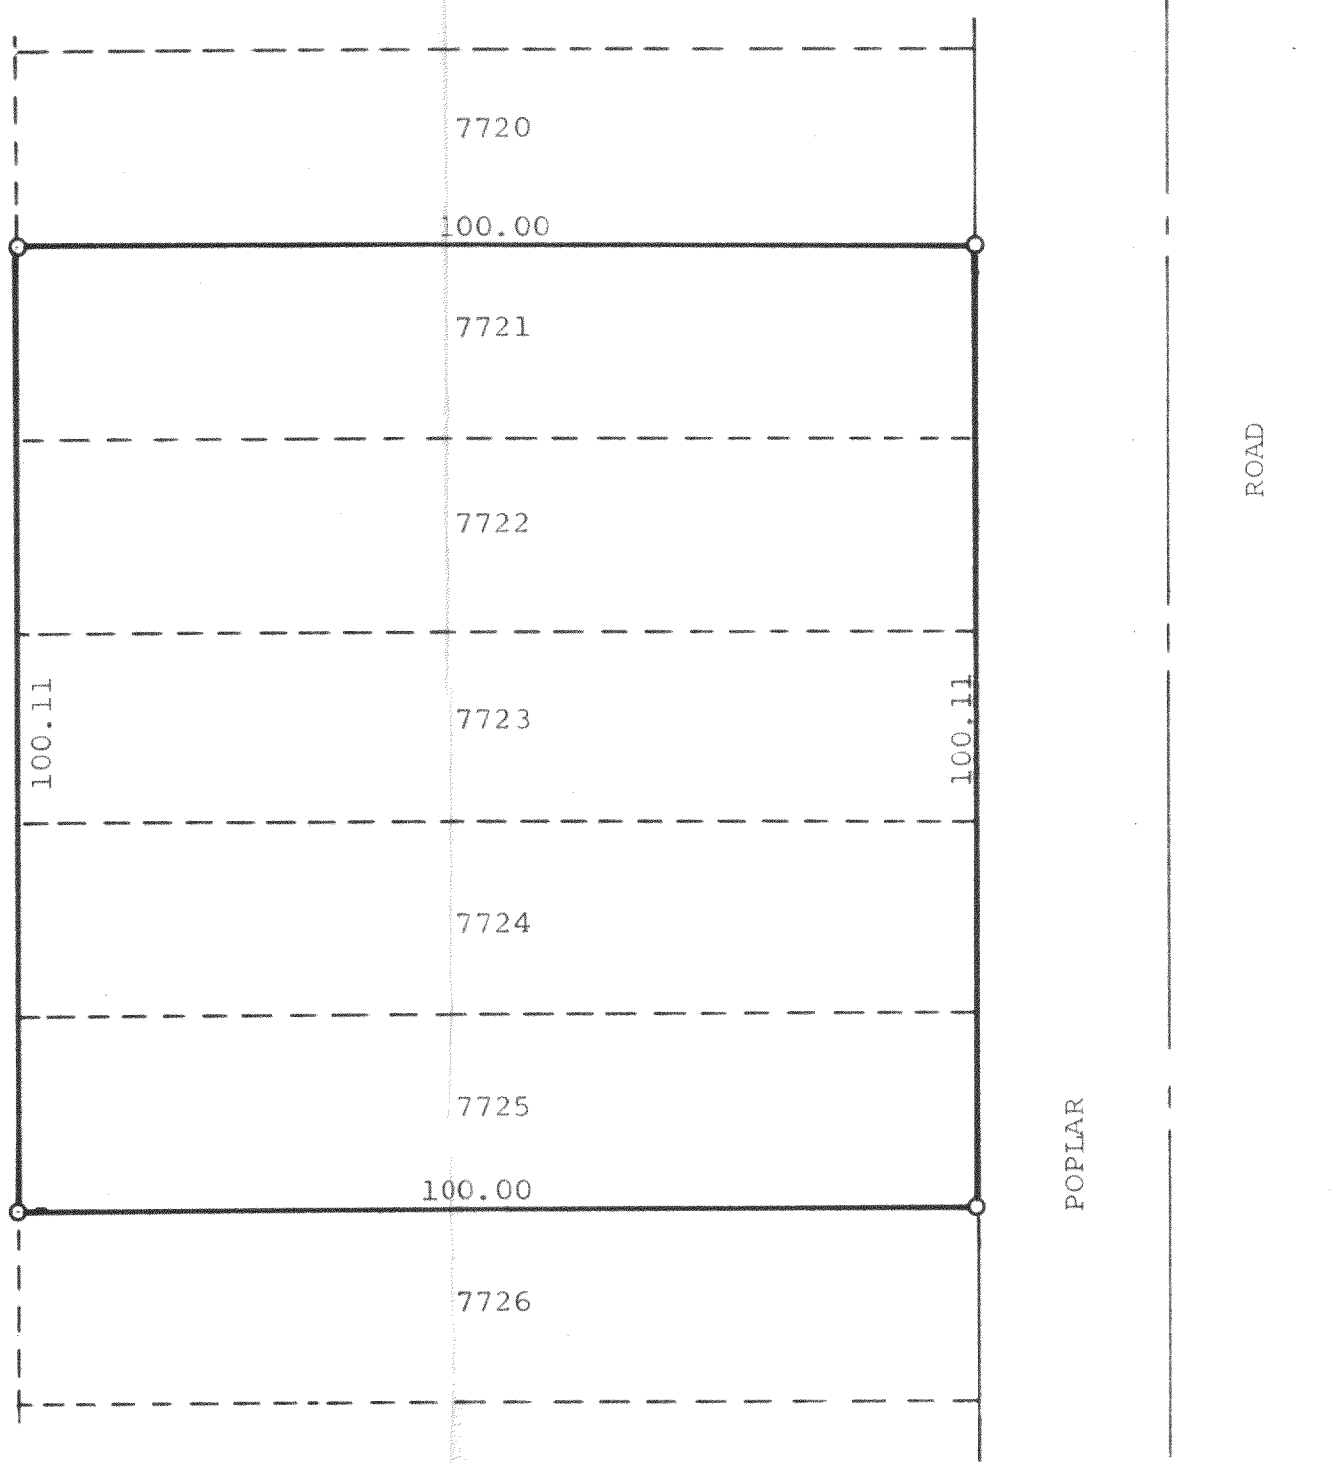

Plat of survey of Lots 7721-7725 Inclusive in Lake Como Beach,
a subdivision located in the Town of Geneva, Walworth County,
Wisconsin.
February 18, 1971

George T. Dunham
George T. Dunham, Surveyor

