


217-3070

PLAT OF SURVEY

UNIT 20-19
GENEVA NATIONAL CONDOMINIUM
NO. 20
LOCATED IN TOWN 2 NORTH, RANGE 17 EAST
WALWORTH COUNTY, WISCONSIN

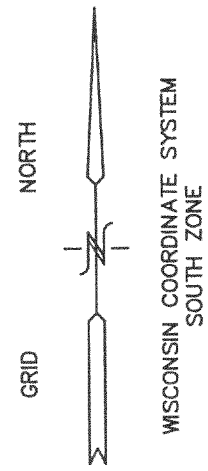

BENCH MARK
RIM SANITARY
MANHOLE
ELEV.=1010.79'
{IE=1002.69'}

EXISTING
HYDRANT

EDGE OF
PAVEMENT

MASTERS ROAD
66' WIDE PRIVATE R.O.W.

WATER BOX
ELEC. BOX
CATV BOX

VALVE BOX
SPRINKLER

EXISTING RESIDENCE
F.F.=1016.1'

UNIT 20-20

DECK

UNIT 20-19
21,049 S.F.

EXISTING
RESIDENCE
G.E.=1012.8'
F.F.=1014.7'

UNIT 20-18

14" OAK

78" OAK

24" OAK

EDGE OF CART PATH

GOLF CLUB GROUNDS

IE=1005.8'

EXTG. 8" PVC PIPE

IE=1005.2'

10 5 0 10 20 30 40 50 60 70 80 90 100
MAP SCALE IN FEET ORIGINAL 1" = 20'

LEGEND

- = FOUND IRON REBAR STAKE
- (xxx) = RECORDED AS


NOTE: COPIES OF THIS MAP TO WHICH THE FOLLOWING CERTIFICATE WILL APPLY SHOW SURVEYOR'S ORIGINAL SEAL AND SIGNATURE IN RED INK. COPIES BY ANY OTHER MEANS MAY HAVE ALTERATIONS WHICH DO NOT REPRESENT THE SURVEYOR'S WORK PRODUCT.

I HEREBY CERTIFY THAT THE ABOVE DESCRIBED PROPERTY HAS BEEN SURVEYED UNDER MY DIRECTION AND THAT THE ABOVE MAP IS A TRUE REPRESENTATION THEREOF AND SHOWS THE SIZE AND LOCATION OF THE PROPERTY, ITS EXTERIOR BOUNDARIES, THE LOCATION OF ALL VISIBLE STRUCTURES, AND DIMENSIONS OF ALL PRINCIPLE BUILDINGS THEREON, BOUNDARY FENCES, APPARENT EASEMENTS, ROADWAYS, AND VISIBLE ENCROACHMENTS, IF ANY. THIS SURVEY IS MADE FOR THE USE OF THE PRESENT OWNERS OF THE PROPERTY, AND ALSO THOSE WHO PURCHASE, MORTGAGE, OR GUARANTEE THE TITLE THERETO WITHIN ONE YEAR FROM THE DATE HEREOF.

DATED: JULY 26, 2005

PETER S. GORDON R.L.S. 2101

AUG 3 2005

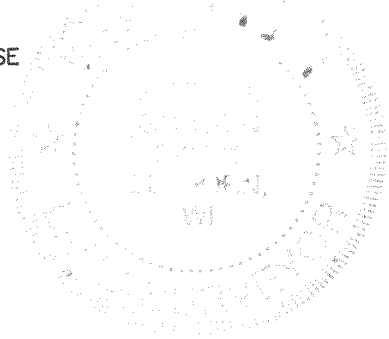

WORK ORDERED BY: RESORT REALTY
FOR BOARDWALK ASSOCIATES
1081 HIDDEN COTTAGE CIRCLE
LAKE GENEVA, WI 53147

FARRIS, HANSEN & ASSOCIATES, INC.
Engineering, Architecture, Surveying
7 Ridgway Court P.O. Box 437
ELKHORN, WISCONSIN 53121
Office: (262) 723-2098
Fax: (262) 723-5886

REVISIONS

PROJECT NO.
3269.20.19
DATE:
05-13-04
SHEET NO.
1 OF 1

36.0 2000.9