

Job No. 8005

Office Phone 639-1559

**ROBERT J. KELLEY**

Wisconsin Land Surveyor  
3213 WASHINGTON AVE.  
RACINE, WISCONSIN 53405  
Phone: 636-2070

**PLAT OF SURVEY**

OF PROPERTY OF John M. and Karen J. Danora

described as follows: Lot 70, Wildwood Addition No. One, according to the recorded plat  
thereof. Said land being in the Town of Geneva, Walworth County, Wisconsin.

Racine County Surveyor File No. 11022  
Received for File

JUN 3 1980


By

Deputy for Records

BALSDON ROAD

LAKEVIEW

DRIVE

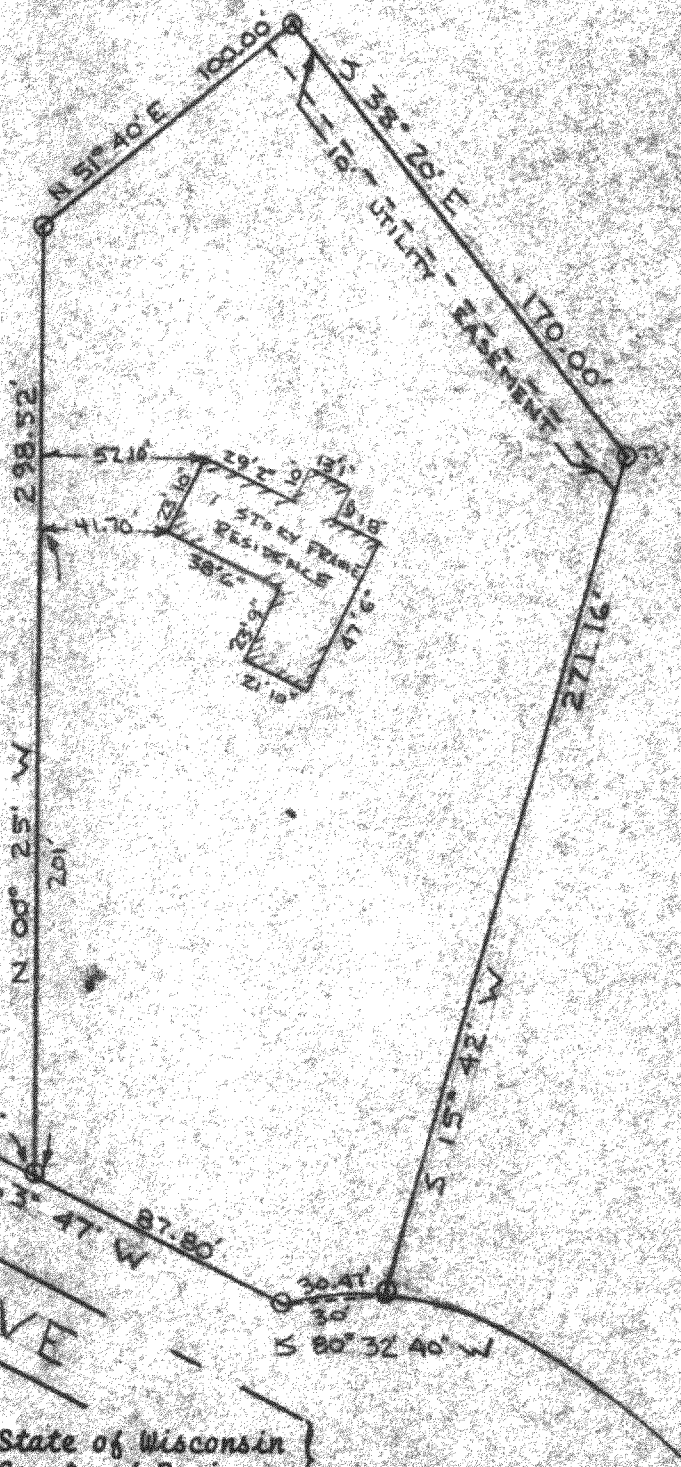


State of Wisconsin  
County of Racine

I, R. J. KELLEY, do hereby certify that I have surveyed  
the property described above according to official records  
and that the plat above drawn is a correct representation  
of said survey.

Racine, Wis., 1 - 22, 19 80

*Robert J. Kelley*

Scale 1" = 60'  
O Denotes Iron Stakes

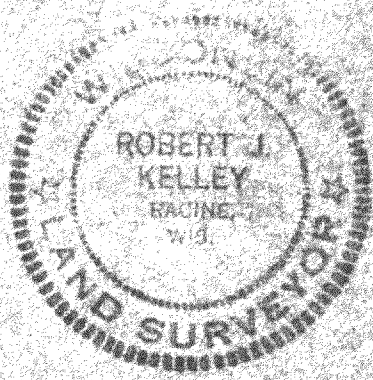

JWSA 00019

217-3106