

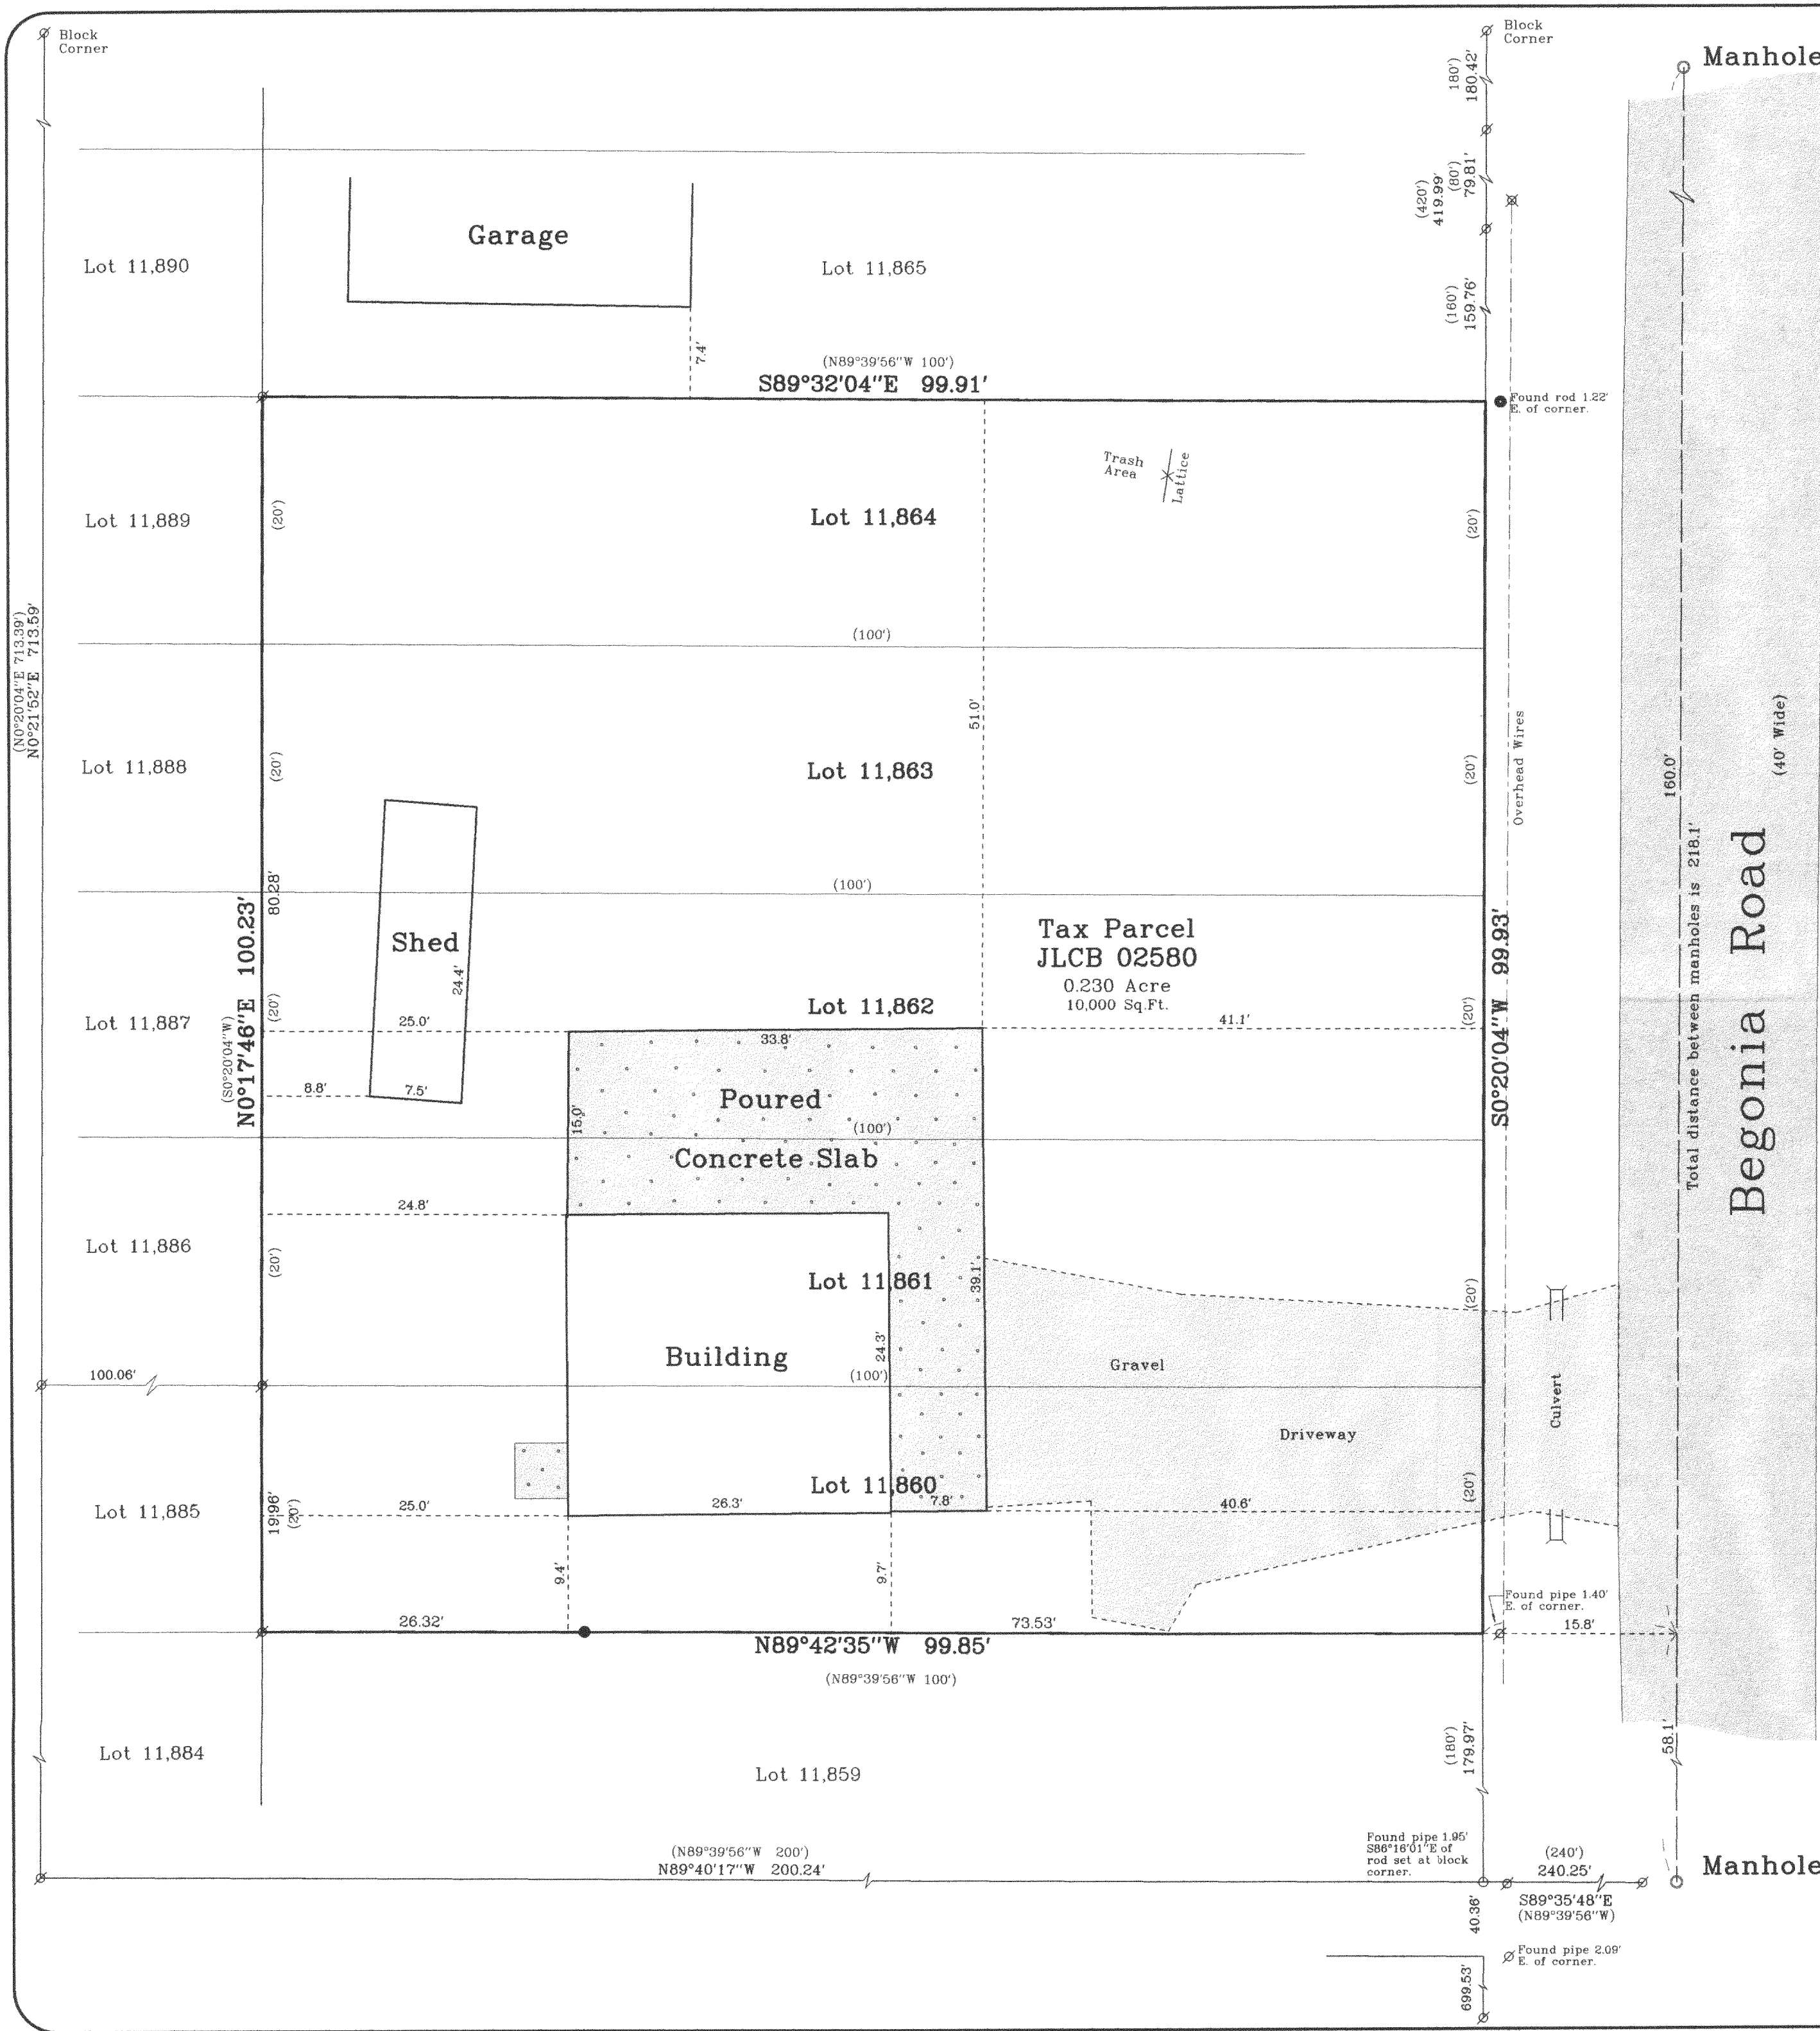


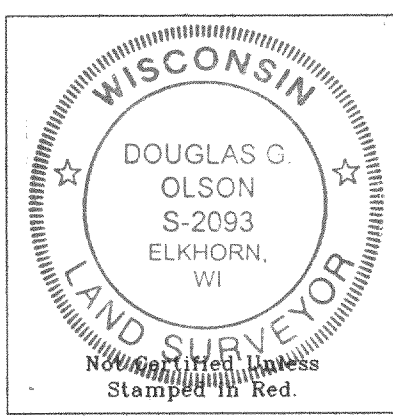

Plat of Survey

of
Lots 11,860 through 11,864 of
Block 213 of Lake Como Beach,
a subdivision located in the Northeast 1/4 of Section 29,
Town 2 North, Range 17 East, Town of Geneva, Walworth
County, Wisconsin.

Surveyed for: **BKs Designs, LLC**
621 Bowers Boulevard
Delavan, Wisconsin. 53115

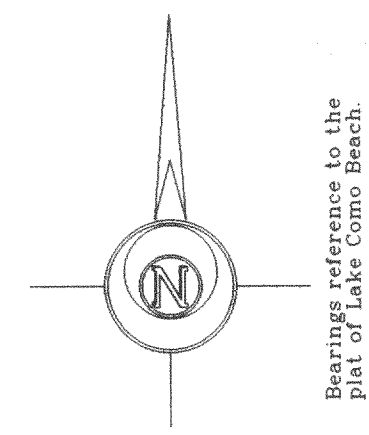

- Notes: 1) This survey plat is not certified unless signed and sealed in red ink.
- 2) This survey is subject to Wisconsin lien laws. This Plat of Survey is the notice of intent to file lien. Lien waiver required.

Copyright © 2005 by Jensen & Olson Land Surveying, LLC.

All rights reserved. No part of this survey plat may be reproduced or transmitted in any form by any means - graphic, electronic, or mechanical, including photocopying, tracing, or information storage and retrieval systems - without permission in writing from Douglas G. Olson, Jensen & Olson Land Surveying, LLC.

I, Douglas G. Olson, Wisconsin Registered Land Surveyor, do hereby certify that this survey was performed by me or under my direction in full compliance with the owner's/agent's instructions and Chapter A-E 7 of the Wisconsin Administrative Code "Minimum Standards for Property Surveys"; and that this map is an accurate representation thereof to the best of my knowledge and belief.

Douglas G. Olson
Wisconsin Registered Land Surveyor - 2093

Survey Date: May 3, 2005.
Revisions: No. 1 - Concrete slab

Scale in Feet
1" = 10'
0' 5' 10' 20'

Jensen & Olson Land Surveying, LLC
45 South Wisconsin Street
Elkhorn, Wisconsin. 53121
Telephone (262) 723-3434
Facsimile (262) 723-8044

Legend
Found Iron Pipe 3/4" dia.
Found Iron Rod, 1-3/16" dia.
Recorded Information
Utility Pole
Manhole
Asphalt Surface
Concrete Surface
Gravel

Sheet 1 of 1 Sheets
Job Reference Number
2005.064

2005.064

217-3123

JLCB 02580