


AS-BUILT MAPPING PLAT OF SURVEY

UNIT 19-12
GENEVA NATIONAL CONDOMINIUM
NO. 19
LOCATED IN TOWN 2 NORTH, RANGE 17 EAST,
WALWORTH COUNTY, WISCONSIN

GOLF CLUB GROUNDS

LEGEND

● = FOUND IRON REBAR STAKE

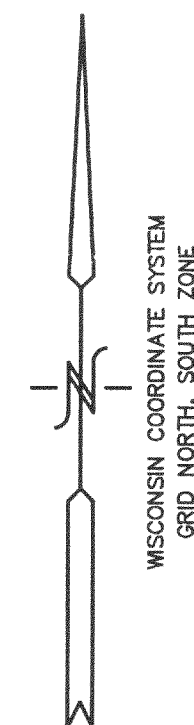

UNIT 19-11

DRAINAGEWAY

SWALE

UNIT 19-12
45,849 S.F.

SWALE

50' REAR YARD

AS-BUILT
RESIDENCE
(FIELD LOCATED 11/4/05)

UNIT 19-13

ST. ANDREWS ROAD
66' WIDE PRIVATE ROADWAY

PAVEMENT
2.4' NORTHWEST
OF PROPERTY LINE

EXISTING
RESIDENCE

NOTE: COPIES OF THIS MAP TO WHICH THE FOLLOWING CERTIFICATE WILL APPLY SHOW THE SURVEYOR'S ORIGINAL SEAL AND SIGNATURE IN RED INK. COPIES BY ANY OTHER MEANS MAY HAVE ALTERATIONS WHICH DO NOT REPRESENT THE SURVEYOR'S WORK PRODUCT.

I HEREBY CERTIFY THAT THE ABOVE DESCRIBED PROPERTY HAS BEEN SURVEYED UNDER MY DIRECTION AND THAT THE ABOVE MAP IS A TRUE REPRESENTATION THEREOF AND SHOWS THE SIZE AND LOCATION OF THE PROPERTY, ITS EXTERIOR BOUNDARIES, THE LOCATION OF ALL VISIBLE STRUCTURES, AND DIMENSIONS OF ALL PRINCIPLE BUILDINGS THEREON, BOUNDARY FENCES, APPARENT EASEMENTS, ROADWAYS, AND VISIBLE ENCROACHMENTS, IF ANY. THIS SURVEY IS MADE FOR THE USE OF THE PRESENT OWNERS OF THE PROPERTY, AND ALSO THOSE WHO PURCHASE, MORTGAGE, OR GUARANTEE THE TITLE THERETO WITHIN ONE YEAR FROM THE DATE HEREOF.

DATED: JUNE 14, 2004

PETER S. GORDON

FARRIS, HANSEN & ASSOCIATES, INC.
Engineering, Architecture, Surveying
7 Ridgway Court P.O. Box 437
ELKHORN, WISCONSIN 53121
Office: (262) 723-2098
Fax: (262) 723-5886

REVISIONS
03/25/2004
TO SHOW
ENCROACHMENT
04/14/2004
SHOW TOPO-
GRAPHICAL
FEATURES
06/15/2005
SITE, GRADING,
DRAINAGE, &
EROSION
CONTROL PLAN
07/26/2005
MISC. REVISIONS
11/05/2005
TO SHOW SIZE
AND LOCATION
OF AS-BUILT
RESIDENCE

PROJECT NO.
3269.19-12
DATE:
03/25/2004
SHEET NO.
1 OF 1

NOV 07 2005

JGN 19-12

217-3150