


PREPARED FOR: PREPARED FOR:
HOMESTEAD REALTY
520 BROAD STREET
LAKE GENEVA, WI
53147

PLAT OF SURVEY

- OF -

LOTS 2797-2805 AND 2827-2833 BLOCK 49 OF LAKE
COMO BEACH SUBDIVISION; LOCATED IN TOWN 2
NORTH, RANGE 17 EAST, WALWORTH COUNTY,
WISCONSIN.

PATHFINDER SURVEYING, INC.
N3705 WILLOWBEND LANE
LAKE GENEVA, WI, 53147
262-248-3697

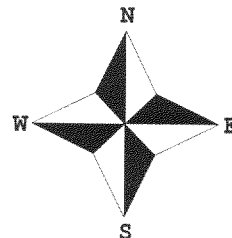


- () = recorded as
□ = found iron bar
○ = found iron pipe
● = set iron pipe
■ = set iron bar

SCALE 1" = 20'

JOB # 04-420

TAX ID # JLCB00489


JOHN KROTT S - 2258
Wisconsin Registered Land Surveyor
(original if signed in red)
DATE OF LAST REVISION: 10 / 20 / 2005
DATED THIS THE 18th DAY OF AUGUST 2004.

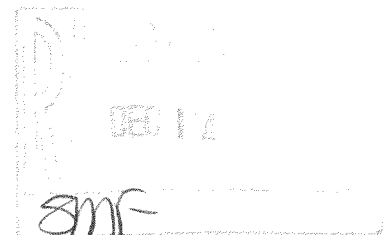

John P. Krott

C.L. TULIP ROAD

(40' WIDE ROAD)

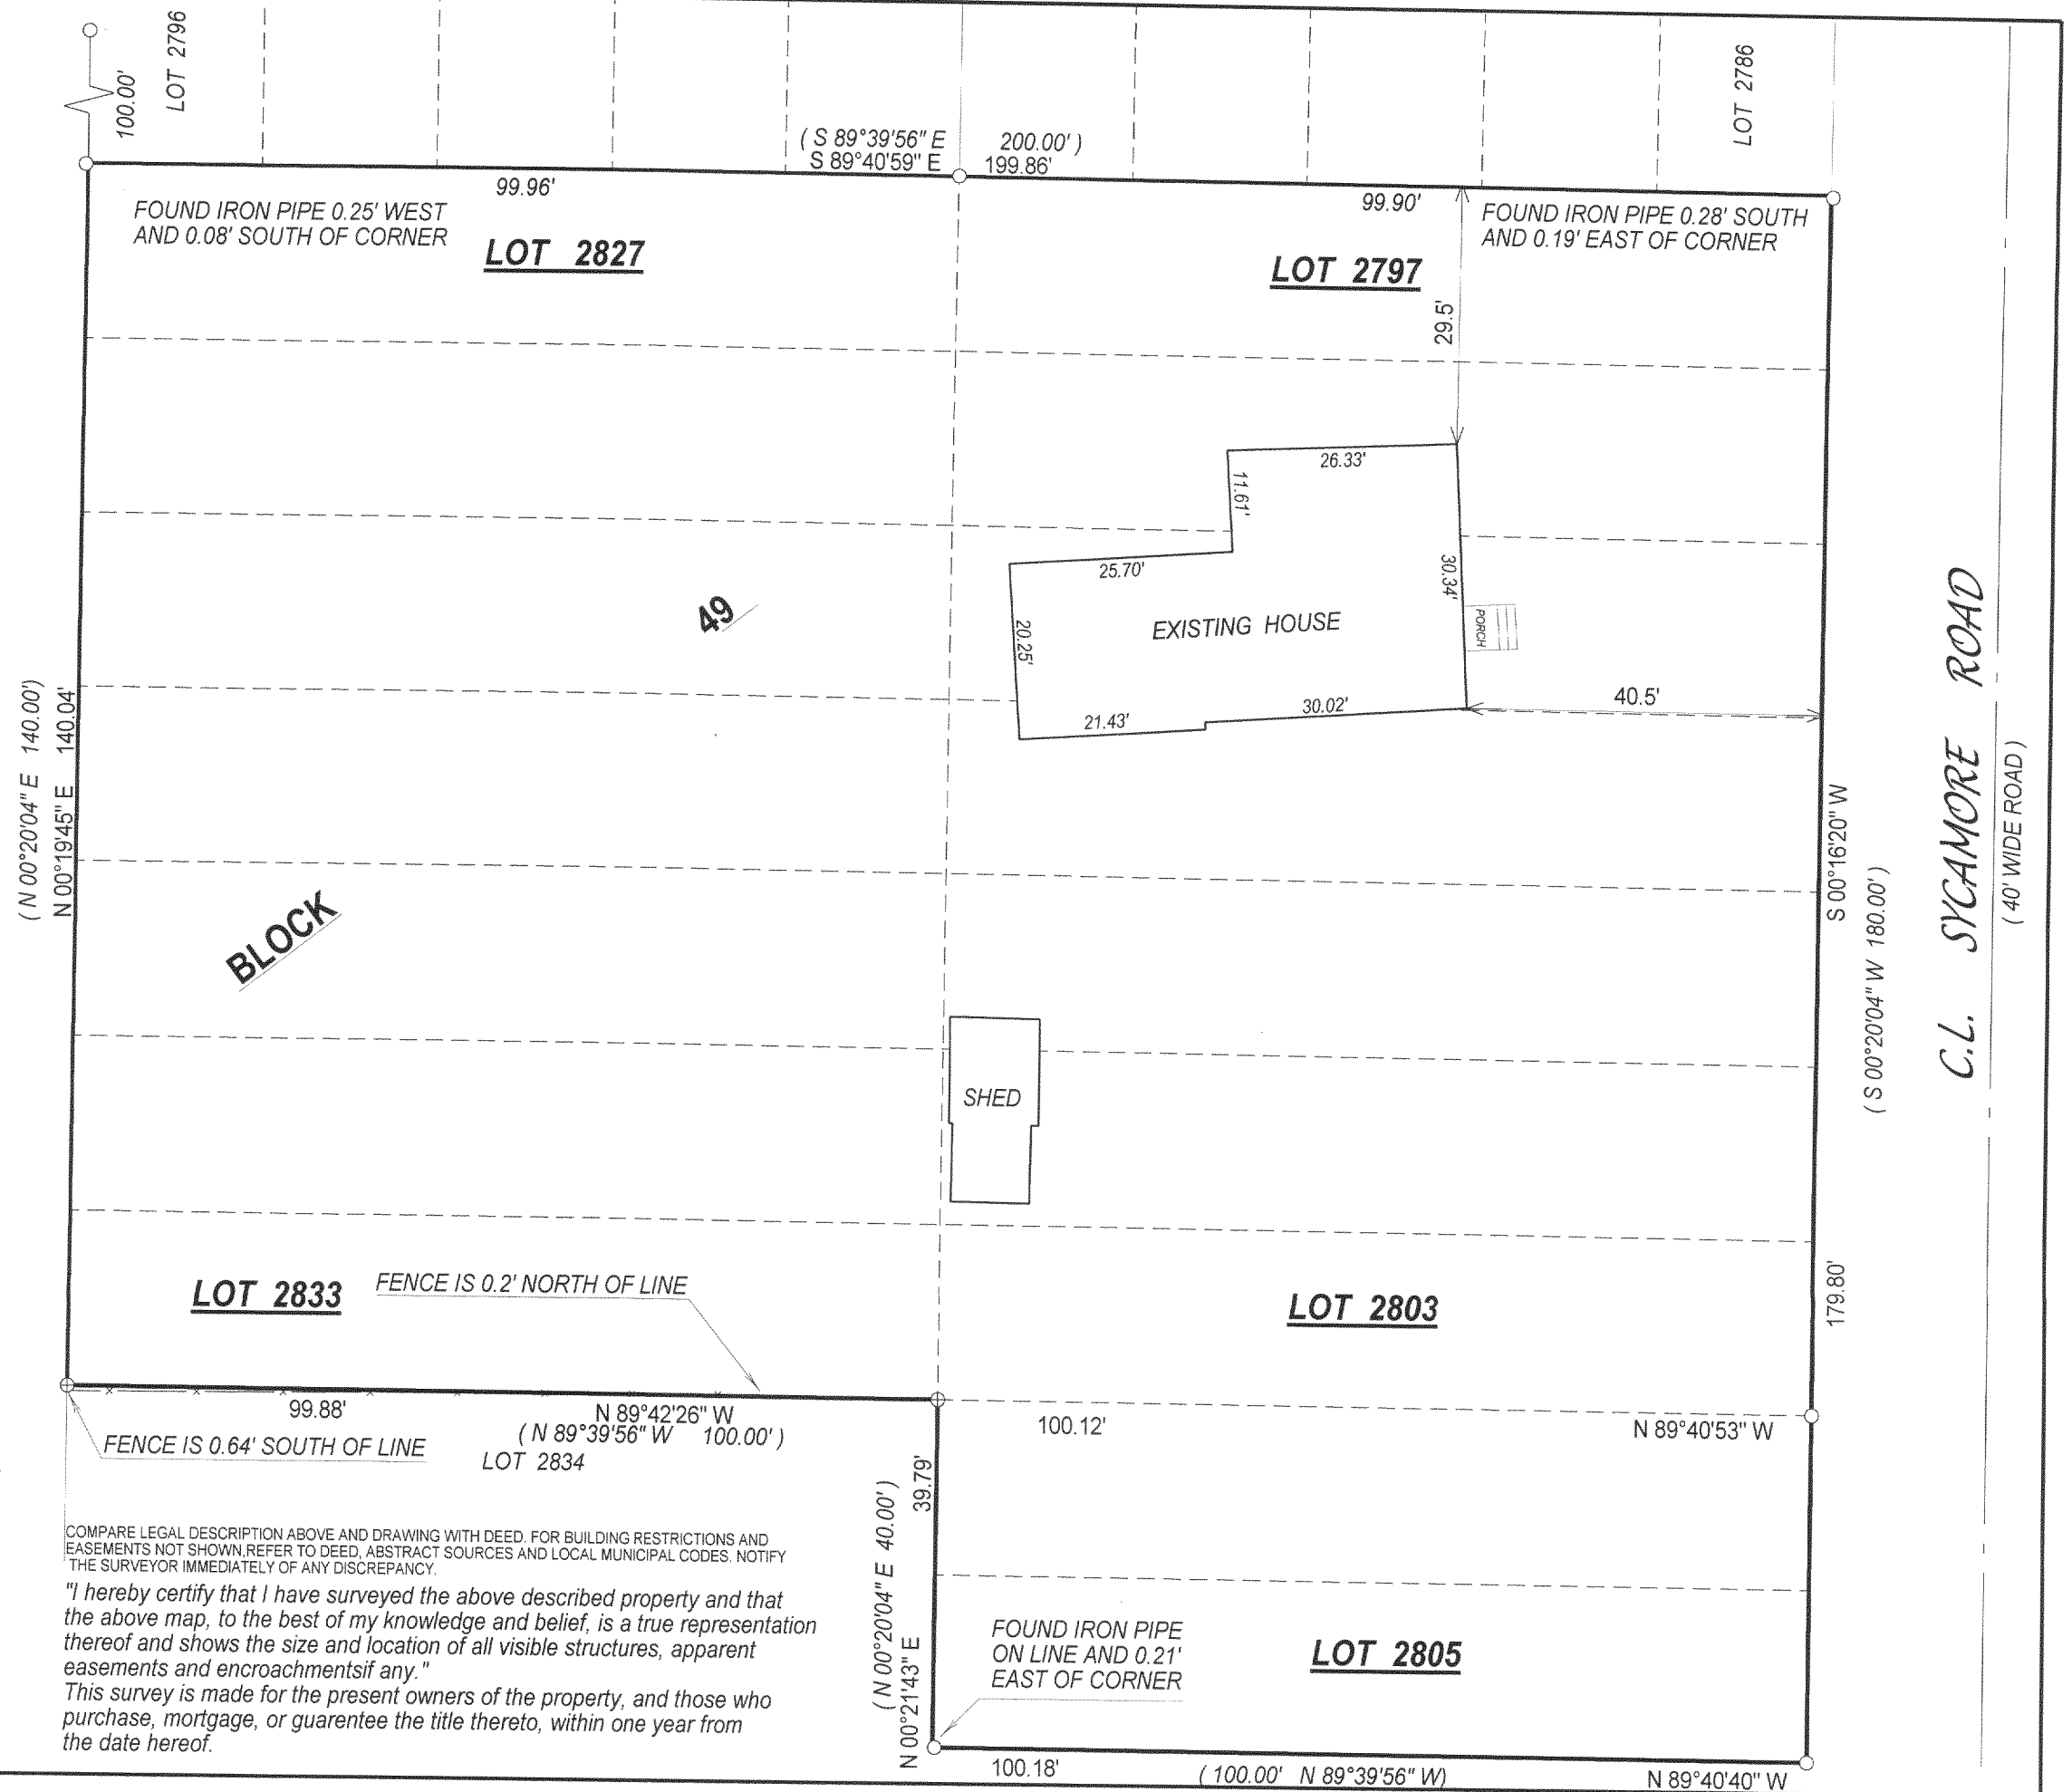

JLCB-489 + JLCB-490

217-3167