


1612

NORTH ROADWAY

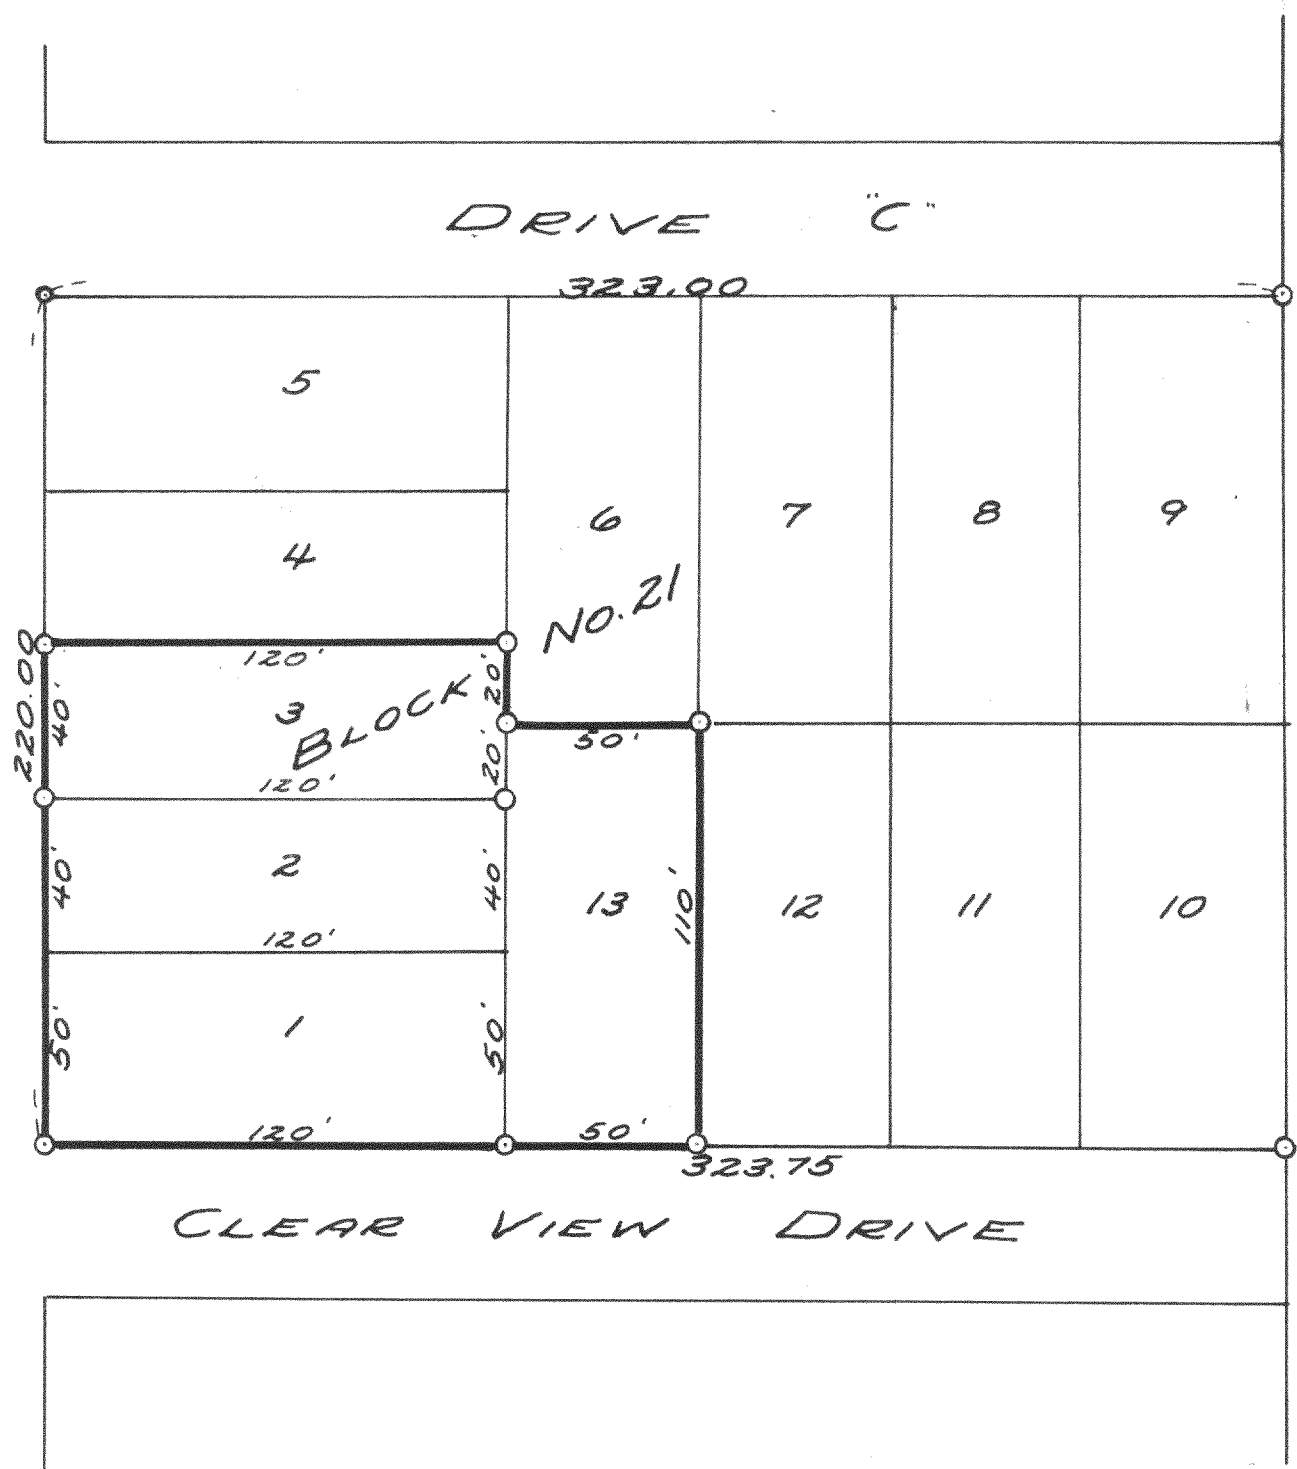

SCALE 1"=50'
O=IRON PIPE

PLAT OF SURVEY OF LOTS 1, 2, 3 AND 13 OF ²
SUNSET HILLS SUBDIVISION IN SECTION 33 BL. 21
T2N, R17E, WALWORTH COUNTY, WISCONSIN.

DECEMBER, 1946

H.E. Johnson
SURVEYOR