

PLAT OF SURVEY
UNIT 3-40
GENEVA NATIONAL CONDOMINIUM
NO. 3
LOCATED IN TOWN 2 NORTH, RANGE 17 EAST
WALWORTH COUNTY, WISCONSIN



WORK ORDERED BY -
THE RAULAND AGENCY FOR
SHOEDEN, INC.
17 N. FIRST STREET
GENEVA, IL 60134

FARRIS, HANSEN & ASSOCIATES, INC.
Engineering, Architecture, Surveying
7 Ridgway Court P.O. Box 437
ELKHORN, WISCONSIN 53121
Office: (414) 723-2098
Fax: (414) 723-5886

REVISIONS
10/20/98 -
TOPOGRAPHY
& TREE LOC.
ADDED

PROJECT NO.
3269.3-40
DATE:
5/9/97
SHEET NO.
1 OF 1



- LEGEND
- = FOUND IRON REBAR STAKE
 - ▲ = FOUND STEEL PIN W/CAP
 - ⊗ = WATER SERVICE LOCATED
 - ⊙ = HYDRANT LOCATED
 - = MANHOLE LOCATED
 - = TRANSFORMER LOCATED
 - ▣ = UTILITY BOX LOCATED
 - (XXX) = RECORDED AS

NOTE: CONTOURS SHOWN ARE COMPUTER
INTERPOLATIONS FROM GROUND SHOTS
TAKEN SEPTEMBER 1998.
VERTICAL DATUM: U.S.G.S. 1929 ADJ.

NOTE: COPIES OF THIS MAP TO WHICH THE FOLLOWING CERTIFICATE WILL APPLY SHOW SURVEYOR'S ORIGINAL
SEAL AND SIGNATURE IN RED INK. COPIES BY ANY OTHER MEANS MAY HAVE ALTERATIONS WHICH DO NOT
REPRESENT THE SURVEYOR'S WORK PRODUCT.


I HEREBY CERTIFY THAT THE ABOVE DESCRIBED PROPERTY HAS BEEN SURVEYED UNDER MY DIRECTION AND THAT
THE ABOVE MAP IS A TRUE REPRESENTATION THEREOF AND SHOWS THE SIZE AND LOCATION OF THE PROPERTY, ITS
EXTERIOR BOUNDARIES, THE LOCATION OF ALL VISIBLE STRUCTURES, AND DIMENSIONS OF ALL PRINCIPLE
BUILDINGS THEREON, BOUNDARY FENCES, APPARENT EASEMENTS, ROADWAYS, AND VISIBLE ENCROACHMENTS, IF
ANY. THIS SURVEY IS MADE FOR THE USE OF THE PRESENT OWNERS OF THE PROPERTY, AND ALSO THOSE WHO
PURCHASE, MORTGAGE, OR GUARANTEE THE TITLE THERETO WITHIN ONE YEAR FROM THE DATE HEREOF.

DATED: FEBRUARY 23, 2006

Peter S. Gordon
PETER S. GORDON R.L.S. 2101

10 5 0 10 20 30 40 50 60 70 80 90 100
MAP SCALE IN FEET ORIGINAL 1" = 20'

BENCH MARK-
NW FLANGE BOLT
HYDRANT
ELEV.=1071.22'

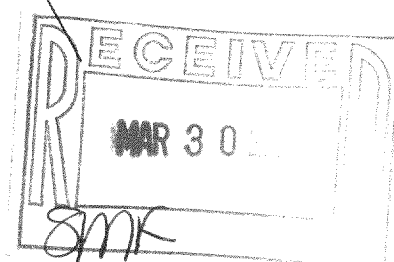

GEN 3-40

217-3218