
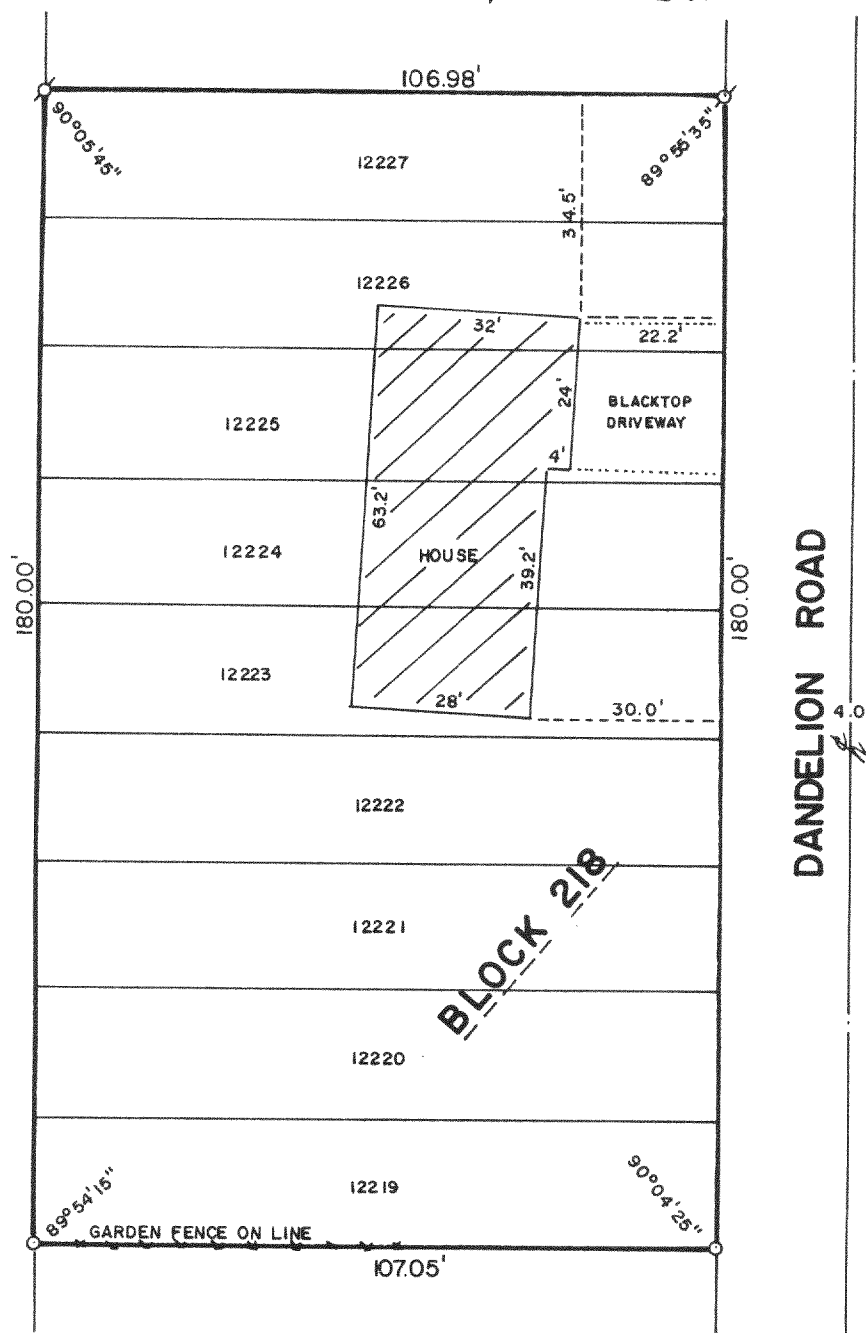



WALWORTH COUNTY
SURVEYING & MAPPING
LAKE GENEVA, WISCONSIN

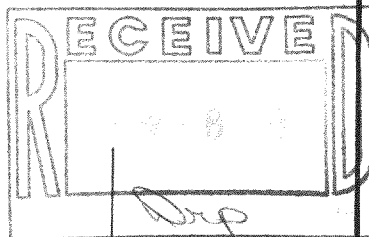

PLAT OF SURVEY OF

LOTS 12219-12227, BLOCK 218 OF LAKE
COMO BEACH, A SUBDIVISION LOCATED IN
T 2 N, R 17 E, WALWORTH COUNTY, WIS-
CONSIN.

ORDERED BY: MIKE KROSKY
RT. 2, BOX 493-21
LAKE GENEVA, WISCONSIN
53147

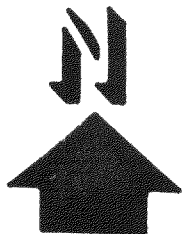

SCALE: 1"=60'

⊕ - IRON PIPE FOUND
○ - IRON PIPE PLACED

I, ROBERT M. BAERENWALD, DO HEREBY CERTIFY THAT I
HAVE SURVEYED THE PROPERTY HEREON DESCRIBED ACCORDING
TO THE OFFICIAL RECORDS AND THAT THE PLAT HEREON IS A
CORRECT REPRESENTATION OF THE PROPERTY LINES TO THE
BEST OF MY KNOWLEDGE AND BELIEF.

Robert M. Baerenwald
ROBERT M. BAERENWALD
WISCONSIN REGISTERED LAND SURVEYOR, S-1508

Oct. 5, 1987
DATE JOB NO. 1283

NOTE: THIS IS NOT A CERTIFIED COPY UNLESS SEALED.