
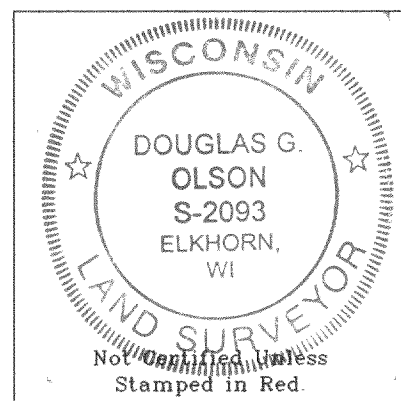


of

a subdivision located in the Southeast 1/4 of Section 21, Town 2 North, Range 17 East, Town of Geneva, Walworth County, Wisconsin.

Surveyed for: **Welcome Homes**
6300 South Highway 51
Janesville, Wisconsin. 53546

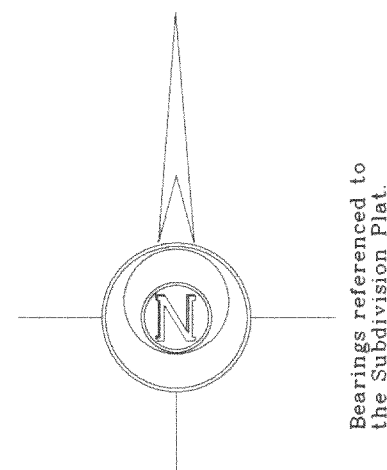

Notes: 1) This survey plat is not certified unless signed and sealed in red ink.


2) This survey is subject to Wisconsin lien laws.
This Plat of Survey is the notice of intent
to file lien. Lien waiver required.

Copyright © 2005 by Jensen & Olson Land Surveying, LLC.

All rights reserved. No part of this survey plat may be reproduced or transmitted in any form by any means - graphic, electronic, or mechanical, including photocopying, tracing, or information storage and retrieval systems - without permission in writing from Douglas G. Olson, Jensen & Olson Land Surveying, LLC.

I, Douglas G. Olson, Wisconsin Registered Land Surveyor, do hereby certify that this survey was performed by me or under my direction in full compliance with the owner's/agent's instructions and Chapter A-E 7 of the Wisconsin Administrative Code "Minimum Standards for Property Surveys"; and that this map is an accurate representation thereof to the best of my knowledge and belief.

Douglas G. Olson
Wisconsin Registered Land Surveyor - 2093

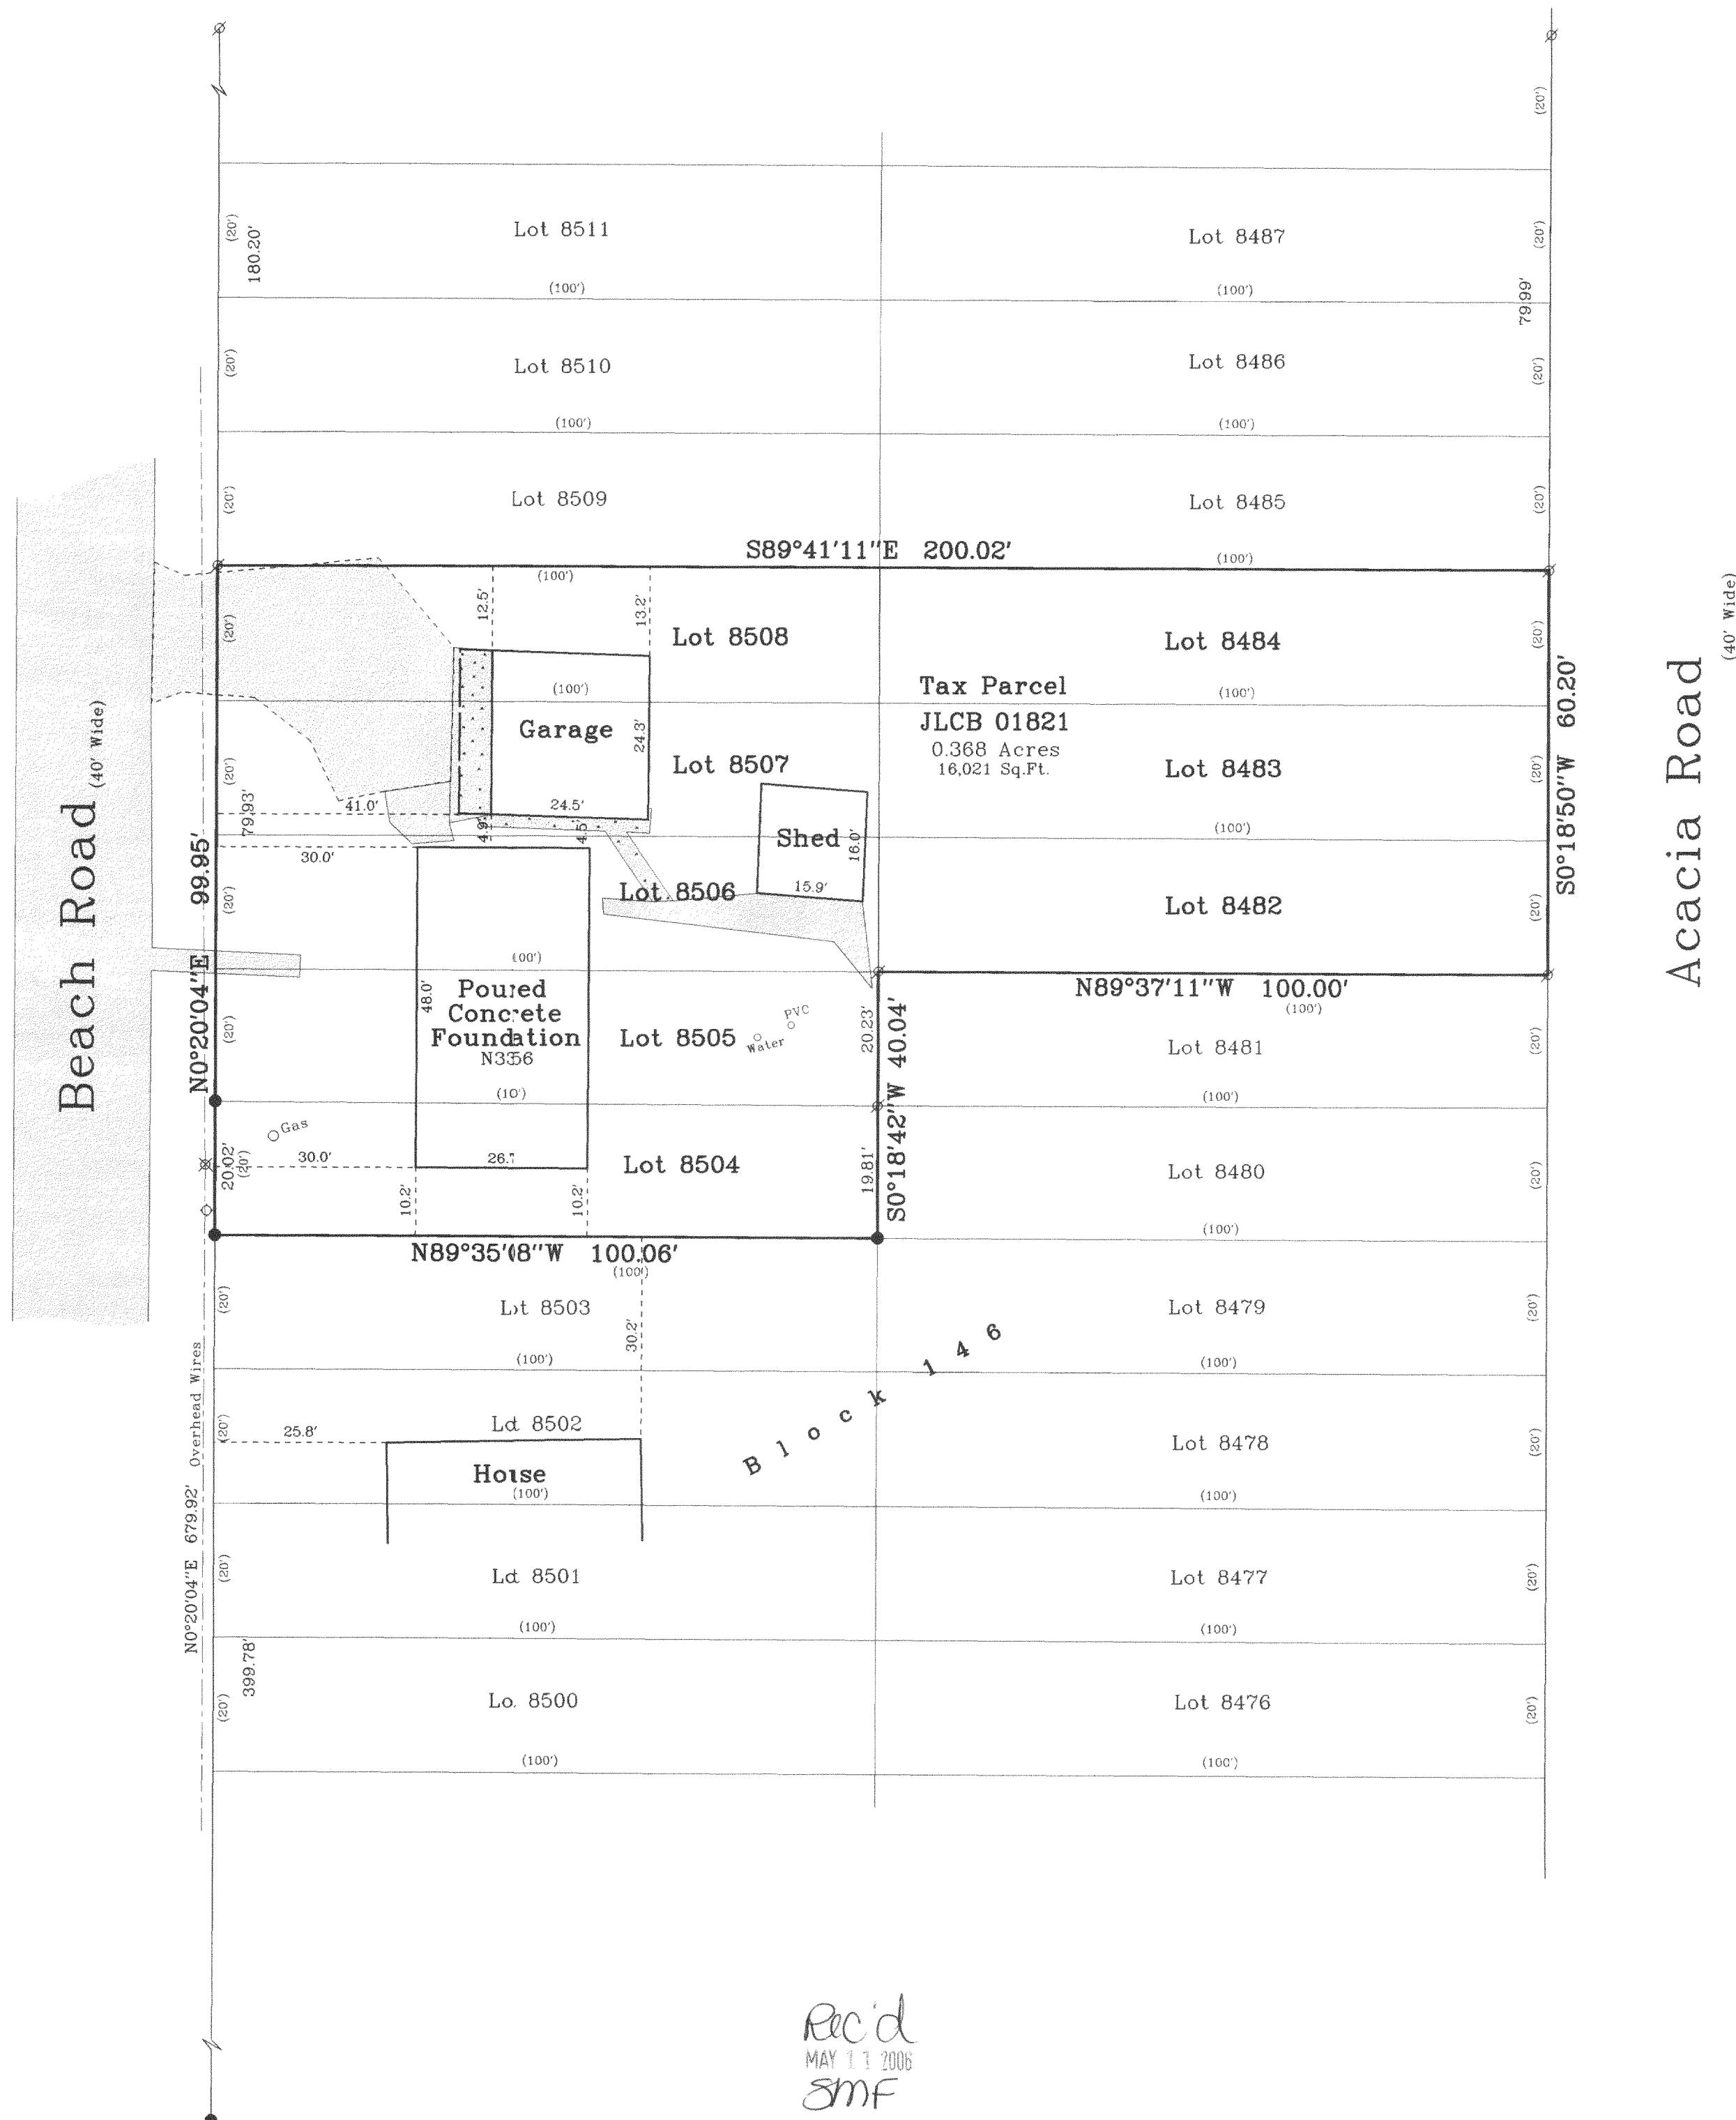

Survey Date: November 11, 2005.
Revisions: No. 1 – Foundation

Scale in Feet
1" = 20'

Jensen & Olson Land Surveying, LLC

45 South Wisconsin Street P.O. Box 322
Elkhorn, Wisconsin 53121
Telephone (262) 723-3434
Facsimile (262) 723-8044

Legend

- ⊗ Found Iron Pipe
- ⊙ Found Iron Rod
- Set Wood Stake
- Recorded Information
- Utility Pole
- Misc. Pipes as noted
- Water Valve
- Asphalt Surface
- Gravel

Sheet 1 of 1 Sheets

Job Reference Number

2005.160

JLCB-1821

217-3249