

LAND-MARK SURVEYING
Mark L. Miritz


Wisconsin Registered Land Surveyor S-2582

N9330 Knuteson Drive
Whitewater, WI 53190
Phone: (262) 495-3284
FAX : (262) 495-8421
LAND-MARKSURVEYING.COM

PLAT OF SURVEY

**LOTS 1, 2 AND 3 OF LAKE GENEVA KNOLL
SUBDIVISION, LOCATED IN THE SOUTHWEST
1/4 OF SECTION 33, TOWN 2 NORTH, RANGE
17 EAST, GENEVA TOWNSHIP, WALWORTH
COUNTY, WISCONSIN.**

OWNERS:
MICHAEL J. FOLEY
DORIAN K. FOLEY
W3905 STATE RD "50"
LAKE GENEVA, WI 53147

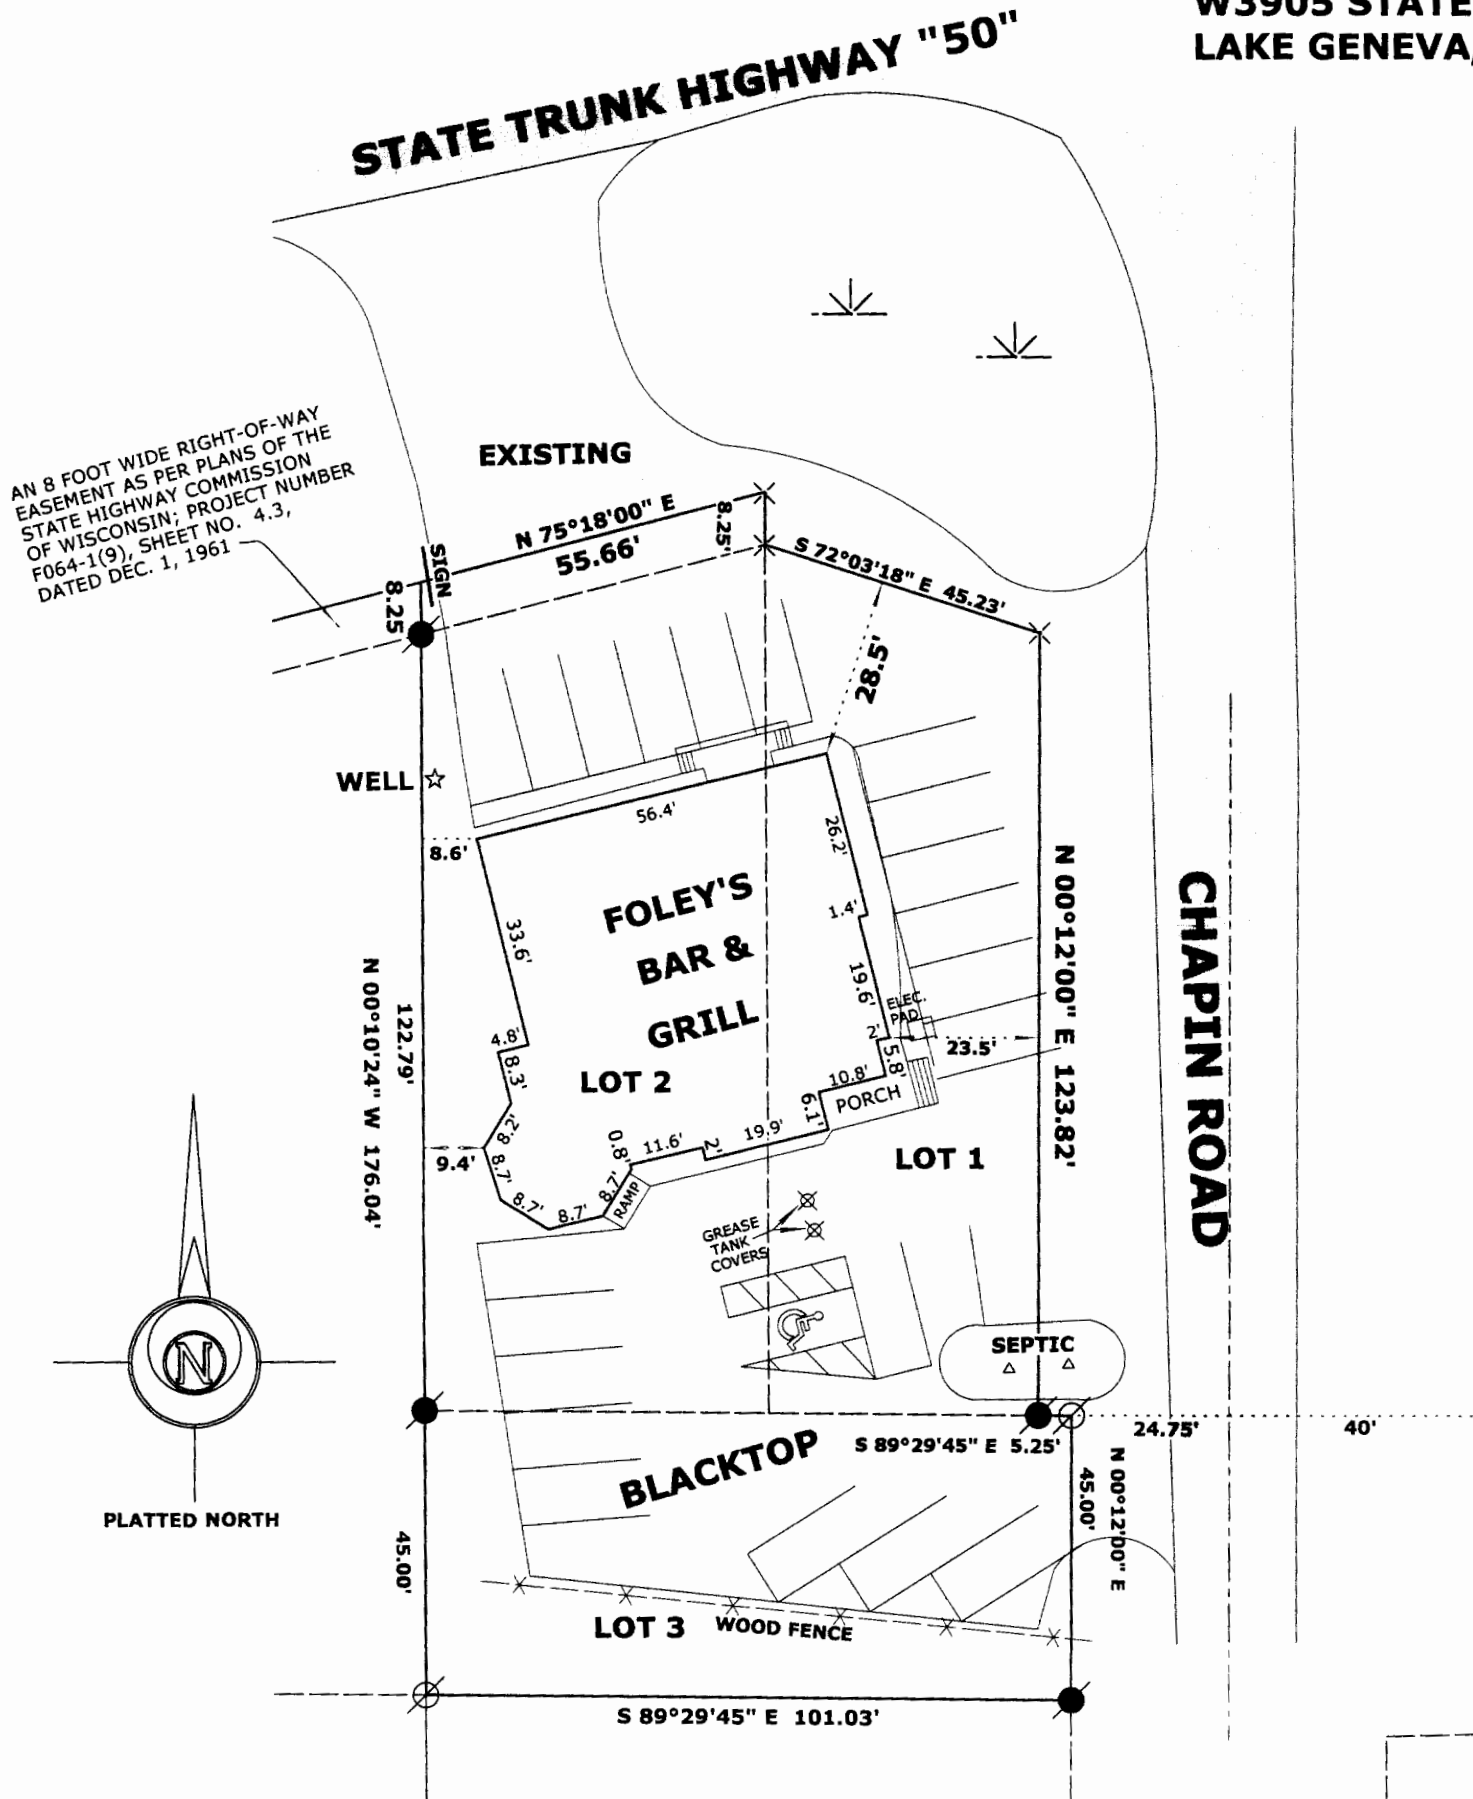

AUG 11 2006

8mf

LEGEND

- FOUND IRON PIPE
- FOUND IRON ROD
- ⊠ FOUND COUNTY MONUMENT
- × FOUND GIN SCREW
- + CHISEL CUT IN CONCRETE
- SET IRON ROD, 24" LONG, WEIGHING
1.5 LBS./LINEAL FT., 3/4" DIA.
- (x x) RECORDED AS DIMENSION
- x—x— EXISTING FENCE



SCALE: 1" = 30 FEET

"I hereby certify that the above described property has been surveyed by me or under my direction and that the above map is a true representation thereof and shows the size and location of the property, its exterior boundaries, the location of all visible structures and dimensions of all principal buildings thereon, boundary fences, apparent easements, roadways and visible encroachments, if any."

"This survey is made for the use of the present owners of the property, and also those who purchase, mortgage, or guarantee the title thereto within one year from date hereof."

Mark L. Miritz
MARK L. MIRITZ
WISCONSIN REGISTERED
LAND SURVEYOR S-2582

DATE: FEB. 24, 2006 JOB NO. 06.108

JLK-1

217-3291