


PLAT OF SURVEY



LOTS 10798-10804 AND 10820-10823 OF BLOCK 195
OF LAKE COMO BEACH, A SUBDIVISION
LOCATED IN TOWN 2 NORTH, RANGE 17 EAST, TOWN OF LINN,
WALWORTH COUNTY, WISCONSIN

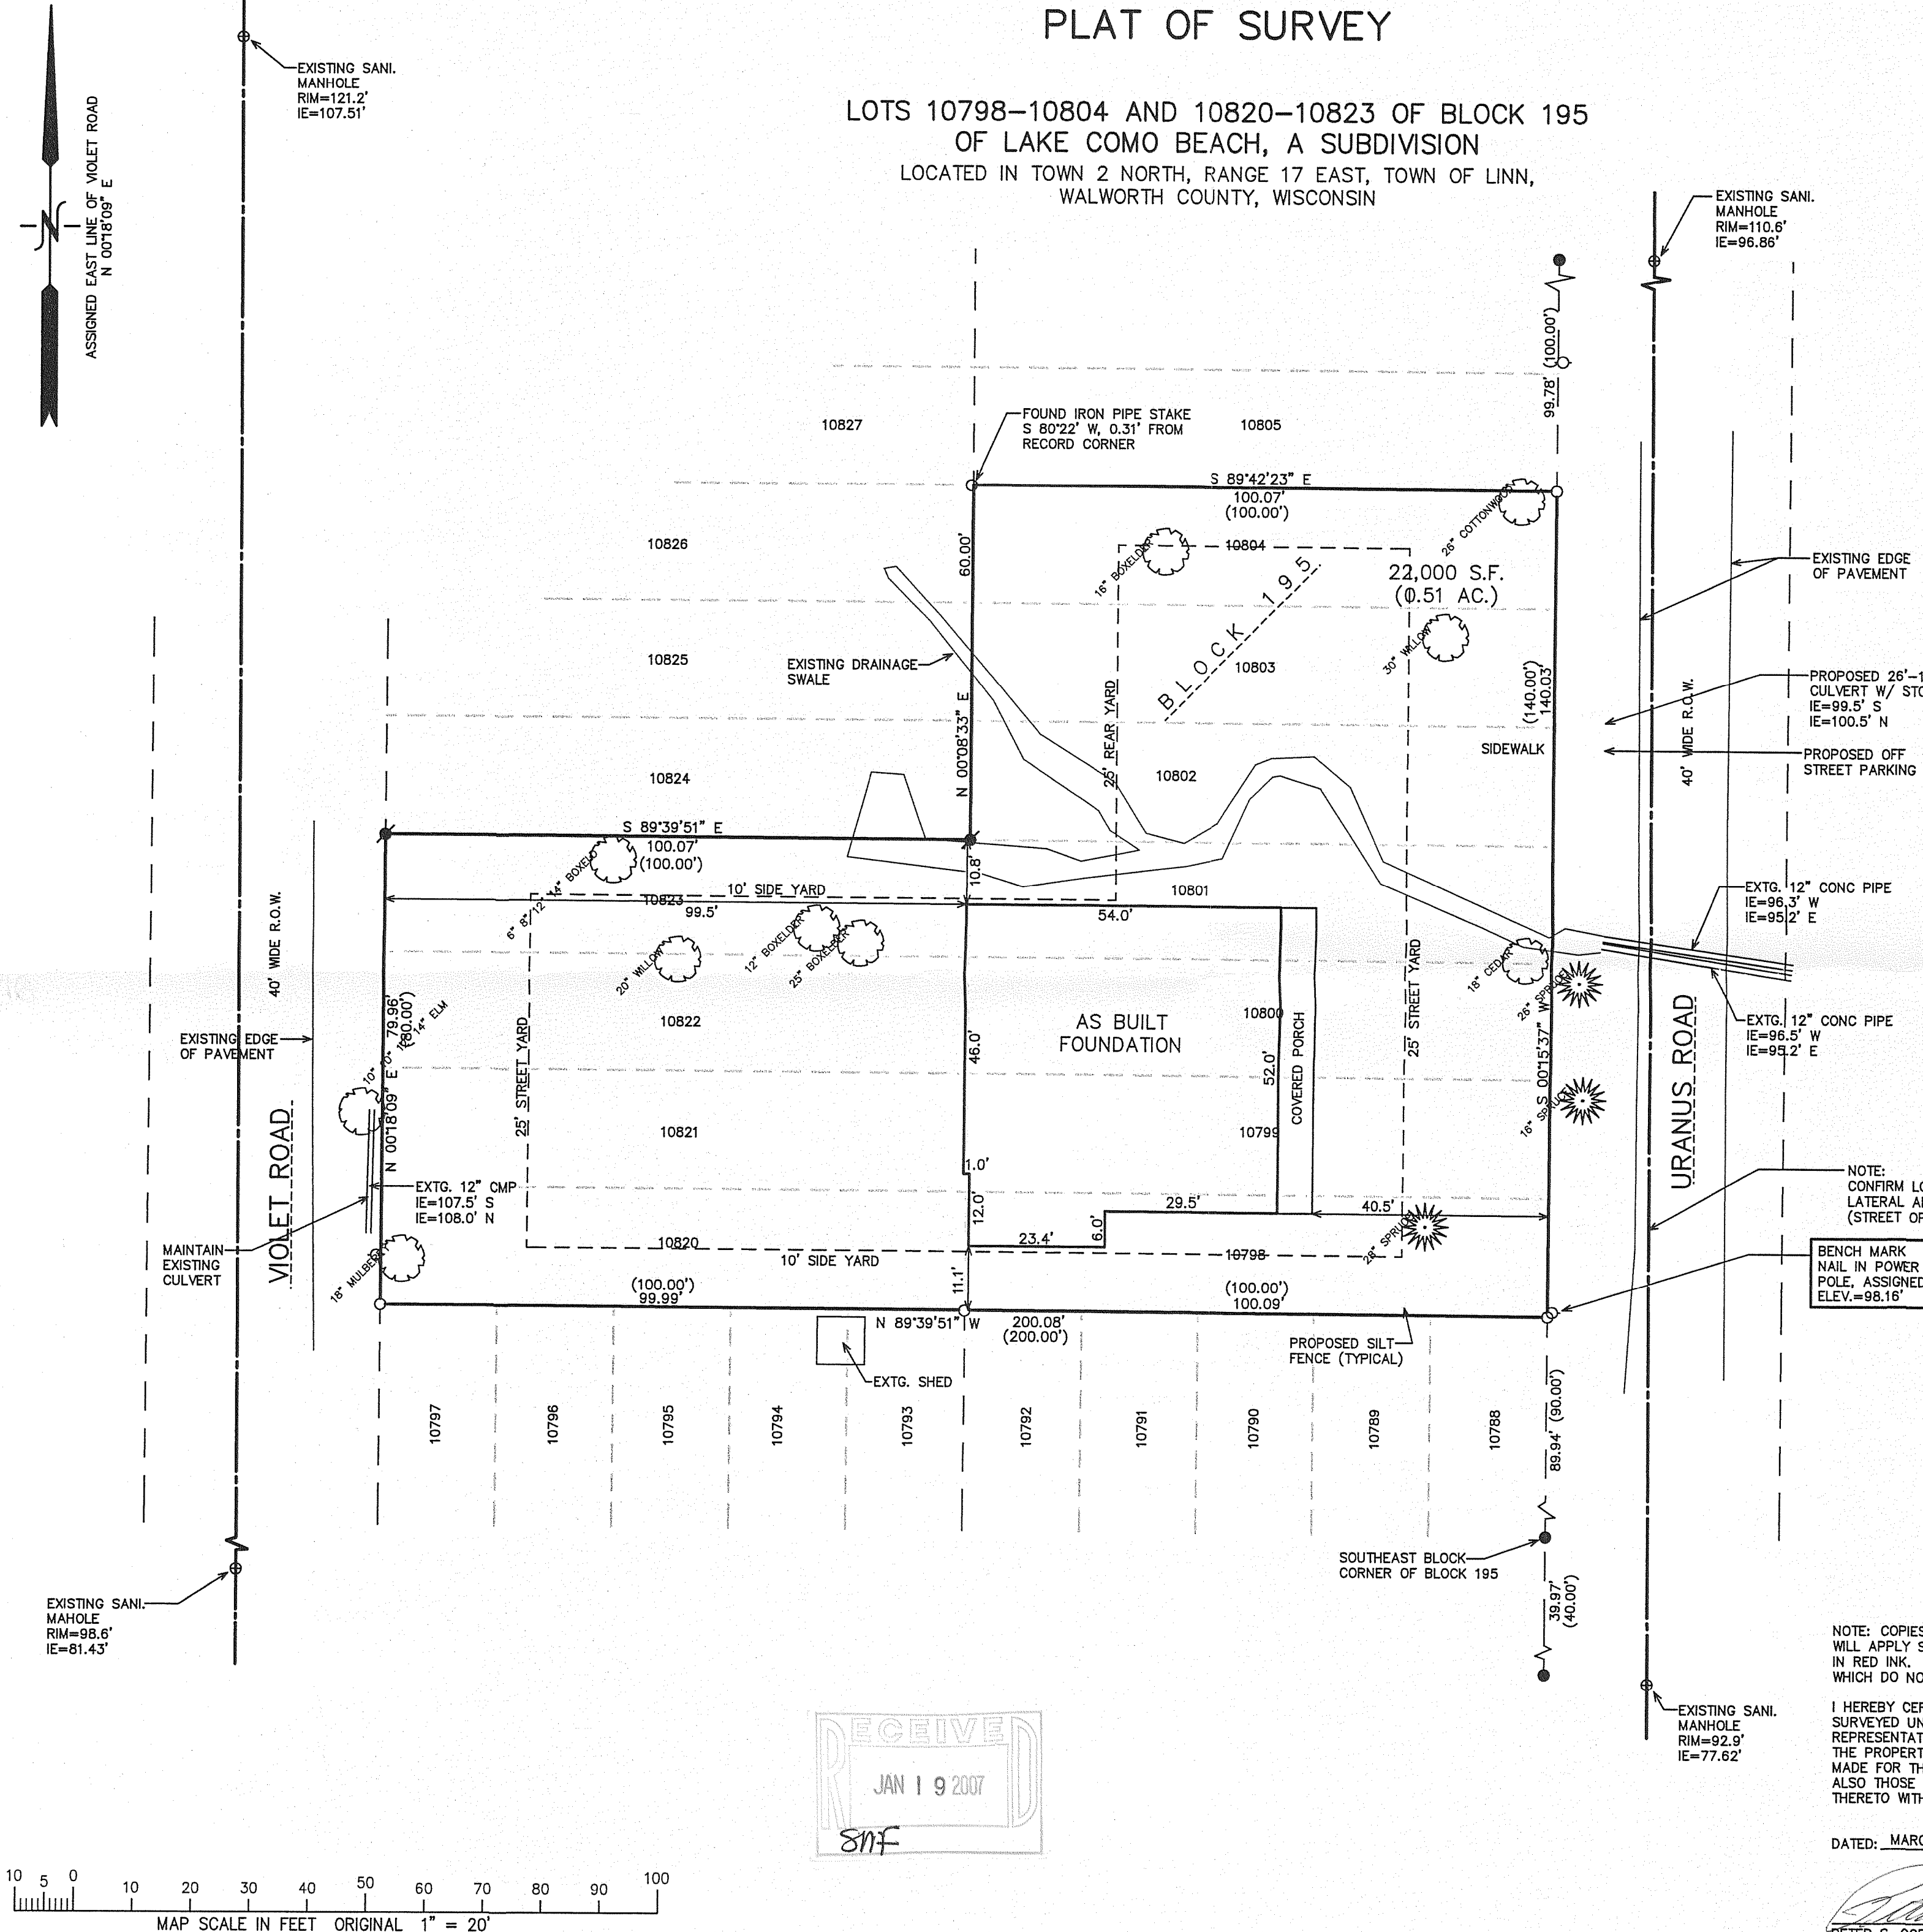

NOTE:
VERIFY EXISTING GROUND WATER CONDITION.

NOTE:
CONFIRM LOCATION OF SANITARY
LATERAL AND WATER SERVICE
(STREET OPENING MAY BE REQUIRED).

- LEGEND
- = FOUND IRON PIPE STAKE
 - = FOUND IRON REBAR STAKE
 - ⊙ = SET IRON REBAR STAKE
 - (XXX) = RECORDED AS

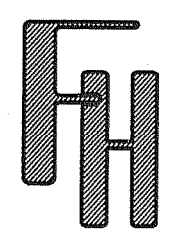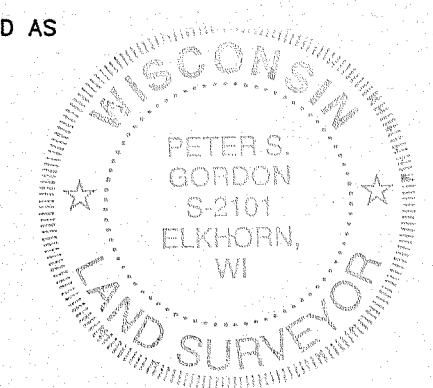

WORK ORDERED BY -
JIM FURLONG
5028 W. BALMORAL AVENUE
CHICAGO, IL 60630

FARRIS, HANSEN & ASSOCIATES, INC.
ENGINEERING - ARCHITECTURE - SURVEYING
7 RIDGWAY COURT P.O. BOX 437
ELKHORN, WISCONSIN 53121
OFFICE: (262) 723-2098 FAX: (262) 723-5886

REVISIONS
09/25/2006
SITE, GRADING,
DRAINAGE, &
EROSION
CONTROL PLAN
10/09/2006
MISC. REVISIONS

PROJECT NO.
2062.06
DATE:
03/15/06
SHEET NO.
1 OF 1

LCB-2347

217-3345