



PLAT OF SURVEY
OF

FAX: 262-537-4221

Parcel Identification Number: JLCB 01126

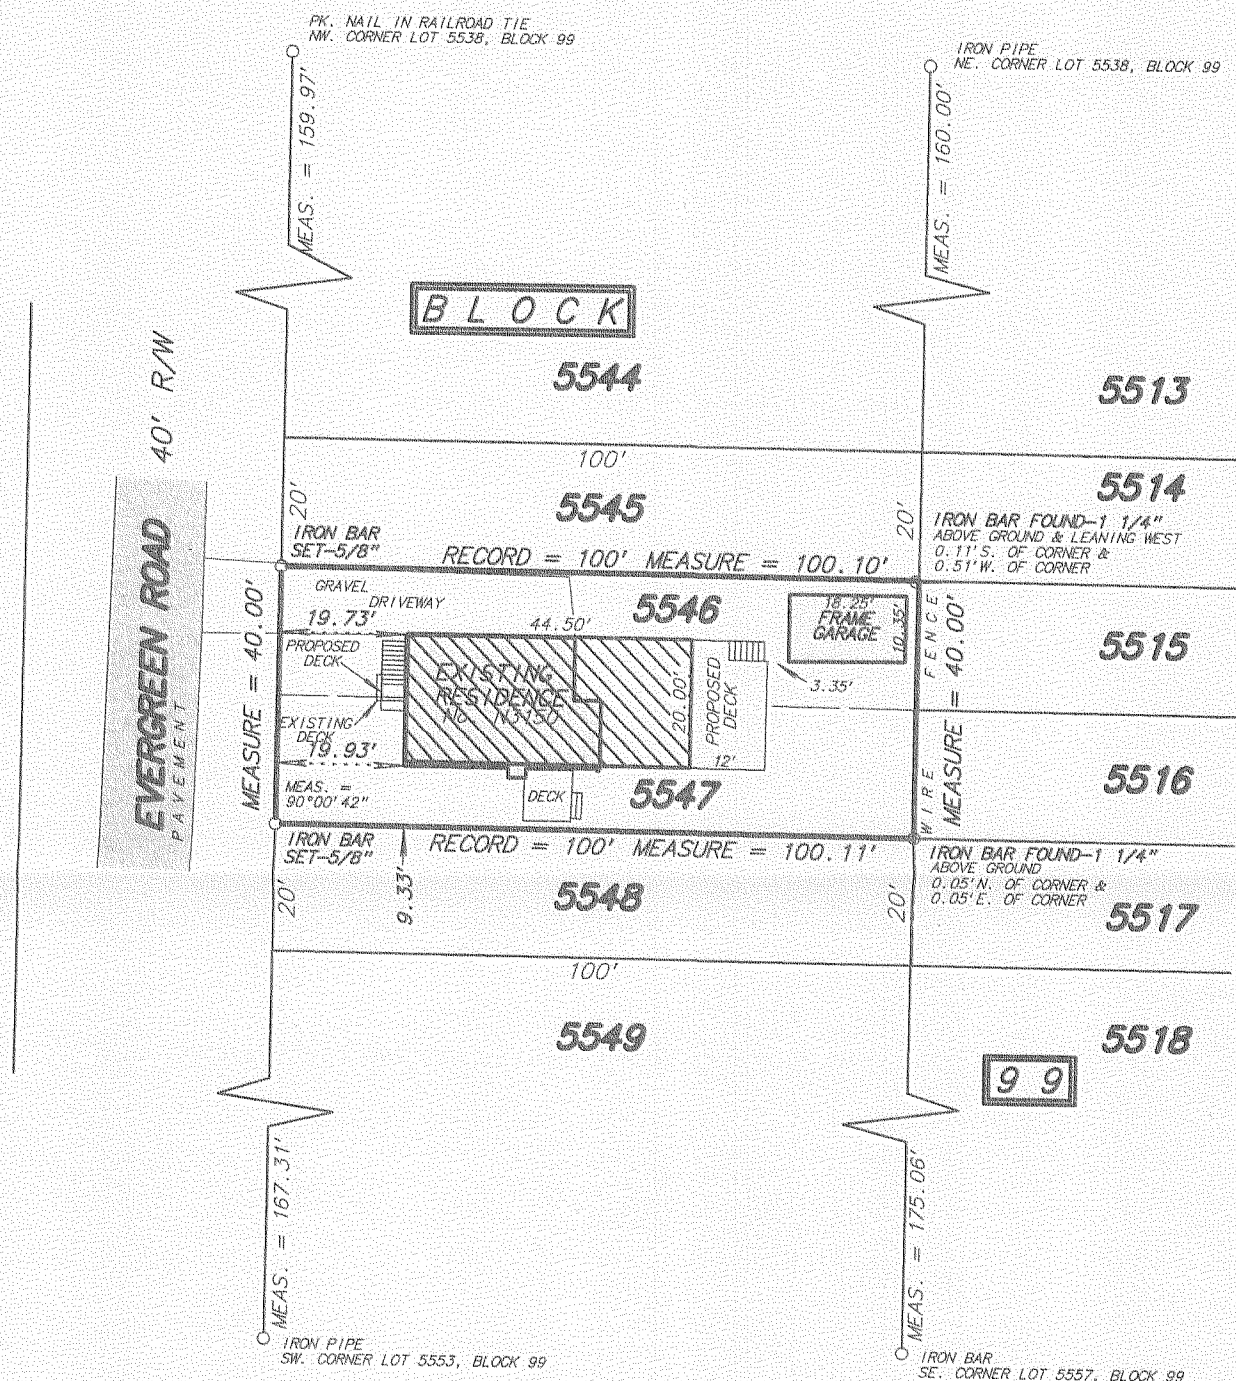

PROPOSED FOUNDATION FIELD STAKED TRUE SIZE.
CONTRACTOR TO VERIFY LOCATION AND DIMENSIONS PRIOR TO CONSTRUCTION.

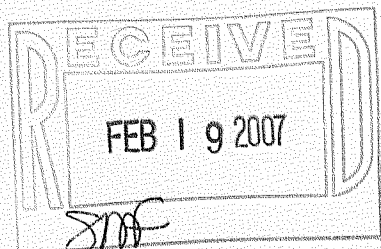

SCALE: 1 inch = 30 feet
ORDERED BY: D. Baugh / Dale Construction
JOB NO. 07006

Dated at Bassett, Wisconsin this _____ day of _____ 2007.

Mark A. Bolender
Wisconsin Registered Land Surveyor S - 1784

JLCB-1126

217-3369