


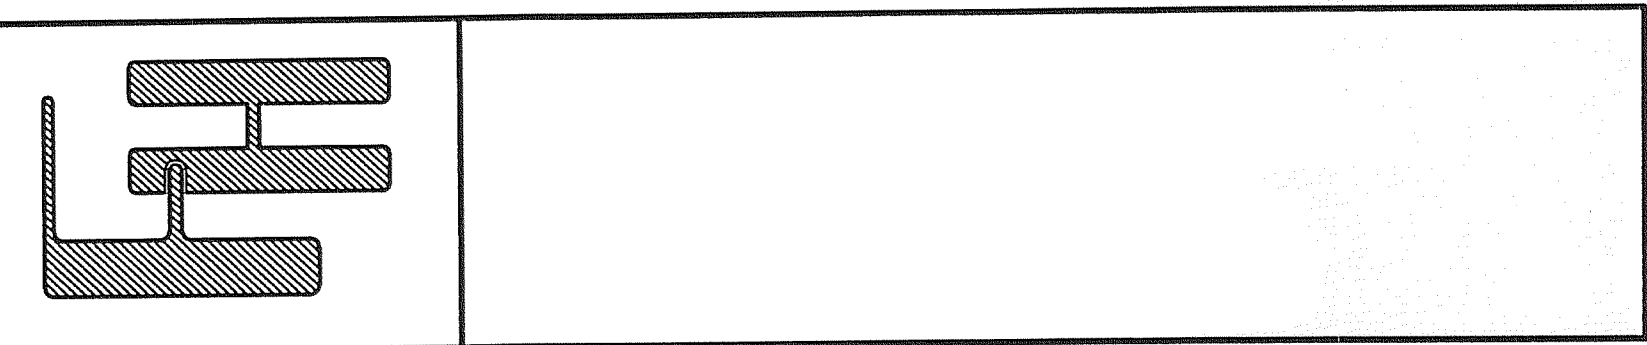

- WORK ORDERED BY -
SCOTT LOWELL
LOWELL MANAGEMENT SERVICES, INC.
P.O. BOX 926
LAKE GENEVA, WI 53147

FARRIS, HANSEN & ASSOCIATES, INC.
ENGINEERING - ARCHITECTURE - SURVEYING
7 RIDGWAY COURT P.O. BOX 437
ELKHORN, WISCONSIN 53121
OFFICE: (262) 723-2098 FAX: (262) 723-5886

REVISIONS	10/29/2008 - KD REVISIONS: FINANCE, AND EROSION CONTROL PLAN
-----------	---

PROJECT NO. 3269-10-06	DATE 10/05/2006	SHEET NO. 1 OF 1
---------------------------	--------------------	---------------------

PLAT OF SURVEY

UNIT 10-06


ONAL CONDOMINIUM

NO. 10

2 NORTH, RANGE 17

WALWORTH COUNTY, WISCONSIN

LEGEND

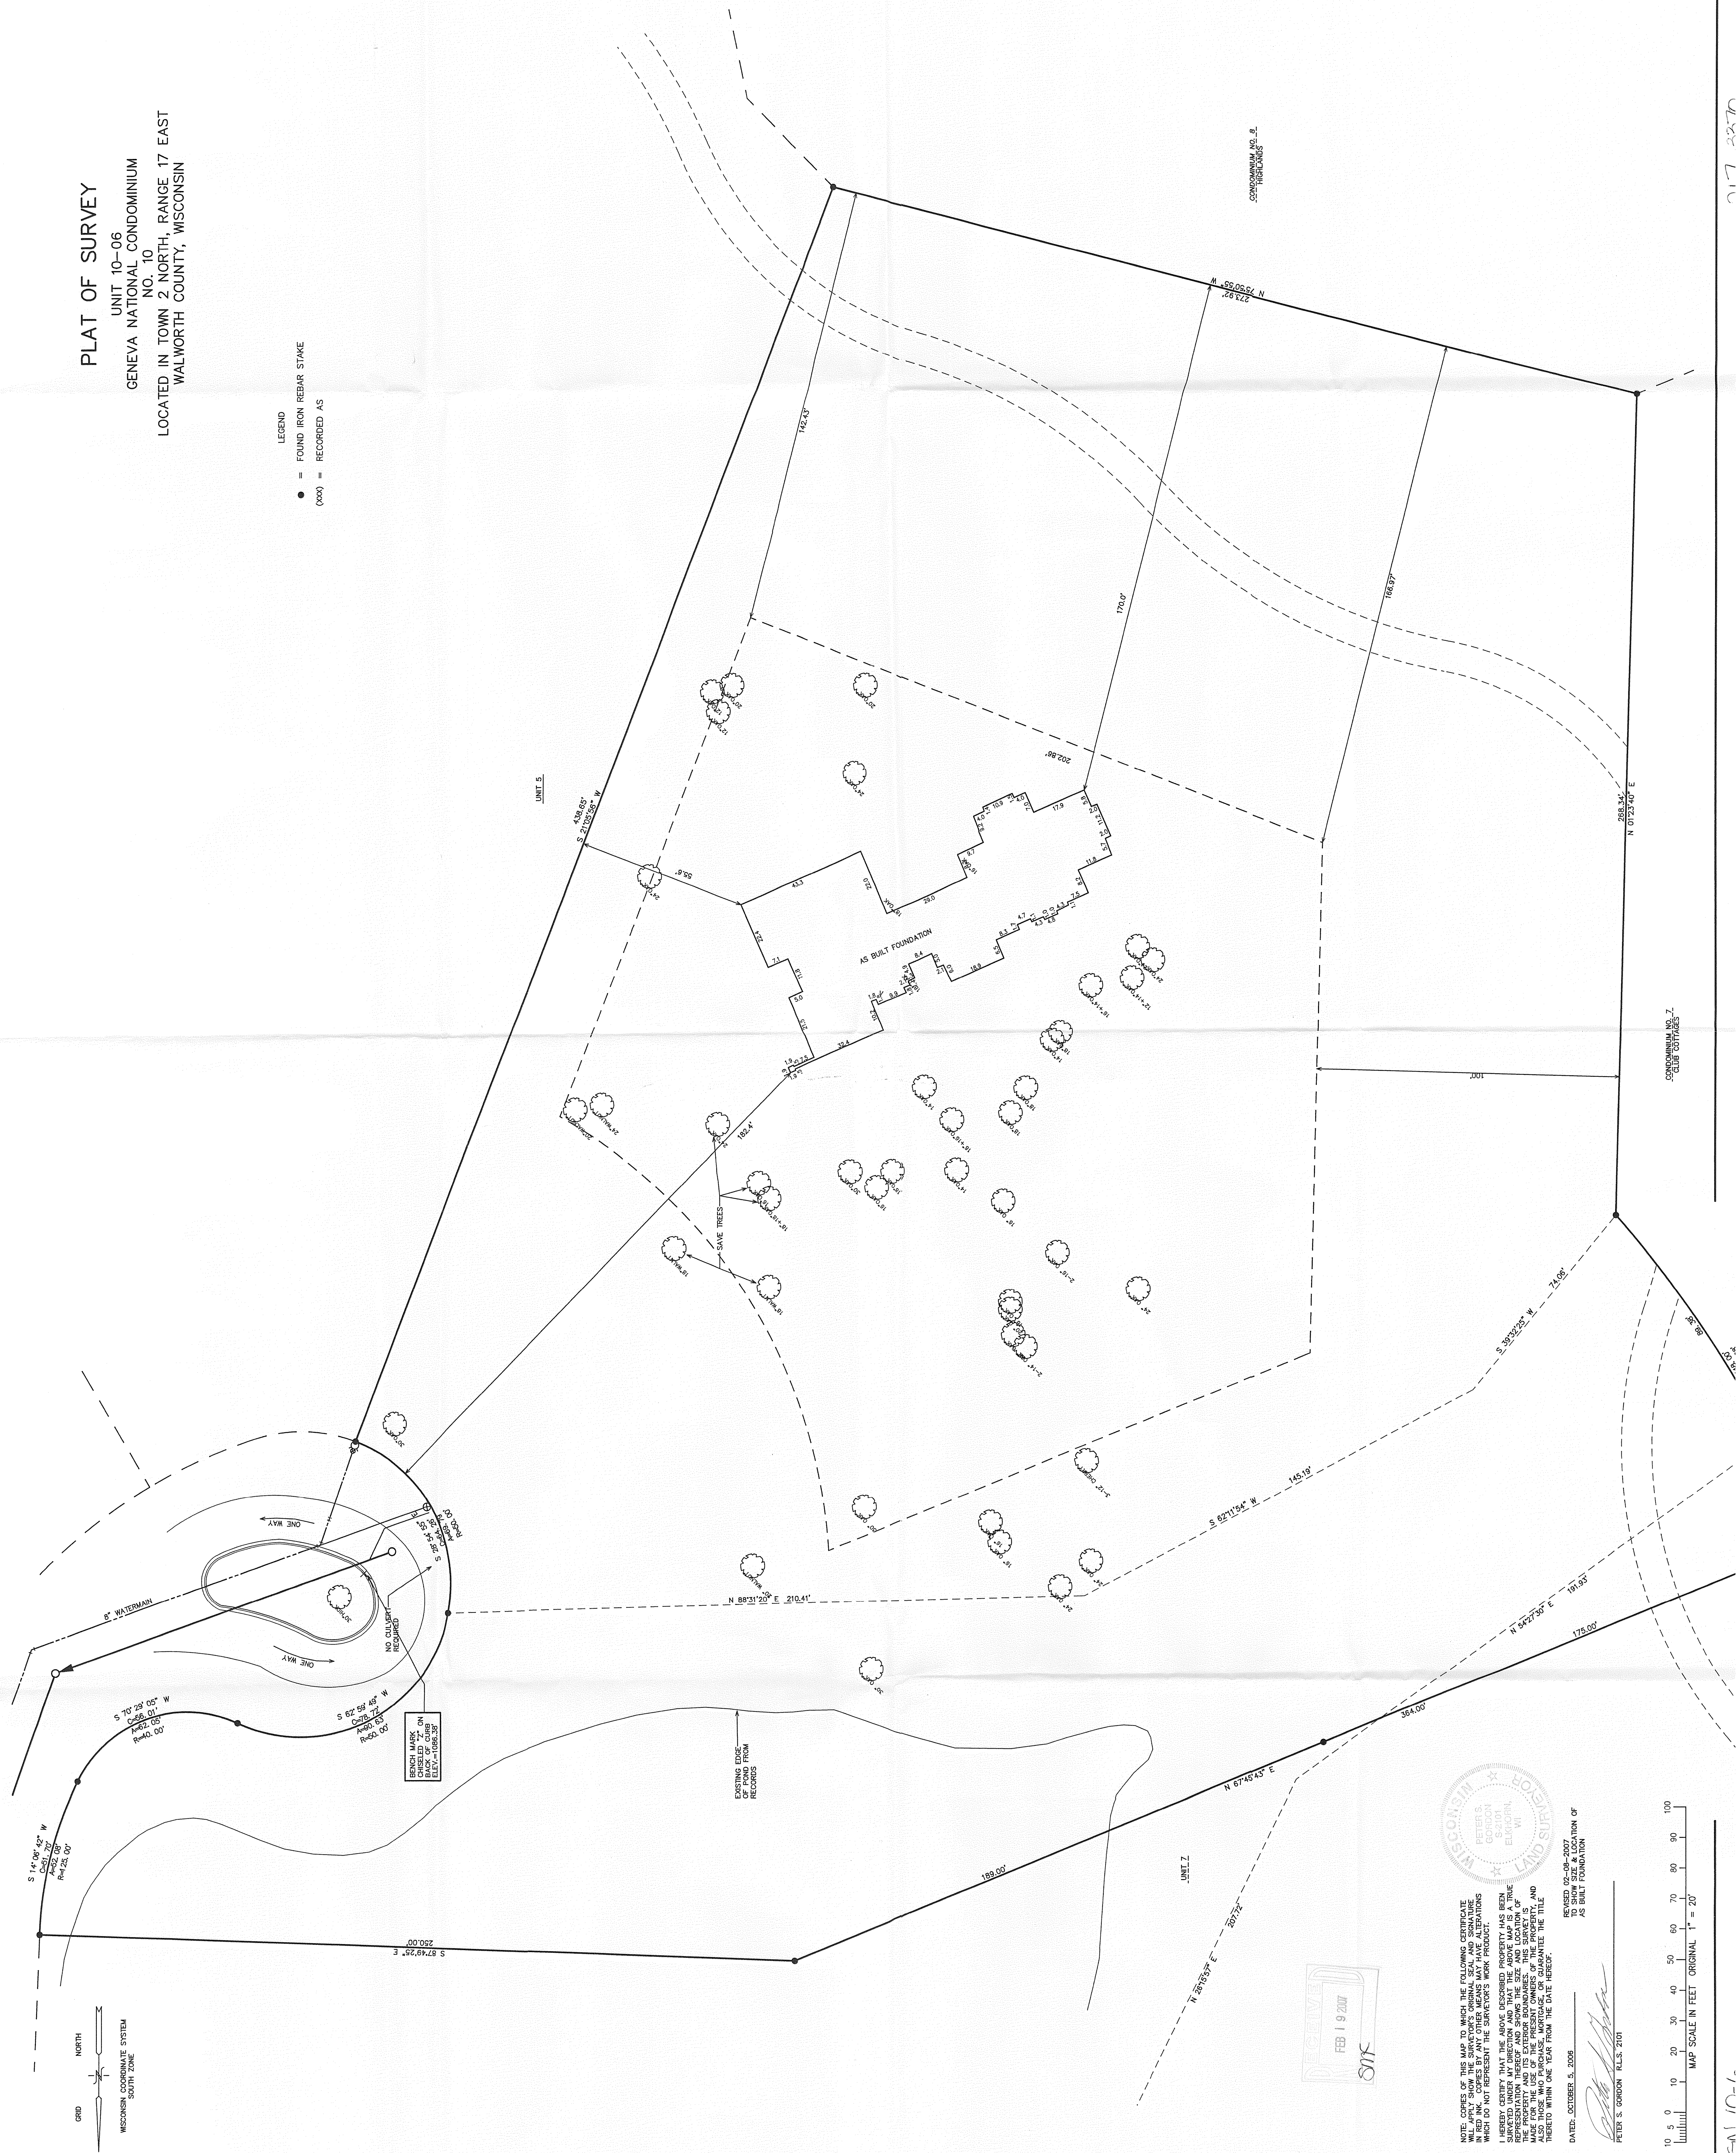

NOTE: COPIES OF THIS MAP TO WHICH THE FOLLOWING CERTIFICATE IS APPLIED, SHALL SHOW THE SURVEYOR'S ORIGINAL SEAL AND SIGNATURE IN RED INK. COPIES BY ANY OTHER MEANS MAY HAVE ALTERATIONS NOT REPRODUCED BY THIS SURVEYOR'S WORK PRODUCT.

REVISED 02-08-2007
TO SHOW SIZE & LOCATION OF
AS BUILT FOUNDATION

PETER S. GORDON R.L.S. 2101

PETER S. GORDON R.L.S. 2101

MAP SCALE IN FEET ORIGINAL 1" = 20'