


HAROLD H. KOLB

REGISTERED PROFESSIONAL LAND SURVEYOR
LAKE GENEVA, WISCONSIN




N

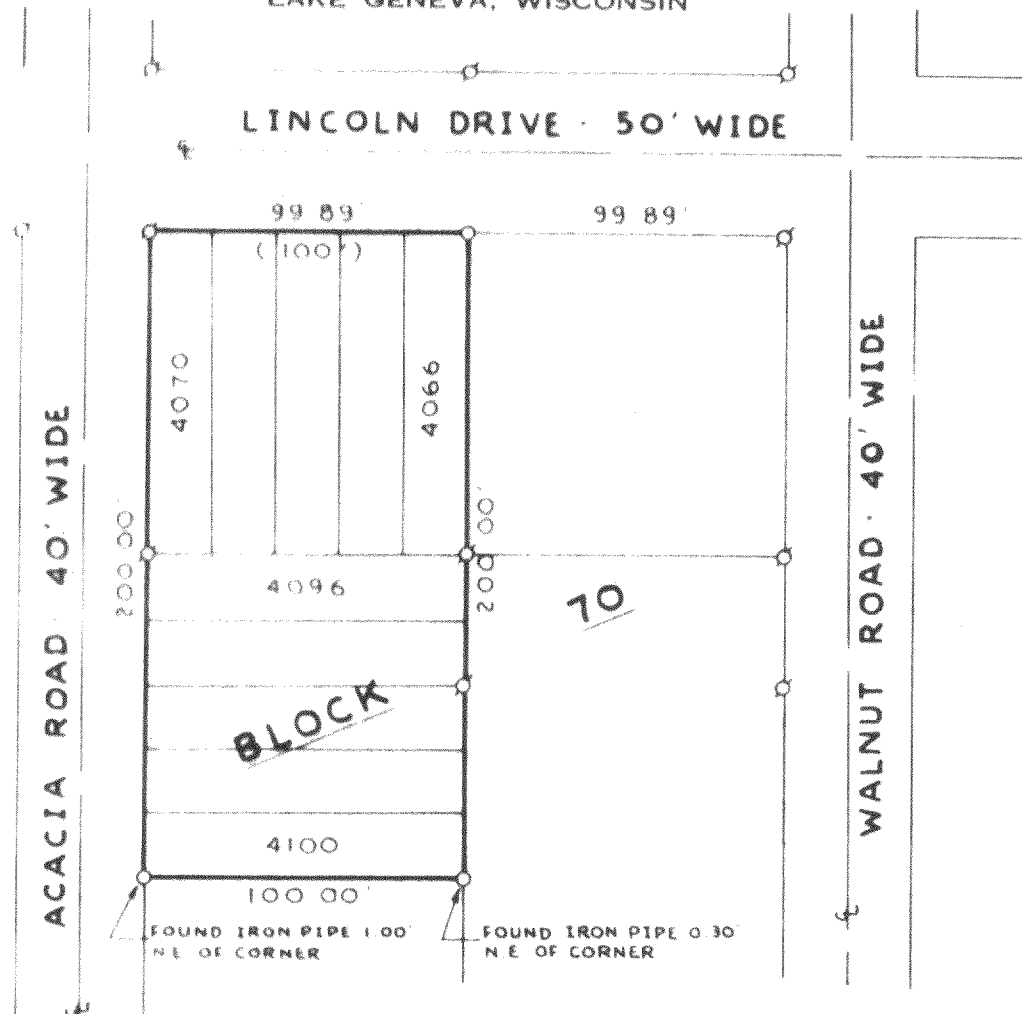

SCALE 1"=60'

LEGEND

- φ IRON PIPE FOUND
- IRON PIPE PLACED
- CONCRETE MONUMENT
- SPIKE

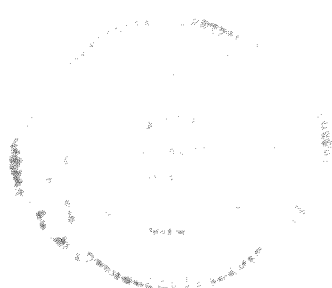

I, HAROLD H. KOLB, DO HEREBY CERTIFY THAT I HAVE SURVEYED THE PROPERTY HEREON DESCRIBED ACCORDING TO THE OFFICIAL RECORDS AND THAT THE PLAT HEREON IS A CORRECT REPRESENTATION OF THE SAME.

Harold H. Kolb
HAROLD H. KOLB
LAKE GENEVA, WISCONSIN
STATE OF WISCONSIN

217-343

JLCB-781, 787