



PLAT OF SURVEY

LOT 19 OF LAKE FOREST ESTATES

LOCATED IN PART OF THE NW 1/4, SW 1/4, AND SE 1/4 OF THE SW 1/4 OF SECTION 26, THE SE 1/4 AND NE 1/4 OF THE SE 1/4 OF SECTION 27, AND THE NE 1/4 OF THE NW 1/4 OF SECTION 35, TOWN 2 NORTH, RANGE 17 EAST, TOWN OF GENEVA, WALWORTH COUNTY, WISCONSIN

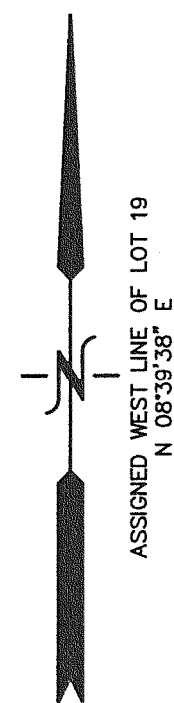

CURVE	ARC	RADIUS	CHORD LENGTH	CHORD BEARING
C1	24.78'	363.00'	24.77'	N 32°36'42\" W
(C1)	24.78'	363.00'	24.77'	N 32°32'41\" W

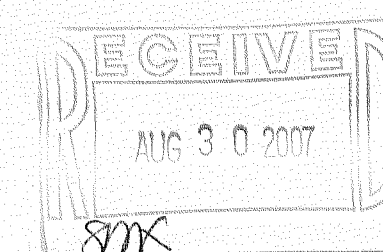


FARRIS, HANSEN & ASSOCIATES, INC.
ENGINEERING - ARCHITECTURE - SURVEYING
7 RIDGWAY COURT P.O. BOX 437
ELKHORN, WISCONSIN 53121
OFFICE: (262) 723-2098 FAX: (262) 723-5886

REVISIONS
5/02/2007-KB
SITE, GRADING,
DRAINAGE, AND
EROSION CONTROL
PLAN


PROJECT NO.
4176.19.05

DATE
10/10/05

SHEET NO.
1 OF 1

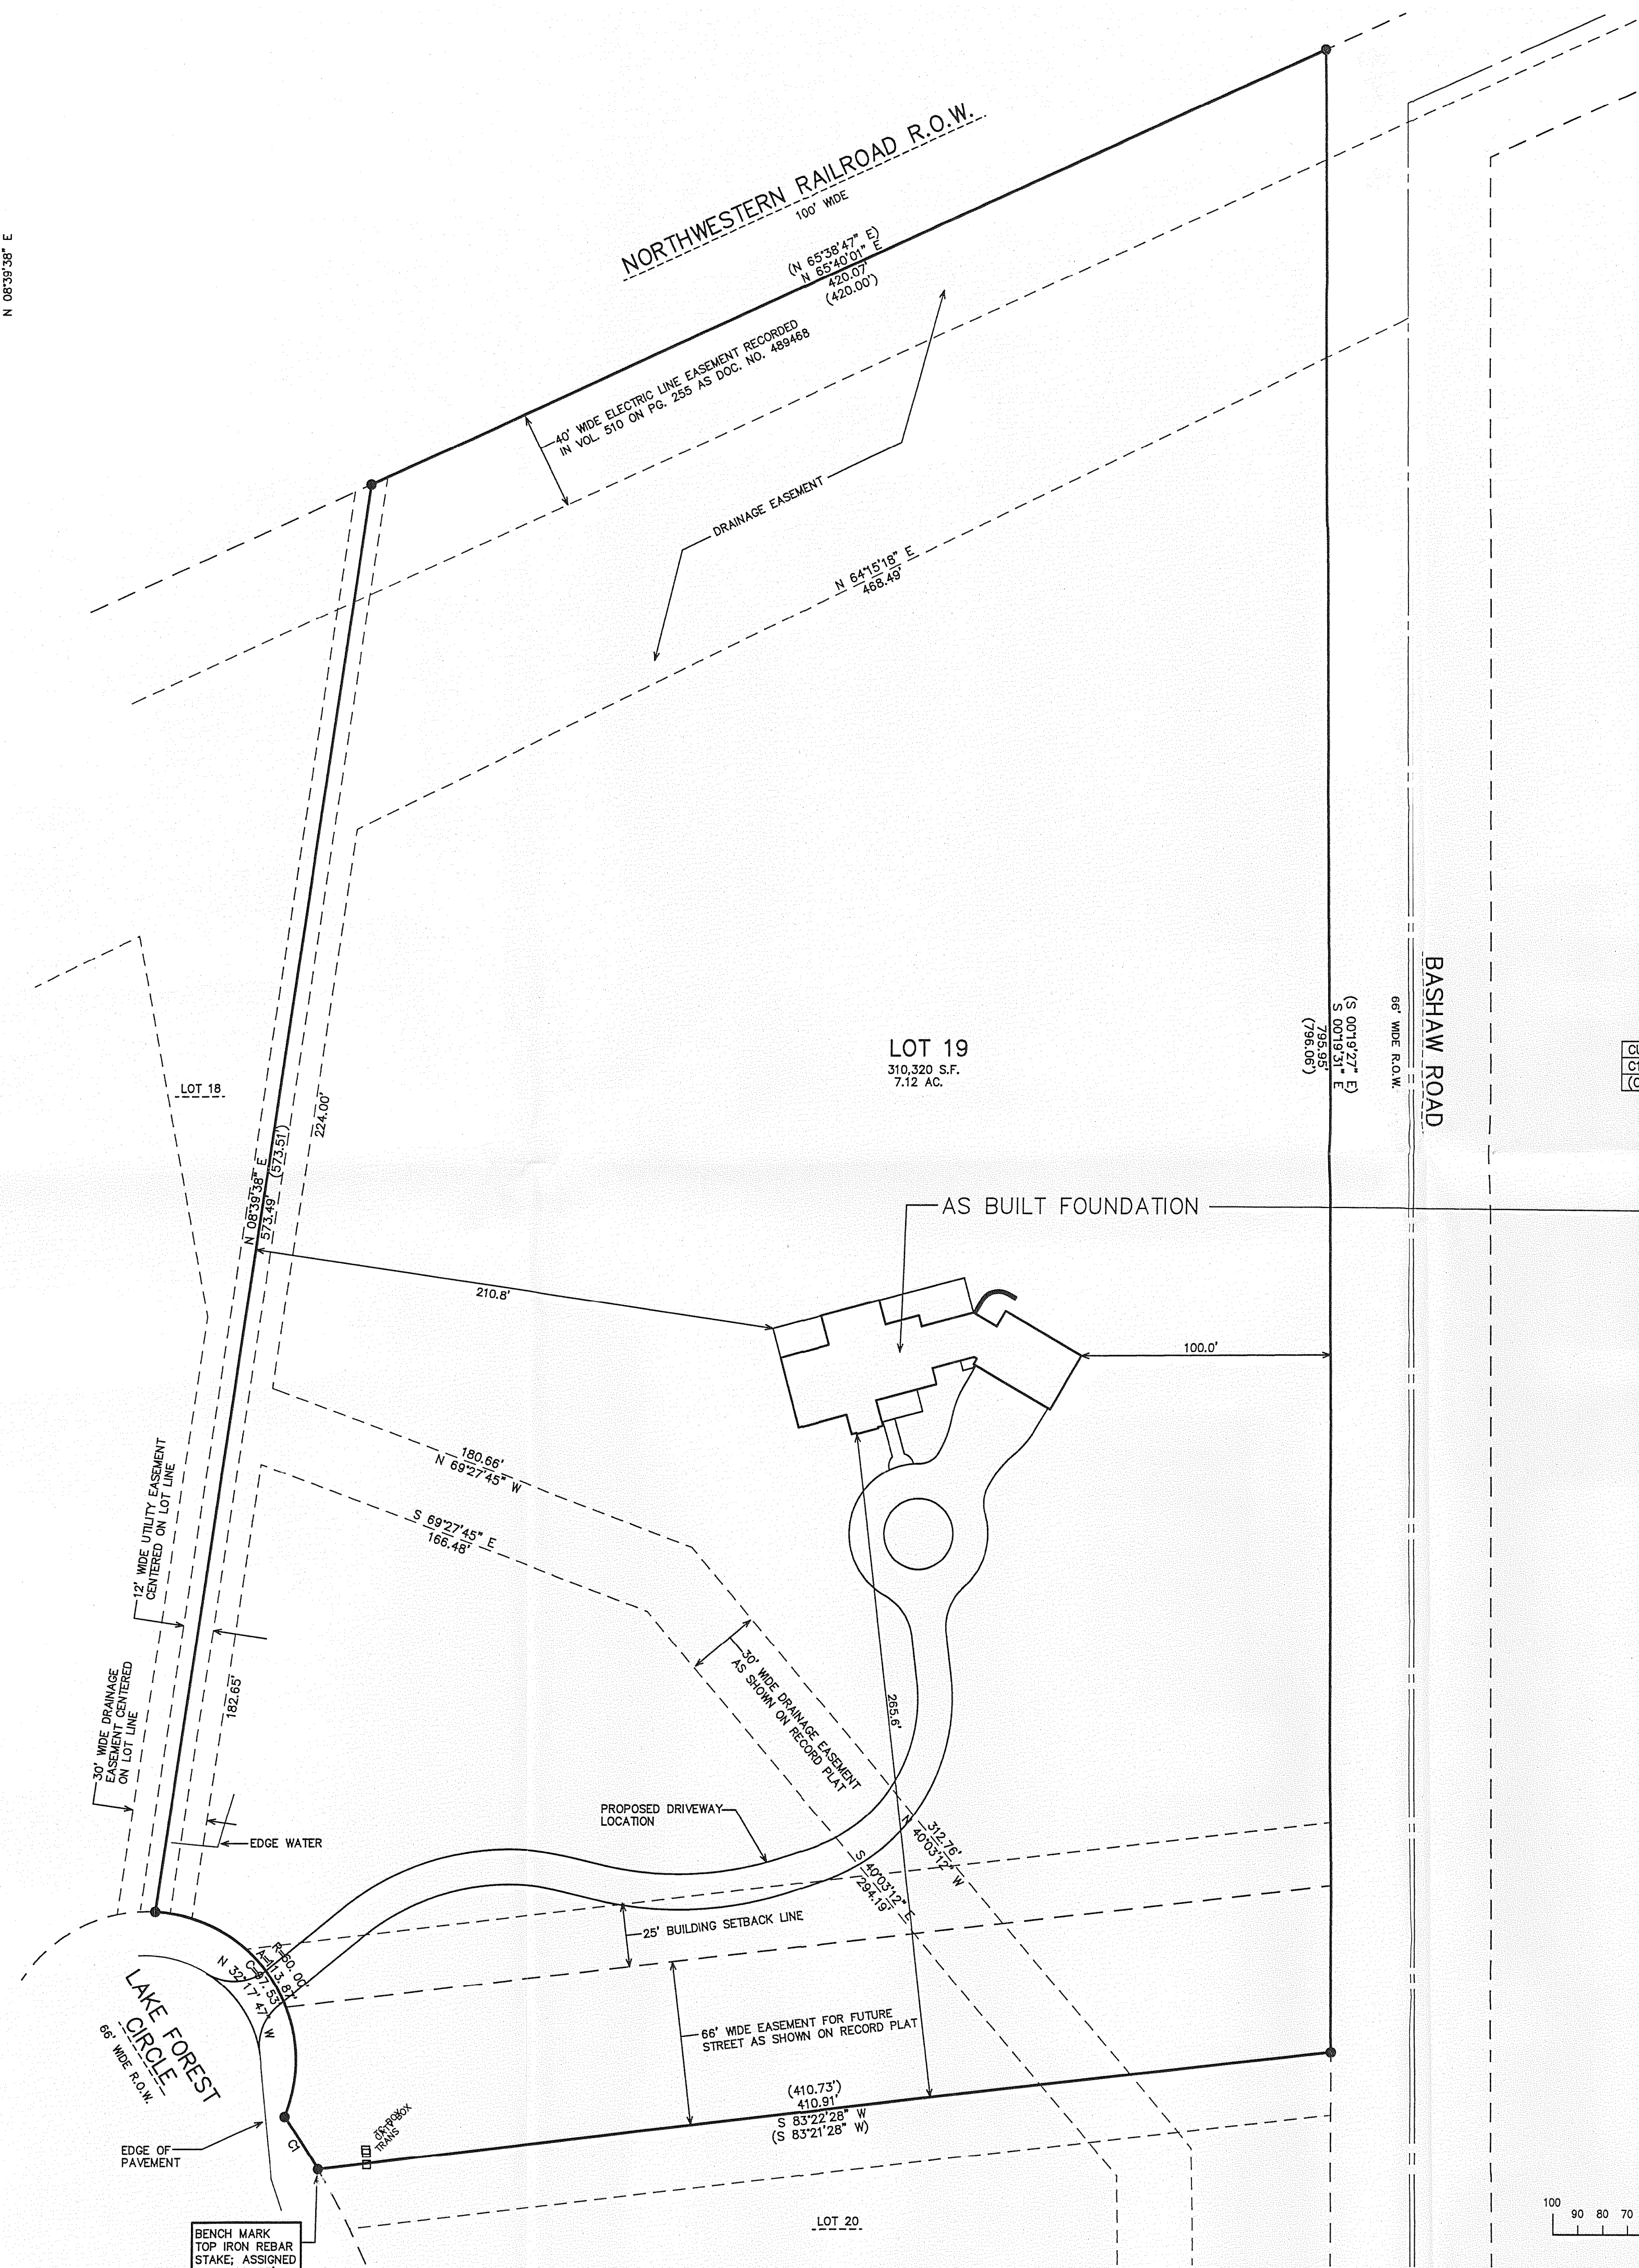

LEGEND
● = FOUND IRON REBAR STAKE
(XXX) = RECORDED AS

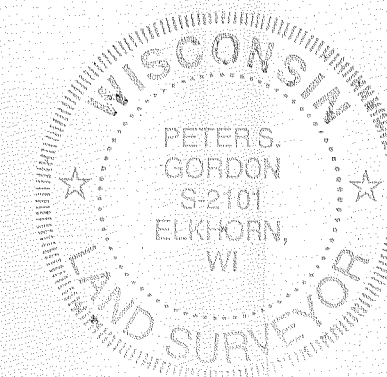

REVISED 08-06-2007
TO SHOW SIZE & LOCATION OF
AS BUILT FOUNDATION

MAP SCALE IN FEET ORIGINAL 1" = 40'

NOTES: COPIES OF THIS MAP TO WHICH THE FOLLOWING CERTIFICATE WILL APPLY SHOW THE SURVEYOR'S ORIGINAL SEAL AND SIGNATURE IN RED INK. COPIES BY ANY OTHER MEANS MAY HAVE ALTERATIONS WHICH DO NOT REPRESENT THE SURVEYOR'S WORK PRODUCT.

I HEREBY CERTIFY THAT THE ABOVE DESCRIBED PROPERTY HAS BEEN SURVEYED UNDER MY DIRECTION AND THAT THE ABOVE MAP IS A TRUE REPRESENTATION THEREOF AND SHOWS THE SIZE AND LOCATION OF THE PROPERTY AND ITS EXTERIOR BOUNDARIES. THIS SURVEY IS MADE FOR THE USE OF THE PRESENT OWNERS OF THE PROPERTY, AND ALSO THOSE WHO PURCHASE, MORTGAGE, OR GUARANTEE THE TITLE THERETO WITHIN ONE YEAR FROM THE DATE HEREOF.

DATED: 11-8-1995
ADD TOPO 11-13-2005
01-30-2006
ADD. TOPO & SOIL BORINGS

PETER S. GORDON R.L.S. 2101

217-3431