

PREPARED FOR
DIANE KRAUSE
SHOREWEST REALTORS
623 MAIN ST.
LAKE GENEVA WI. 53147

PATHFINDER SURVEYING INC.
W2888 KRUEGER RD. UNIT "D"
LAKE GENEVA WI. 53147
(262) 248-3697

C.L. WASHINGTON DRIVE

(40' WIDE)

(N 89°39'56" W 200.00')
N 89°39'56" W 200.15'

C.L. PINE ROAD
PARTIALLY UNIMPROVED
(40' WIDE)

(S 00°20'04" W 100.00')
S 00°19'55" W 100.15'

LOT 1764

BLOCK 29

LOT 1755

N 00°21'37" E 100.01'
(N 00°20'04" E 100.00')

C.L. OAK DRIVE
PARTIALLY UNIMPROVED
(40' WIDE)

FENCE IS 7.5' NORTH OF LINE

100.09'

S 89°42'23" E 200.10'
(S 89°39'56" E 200.00')

100.01'

PLAT OF SURVEY


- OF -

LOTS 1755 THRU 1764, BLOCK 29, LAKE COMO BEACH
SUBDIVISION LOCATED IN TOWN 2 NORTH, RANGE 17 EAST,
WALWORTH COUNTY, WISCONSIN.

COMPARE LEGAL DESCRIPTION ABOVE AND DRAWING WITH DEED. FOR BUILDING RESTRICTIONS AND
EASEMENTS NOT SHOWN, REFER TO DEED, ABSTRACT SOURCES AND LOCAL MUNICIPAL CODES. NOTIFY
THE SURVEYOR IMMEDIATELY OF ANY DISCREPANCY.

"I hereby certify that I have surveyed the above described property and that
the above map, to the best of my knowledge and belief, is a true representation
thereof and shows the size and location of all visible structures, apparent
easements and encroachments if any."

This survey is made for the present owners of the property, and those who
purchase, mortgage, or guarantee the title thereto, within one year from
the date hereof.

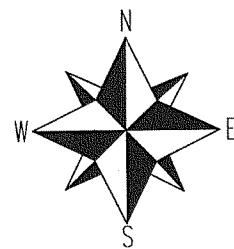

() = recorded as

□ = found iron bar



○ = found iron pipe

■ = set iron bar

SCALE 1" = 20'

JOB # 07-347

TAX ID # JLCB00282

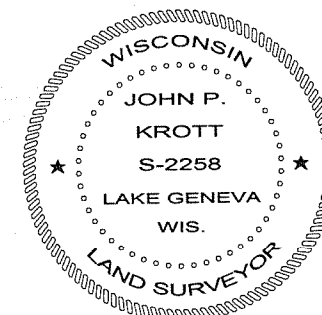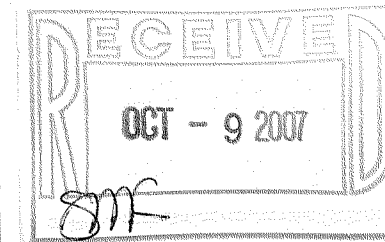

JOHN KROTT S - 2258
Wisconsin Registered Land Surveyor
(original if signed in red)

DATED THIS THE 8th DAY OF AUGUST 2007.

217 - 3440