



PLAT OF SURVEY

UNIT 26-10
GENEVA NATIONAL CONDOMINIUM
NO. 26

LOCATED IN TOWN 2 NORTH, RANGE 17 EAST
WALWORTH COUNTY, WISCONSIN

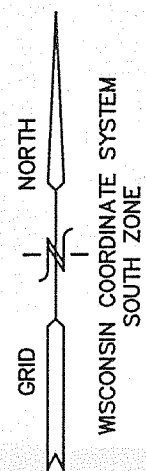

- = FOUND IRON REBAR STAKE
- (xxx) = RECORDED AS
- c.o. = CLEANOUT
- ⊕ c.v. = CURB VALVE
- ⊗ = HYDRANT
- ⊗ = WATER VALVE

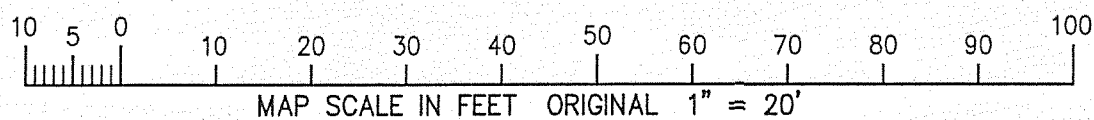


GOLF CLUB GROUNDS

UNIT 26-10
22,788 S.F.

UNIT 26-11

AS BUILT
FOUNDATION
TOF = 898.23'

NOTE: ADJOINING LOTS NOT DEVELOPED
AND OWNED BY BUILDER.

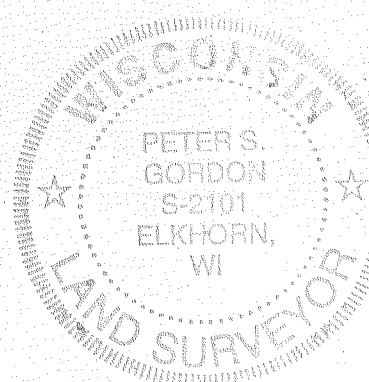

NOTE: COPIES OF THIS MAP TO WHICH THE FOLLOWING CERTIFICATE WILL APPLY SHOW
THE SURVEYOR'S ORIGINAL SEAL AND SIGNATURE IN RED INK. COPIES BY ANY OTHER
MEANS MAY HAVE ALTERATIONS WHICH DO NOT REPRESENT THE SURVEYOR'S WORK
PRODUCT.



I HEREBY CERTIFY THAT THE ABOVE DESCRIBED PROPERTY HAS BEEN SURVEYED UNDER
MY DIRECTION AND THAT THE ABOVE MAP IS A TRUE REPRESENTATION THEREOF AND
SHOWS THE SIZE AND LOCATION OF THE PROPERTY, ITS EXTERIOR BOUNDARIES, THE
LOCATION OF ALL VISIBLE STRUCTURES, AND DIMENSIONS OF ALL PRINCIPLE
BUILDINGS THEREON, BOUNDARY FENCES, APPARENT EASEMENTS, ROADWAYS, AND
VISIBLE ENCROACHMENTS, IF ANY. THIS SURVEY IS MADE FOR THE USE OF THE
PRESENT OWNERS OF THE PROPERTY, AND ALSO THOSE WHO PURCHASE, MORTGAGE, OR
GUARANTEE THE TITLE THERETO WITHIN ONE YEAR FROM THE DATE HEREOF.

DATED: NOVEMBER 23, 2005

PETER S. GORDON

REVISED 10-17-2007
TO SHOW SIZE & LOCATION OF
AS BUILT FOUNDATION

SAVANNA COURT
50' WIDE PRIVATE R.O.W.

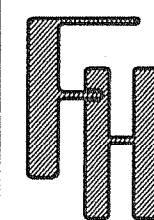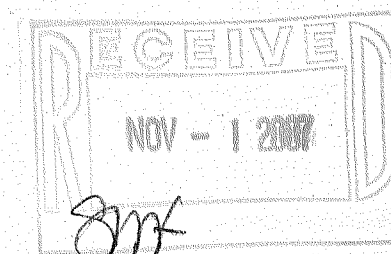

THE MARTIN RESIDENCE
THE SAVANNAH
UNIT 26-10

WORK ORDERED BY -
SCOTT LOWELL - LOWELL MANAGEMENT
P.O. BOX 926
LAKE GENEVA, WI 53147

FARRIS, HANSEN & ASSOCIATES, INC.
Engineering, Architecture, Surveying
7 Ridgeway Court P.O. Box 437
ELKHORN, WISCONSIN 53121
Office: (262) 723-2098
Fax: (262) 723-5886

REVISIONS
09-18-2006
UPDATE
7/20/2007-KB
SITE, GRADING,
DRAINAGE, &
EROSION
CONTROL PLAN
7/23/2007-LK
REVISE DRIVE

PROJECT NO.
3269.26.10
DATE:
11/23/05
SHEET NO.
1 OF 1

X:\Projects\3269\CONDO_26\INDV.LOTS\UNIT_10ASBUILT
10/17/2007

JGN 26-10

217-3457