





FARRIS, HANSEN & ASSOCIATES, INC.

ENGINEERING - ARCHITECTURE - SURVEYING  
7 RIDGWAY COURT - P.O. BOX 437 - ELKHORN, WISCONSIN 53121  
PHONE: (262) 723-2098 FAX: (262) 723-5886

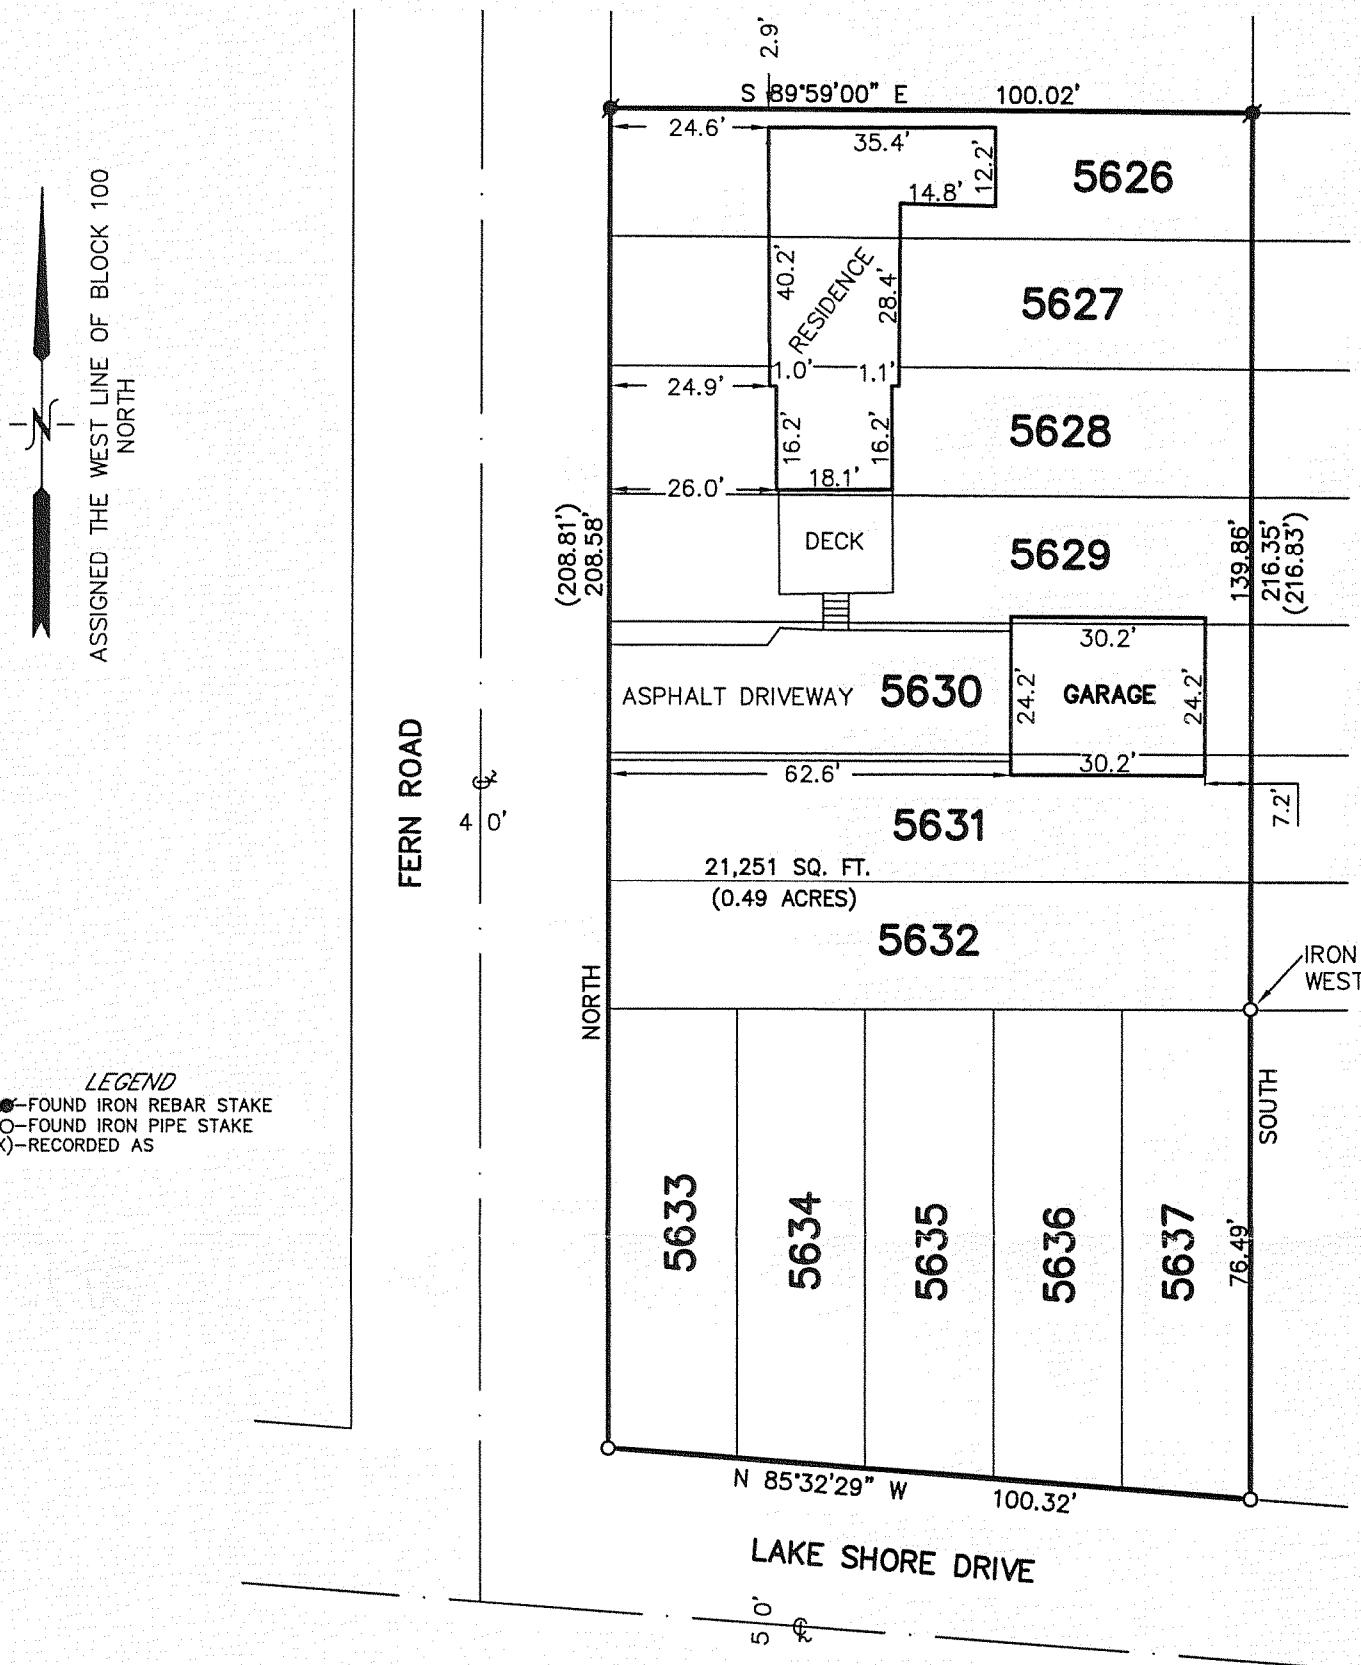


PLAT OF SURVEY OF

LOTS 5626-5637, BLOCK 100 OF LAKE COMO BEACH  
 SUBDIVISION, LOCATED IN PART OF THE NE 1/4 OF SECTION 28,  
 T 2 N, R 17 E, WALWORTH COUNTY, WISCONSIN.

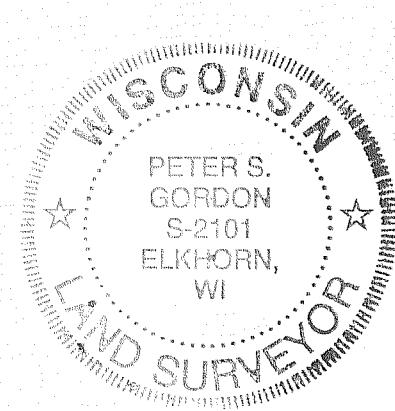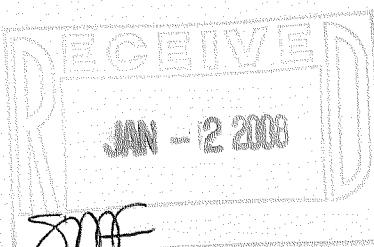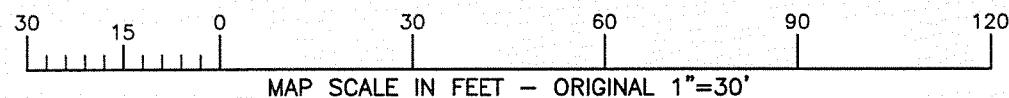

NOTE: COPIES OF THIS MAP TO WHICH THE FOLLOWING CERTIFICATE  
 WILL APPLY SHOW THE SURVEYOR'S ORIGINAL SEAL AND SIGNATURE  
 IN RED INK. COPIES BY ANY OTHER MEANS MAY HAVE ALTERATIONS  
 WHICH DO NOT REPRESENT THE SURVEYOR'S WORK PRODUCT. I  
 HEREBY CERTIFY THAT THE ABOVE DESCRIBED PROPERTY HAS BEEN  
 SURVEYED UNDER MY DIRECTION AND THAT THE ABOVE MAP IS A  
 TRUE REPRESENTATION THEREOF AND SHOWS THE SIZE AND LOCATION  
 OF THE PROPERTY AND ITS EXTERIOR BOUNDARIES. THIS SURVEY IS  
 MADE FOR THE USE OF THE PRESENT OWNERS OF THE PROPERTY,  
 AND ALSO THOSE WHO PURCHASE, MORTGAGE, OR GUARANTEE THE  
 TITLE THERETO WITHIN ONE YEAR FROM THE DATE HEREOF.

DATED: 11/02/2007

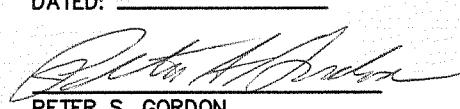  
 PETER S. GORDON

PROJECT: 7489  
 DATE: 11/02/2007  
 SHEET 1 OF 1

JLCB-1145  
 NOV 13 2007

217-34100