

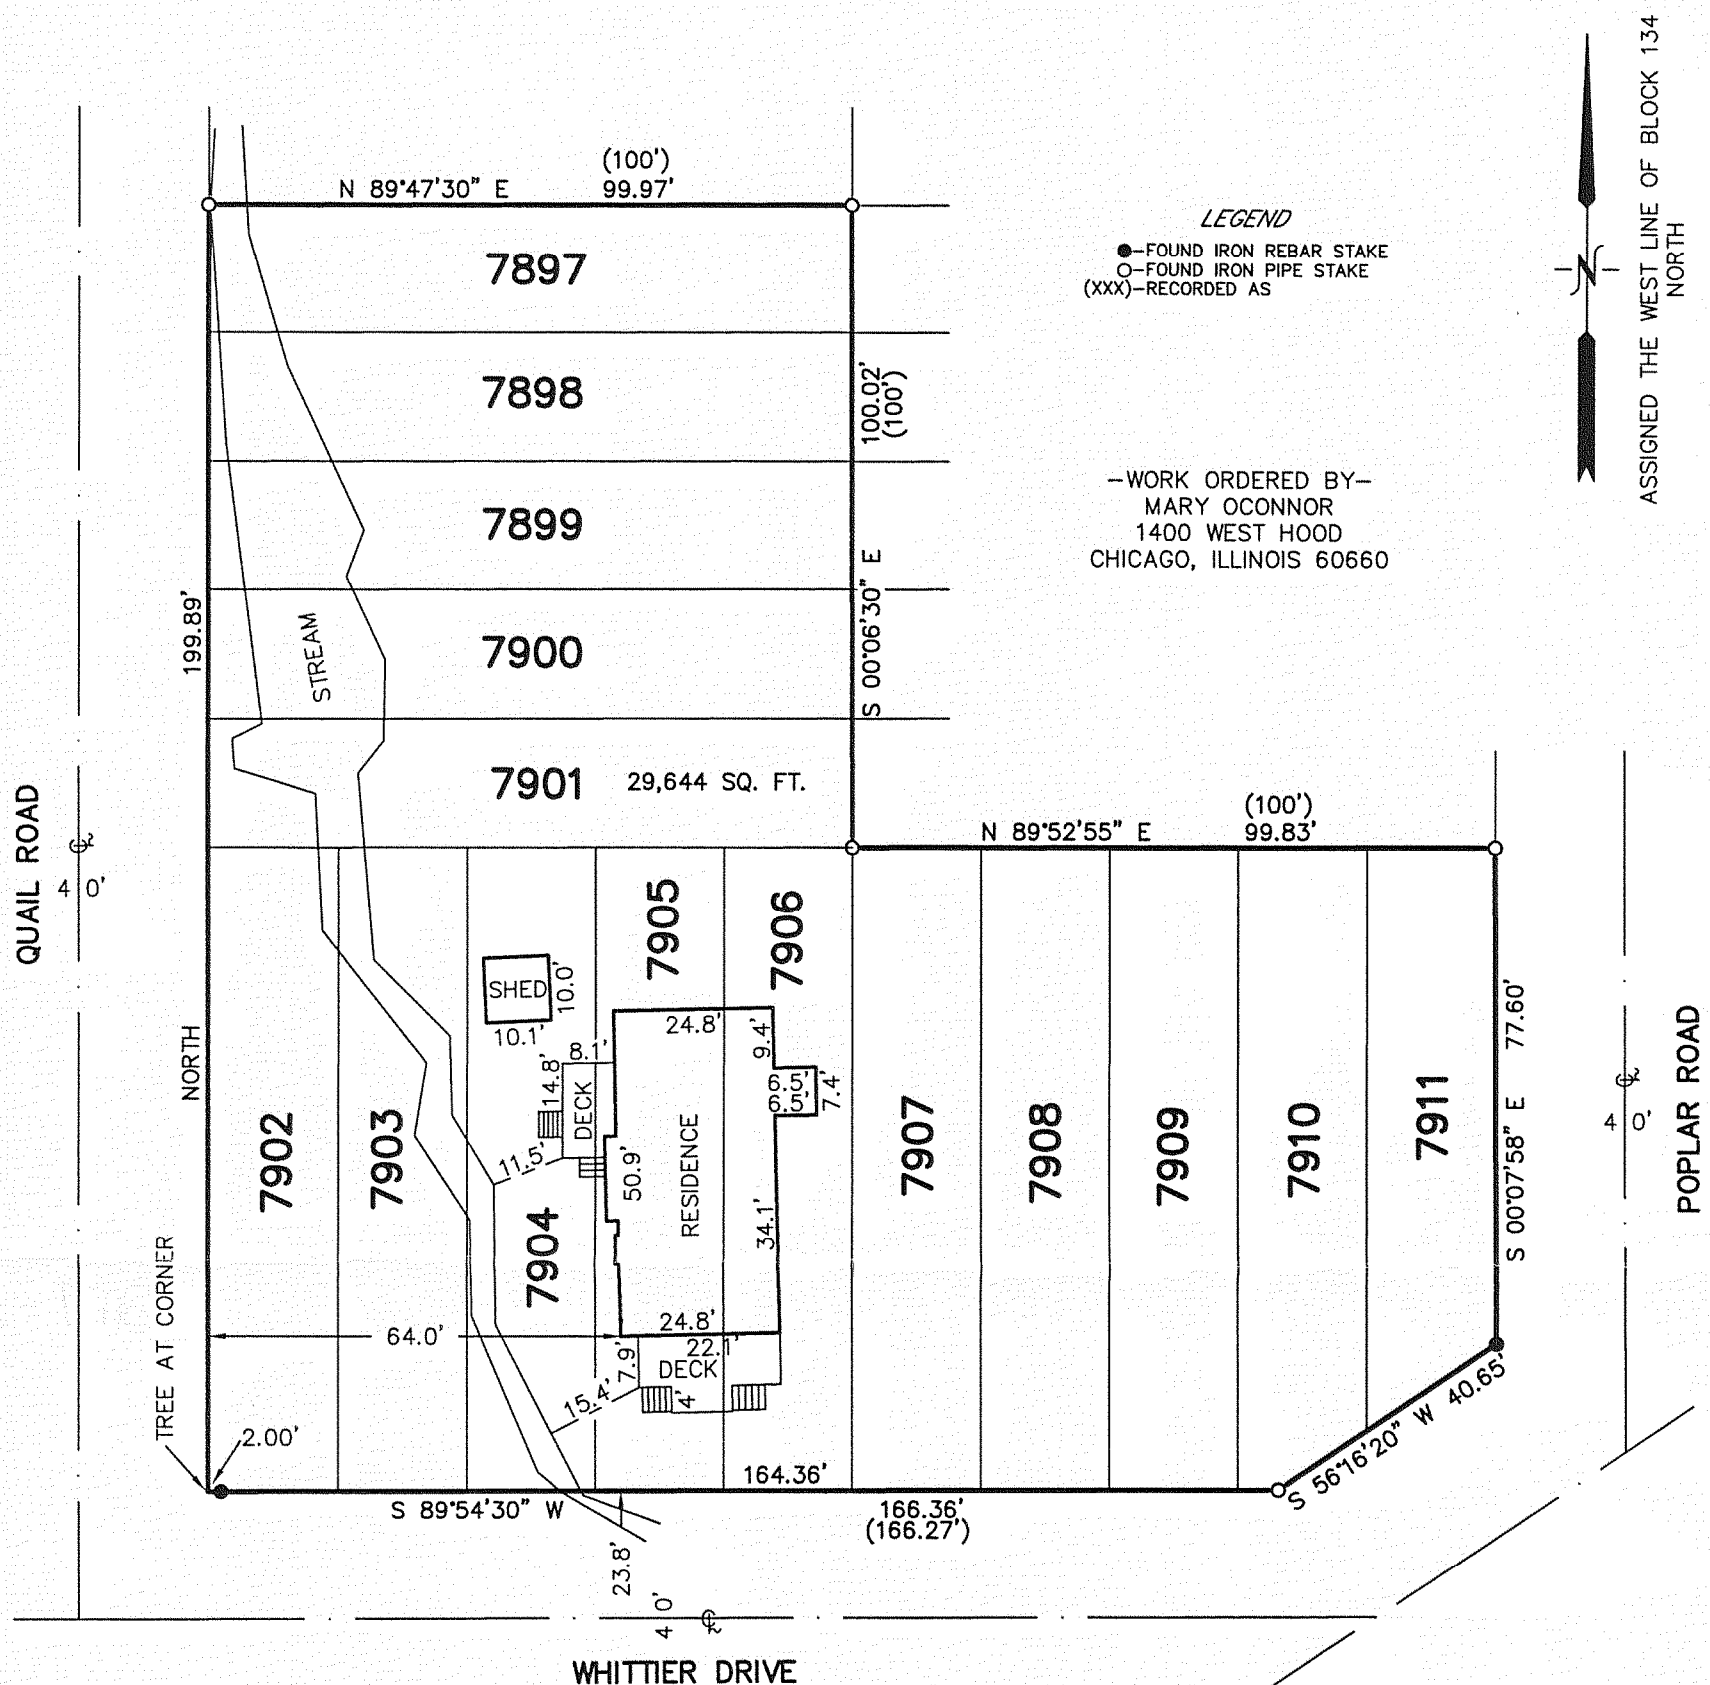


FARRIS, HANSEN & ASSOCIATES, INC.
 ENGINEERING - ARCHITECTURE - SURVEYING
 7 RIDGWAY COURT - P.O. BOX 437 - ELKHORN, WISCONSIN 53121
 PHONE: (262) 723-2098 FAX: (262) 723-5886

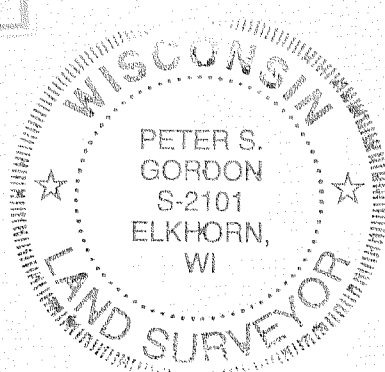

PLAT OF SURVEY OF
 LOTS 7897-7911 OF BLOCK 134 OF LAKE
 COMO BEACH, A SUBDIVISION, LOCATED IN
 PART OF THE NW 1/4 AND SW 1/4 OF
 SECTION 28, TOWN 2 NORTH, RANGE 17 EAST,
 WALWORTH COUNTY, WISCONSIN

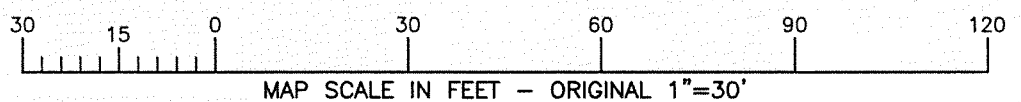

NOTE: COPIES OF THIS MAP TO WHICH THE FOLLOWING CERTIFICATE
 WILL APPLY SHOW THE SURVEYOR'S ORIGINAL SEAL AND SIGNATURE IN
 RED INK. COPIES BY ANY OTHER MEANS MAY HAVE ALTERATIONS
 WHICH DO NOT REPRESENT THE SURVEYOR'S WORK PRODUCT. I HEREBY
 CERTIFY THAT THE ABOVE DESCRIBED PROPERTY HAS BEEN SURVEYED
 UNDER MY DIRECTION AND THAT THE ABOVE MAP IS A TRUE
 REPRESENTATION THEREOF AND SHOWS THE SIZE AND LOCATION OF
 THE PROPERTY AND ITS EXTERIOR BOUNDARIES. THIS SURVEY IS MADE
 FOR THE USE OF THE PRESENT OWNERS OF THE PROPERTY, AND ALSO
 THOSE WHO PURCHASE, MORTGAGE, OR GUARANTEE THE TITLE THERETO
 WITHIN ONE YEAR FROM THE DATE HEREOF.

DATED: 1/21/2008

Peter S. Gordon
 PETER S. GORDON

PROJECT: 7508
 DATE: 01/21/2008
 SHEET 1 OF 1

JLCB-1682

217-3479