

found iron pipe at
0.2' east of property corner

Walnut Road

meas 119.8'

rec 20'

rec 20'

rec 160'

Lot 3857
Lot 3858

Lot 3858
Lot 3859

Lot 3859
Lot 3860

Lot 3860
Lot 3861

Lot 3861
Lot 3862

Lot 3862
Lot 3863

Lot 3863
Lot 3864

Lot 3864
Lot 3865

100'

100'

Lot 3830
Lot 3831

Lot 3831
Lot 3832

Lot 3832
Lot 3833

Lot 3833
Lot 3834

Lot 3834
Lot 3835

Lot 3835
Lot 3836

Lot 3836
Lot 3837

Lot 3837
Lot 3838

rec 20'

rec 20'

meas 119.8'

found iron pipe at
0.2' south of property corner

tax key no.: JLCB 00736

Refer to a current title report for a complete legal description and for any easements or restrictions which may affect this site; specifically those not shown on the recorded subdivision plat.


MARESCALCO COUNTYWIDE SURVEYING, INC.
1120 80TH STREET KENOSHA, WI 53143
(262) 654 6809 FAX (262) 654 1120

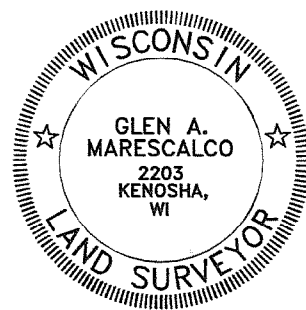

I hereby certify that this property was surveyed under my direction. This plat is a true representation thereof.

Reg. Land Surveyor
July 5, 2007

Scale
1" = 20'

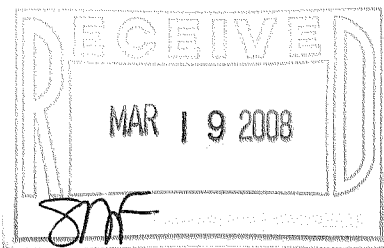

denotes iron pipe
marker found
(unless noted)

Lincoln Drive

Plat of Survey of
LOTS 3859 THRU 3864 BLOCK 66
SECOND MAP OF LAKE COMO BEACH

in NW1/4 Section 27-2-17

TOWN OF GENEVA
WALWORTH COUNTY, WIS.

-ordered by-
Mario Barratti

JLCB-736

217-3480