

LAND-MARK SURVEYING

Mark L. Miritz



Wisconsin Registered Land Surveyor S-2582

N9330 Knuteson Drive
Whitewater, WI 53190
Phone: (262) 495-3284
FAX: (262) 495-8421
LAND-MARKSURVEYING.COM



PLAT OF SURVEY

LOTS 5769 THROUGH 5775 INCLUSIVE, BLOCK 102, FIRST MAP OF LAKE COMO BEACH SUBDIVISION, LOCATED IN SECTIONS 21 AND 28, TOWN 2 NORTH, RANGE 17 EAST, GENEVA TOWNSHIP, WALWORTH COUNTY, WISCONSIN.

OWNERS: GENE L. DECKER
JUDITH A. DECKER
N3072 BEGONIA ROAD
LAKE GENEVA, WI. 53147

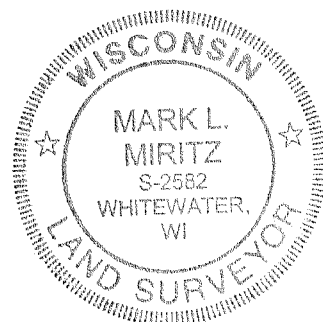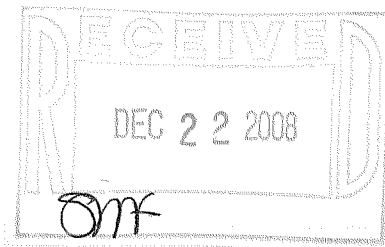

HICKORY ROAD

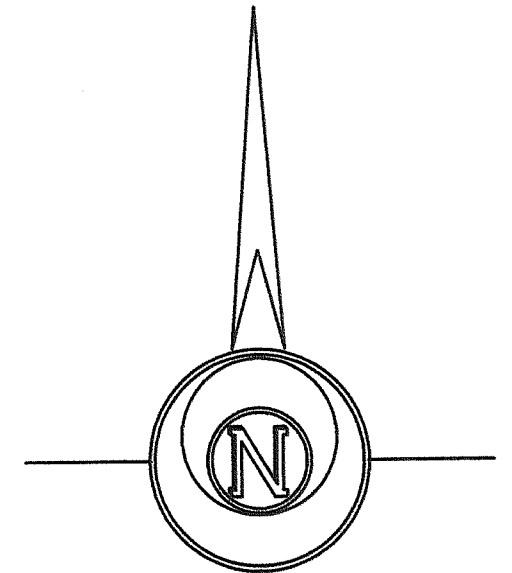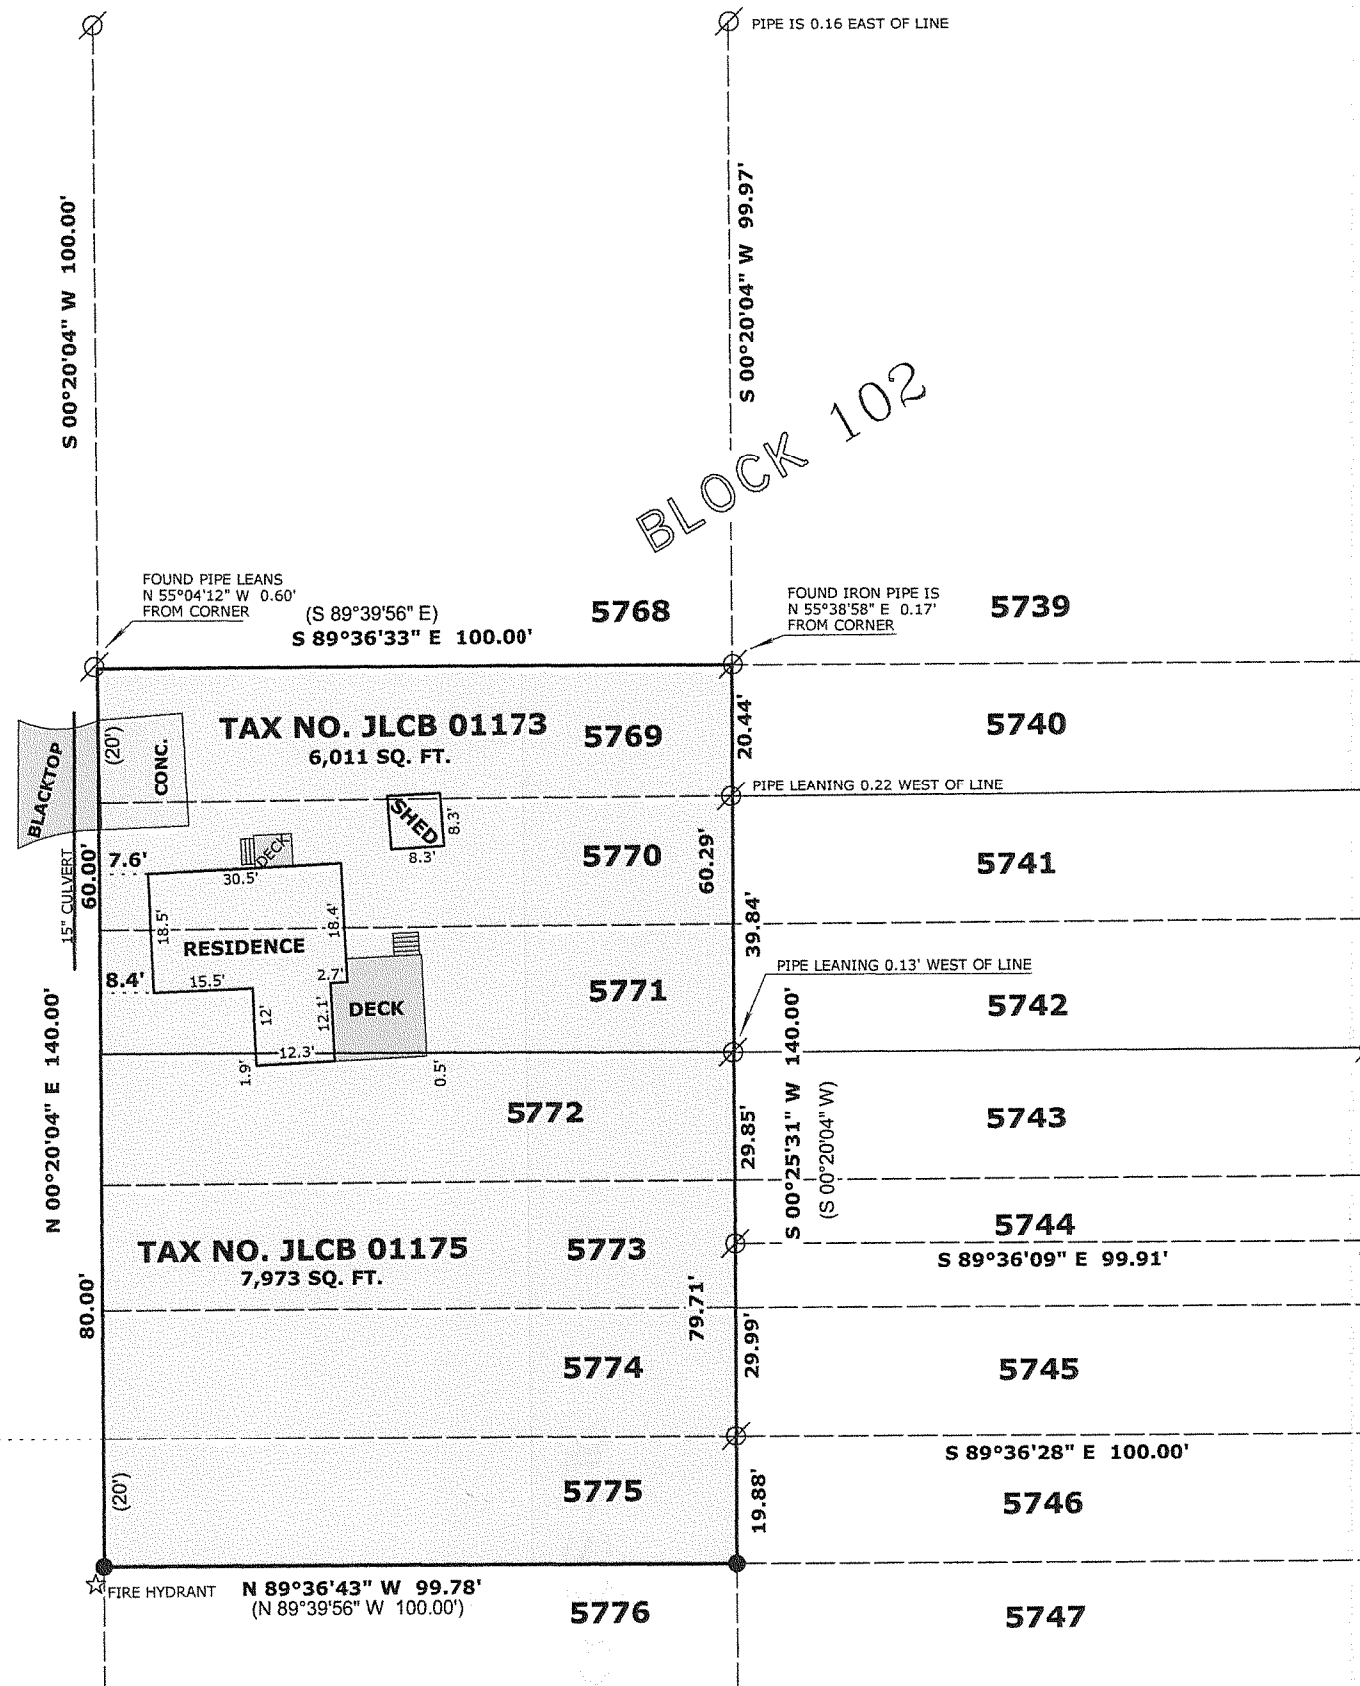

THE EAST LINE OF
OF HICKORY ROAD
WAS ASSUMED TO
BEAR N 00°20'04" E
AS PLATTED

LEGEND

- FOUND IRON PIPE
- SET IRON ROD, 24" LONG, WEIGHING 1.5 LBS./LINEAL FT., 3/4" DIA.
- RECORDED AS DIMENSION

SCALE: 1 INCH = 30 FEET

"I hereby certify that the above described property has been surveyed by me or under my direction and that the above map is a true representation thereof and shows the size and location of the property, its exterior boundaries, the location of all visible structures and dimensions of all principal buildings thereon, boundary fences, apparent easements, roadways and visible encroachments, if any."

"This survey is made for the use of the present owners of the property, and also those who purchase, mortgage, or guarantee the title thereto within one year from date hereof."

Mark L. Miritz

MARK L. MIRITZ
WISCONSIN REGISTERED
LAND SURVEYOR S-2582

DATE: NOV. 18, 2008 JOB NO. 08.814

JLCB-1175

217-3535