


Plat of Survey

of

Lot 26 of Wildwood,

a subdivision located in the Northeast 1/4 of Section 34, Town 2 North,
Range 17 East, Town of Geneva, Walworth County, Wisconsin.

Surveyed for: **Don & Sue Schultz**
402 South Lake Shore Drive
Lake Geneva, Wisconsin. 53147


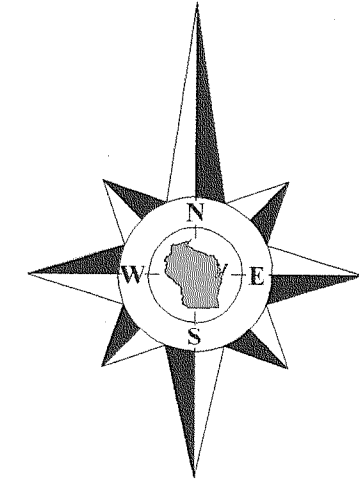


Bearings are referenced to the East
line of Wildwood Drive, recorded as
N30°36'E on the plat of Wildwood.

Benchmark
Top of Iron Pipe
Elevation=103.40

Tax Parcel
JG 3400002

Note:
Only trees designated by contractor
have been located.

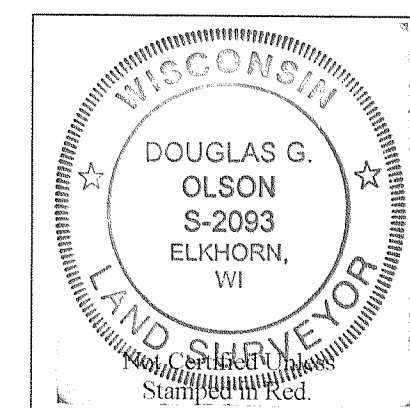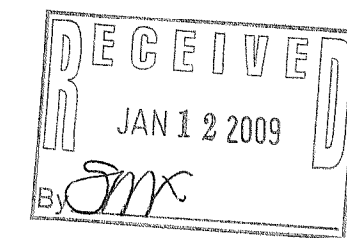

I hereby certify that I have surveyed the above described property and the map
hereon is correct to the best of my professional knowledge and belief and shows the size
and location of the property, its exterior boundaries, the location and dimensions of all
visible structures thereon, boundary fences, apparent easements and roadways and
visible encroachments, if any.
This survey is made for the exclusive use of the present owners of the property,
and also those who purchase, mortgage or guarantee title thereto, within one year from
the date hereof.


Douglas G. Olson
Wisconsin Registered Land Surveyor - 2093

- Notes:**
- 1) This survey plat is not
certified unless signed
and sealed in red ink.
 - 2) This survey is subject to Wisconsin lien laws.
This Plat of Survey is the notice of intent
to file lien. Lien waiver required.

Copyright 2008 by Jensen & Olson Land Surveying, LLC.

All rights reserved. No part of this survey plat may be reproduced or transmitted in
any form by any means - graphic, electronic, or mechanical, including photocopying,
tracing, or information storage and retrieval systems - without permission in writing
from Douglas G. Olson, Jensen & Olson Land Surveying, LLC.

Survey Date: September 9, 2008.
Revisions: No. 1 - Contours & Trees

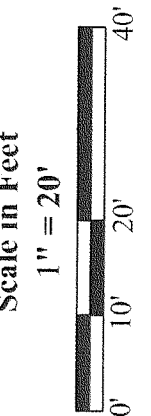

Jensen & Olson Land Surveying, LLC
45 South Wisconsin Street * P.O. Box 322 * Elkhorn, Wisconsin. 53121
Telephone: (262) 723-3434 * Facsimile: (262) 723-8044
Email: jensen.olson@elknet.net

Legend

- Found Iron Rod, 1-3/16" dia.
- Found Iron Pipe, 3/4" dia.
- Set Wood Lath
- () Recorded Information
- Utility Pedestal
- Gravel Surface
- Deciduous Tree with 12" dbh
- Coniferous Tree with 12" dbh
- Unknown

Sheet 1 of 1 Sheets
Drawing Name: 12n17e-2008095-2008095
Job Reference Number
2008.095

2008.095

JWS -25

217-3540