

LAND-MARK SURVEYING

Mark L. Miritz

Wisconsin Registered Land Surveyor S-2582



N9330 Knuteson Drive
Whitewater, WI 53190
Phone: (262) 495-3284
FAX : (262) 495-8421
LAND-MARKSURVEYING.COM

PLAT OF SURVEY

LOT 11468 THROUGH LOT 11477 INCLUSIVE AND
LOT 11483 THROUGH LOT 11487 INCLUSIVE,
BLOCK 206, FIFTH MAP OF LAKE COMO BEACH
SUBDIVISION, LOCATED IN PART OF SECTION 29,
TOWN 2 NORTH, RANGE 17 EAST, GENEVA TOWN-
SHIP, WALWORTH COUNTY, WISCONSIN.

OWNERS OF TAX KEY JLCB 02496
LOT 11483 THROUGH LOT 11487
EUGENE E. BIOLIK
DANUTH LUCARZ
7846 W. LAWRENCE APT. C
NORRIDGE, IL 60706

OWNER OF TAX KEY JLCB 02494
LOT 11468 THROUGH LOT 11477
EUGENE BIOLIK
7846 W. LAWRENCE APT. C
NORRIDGE, IL 60607

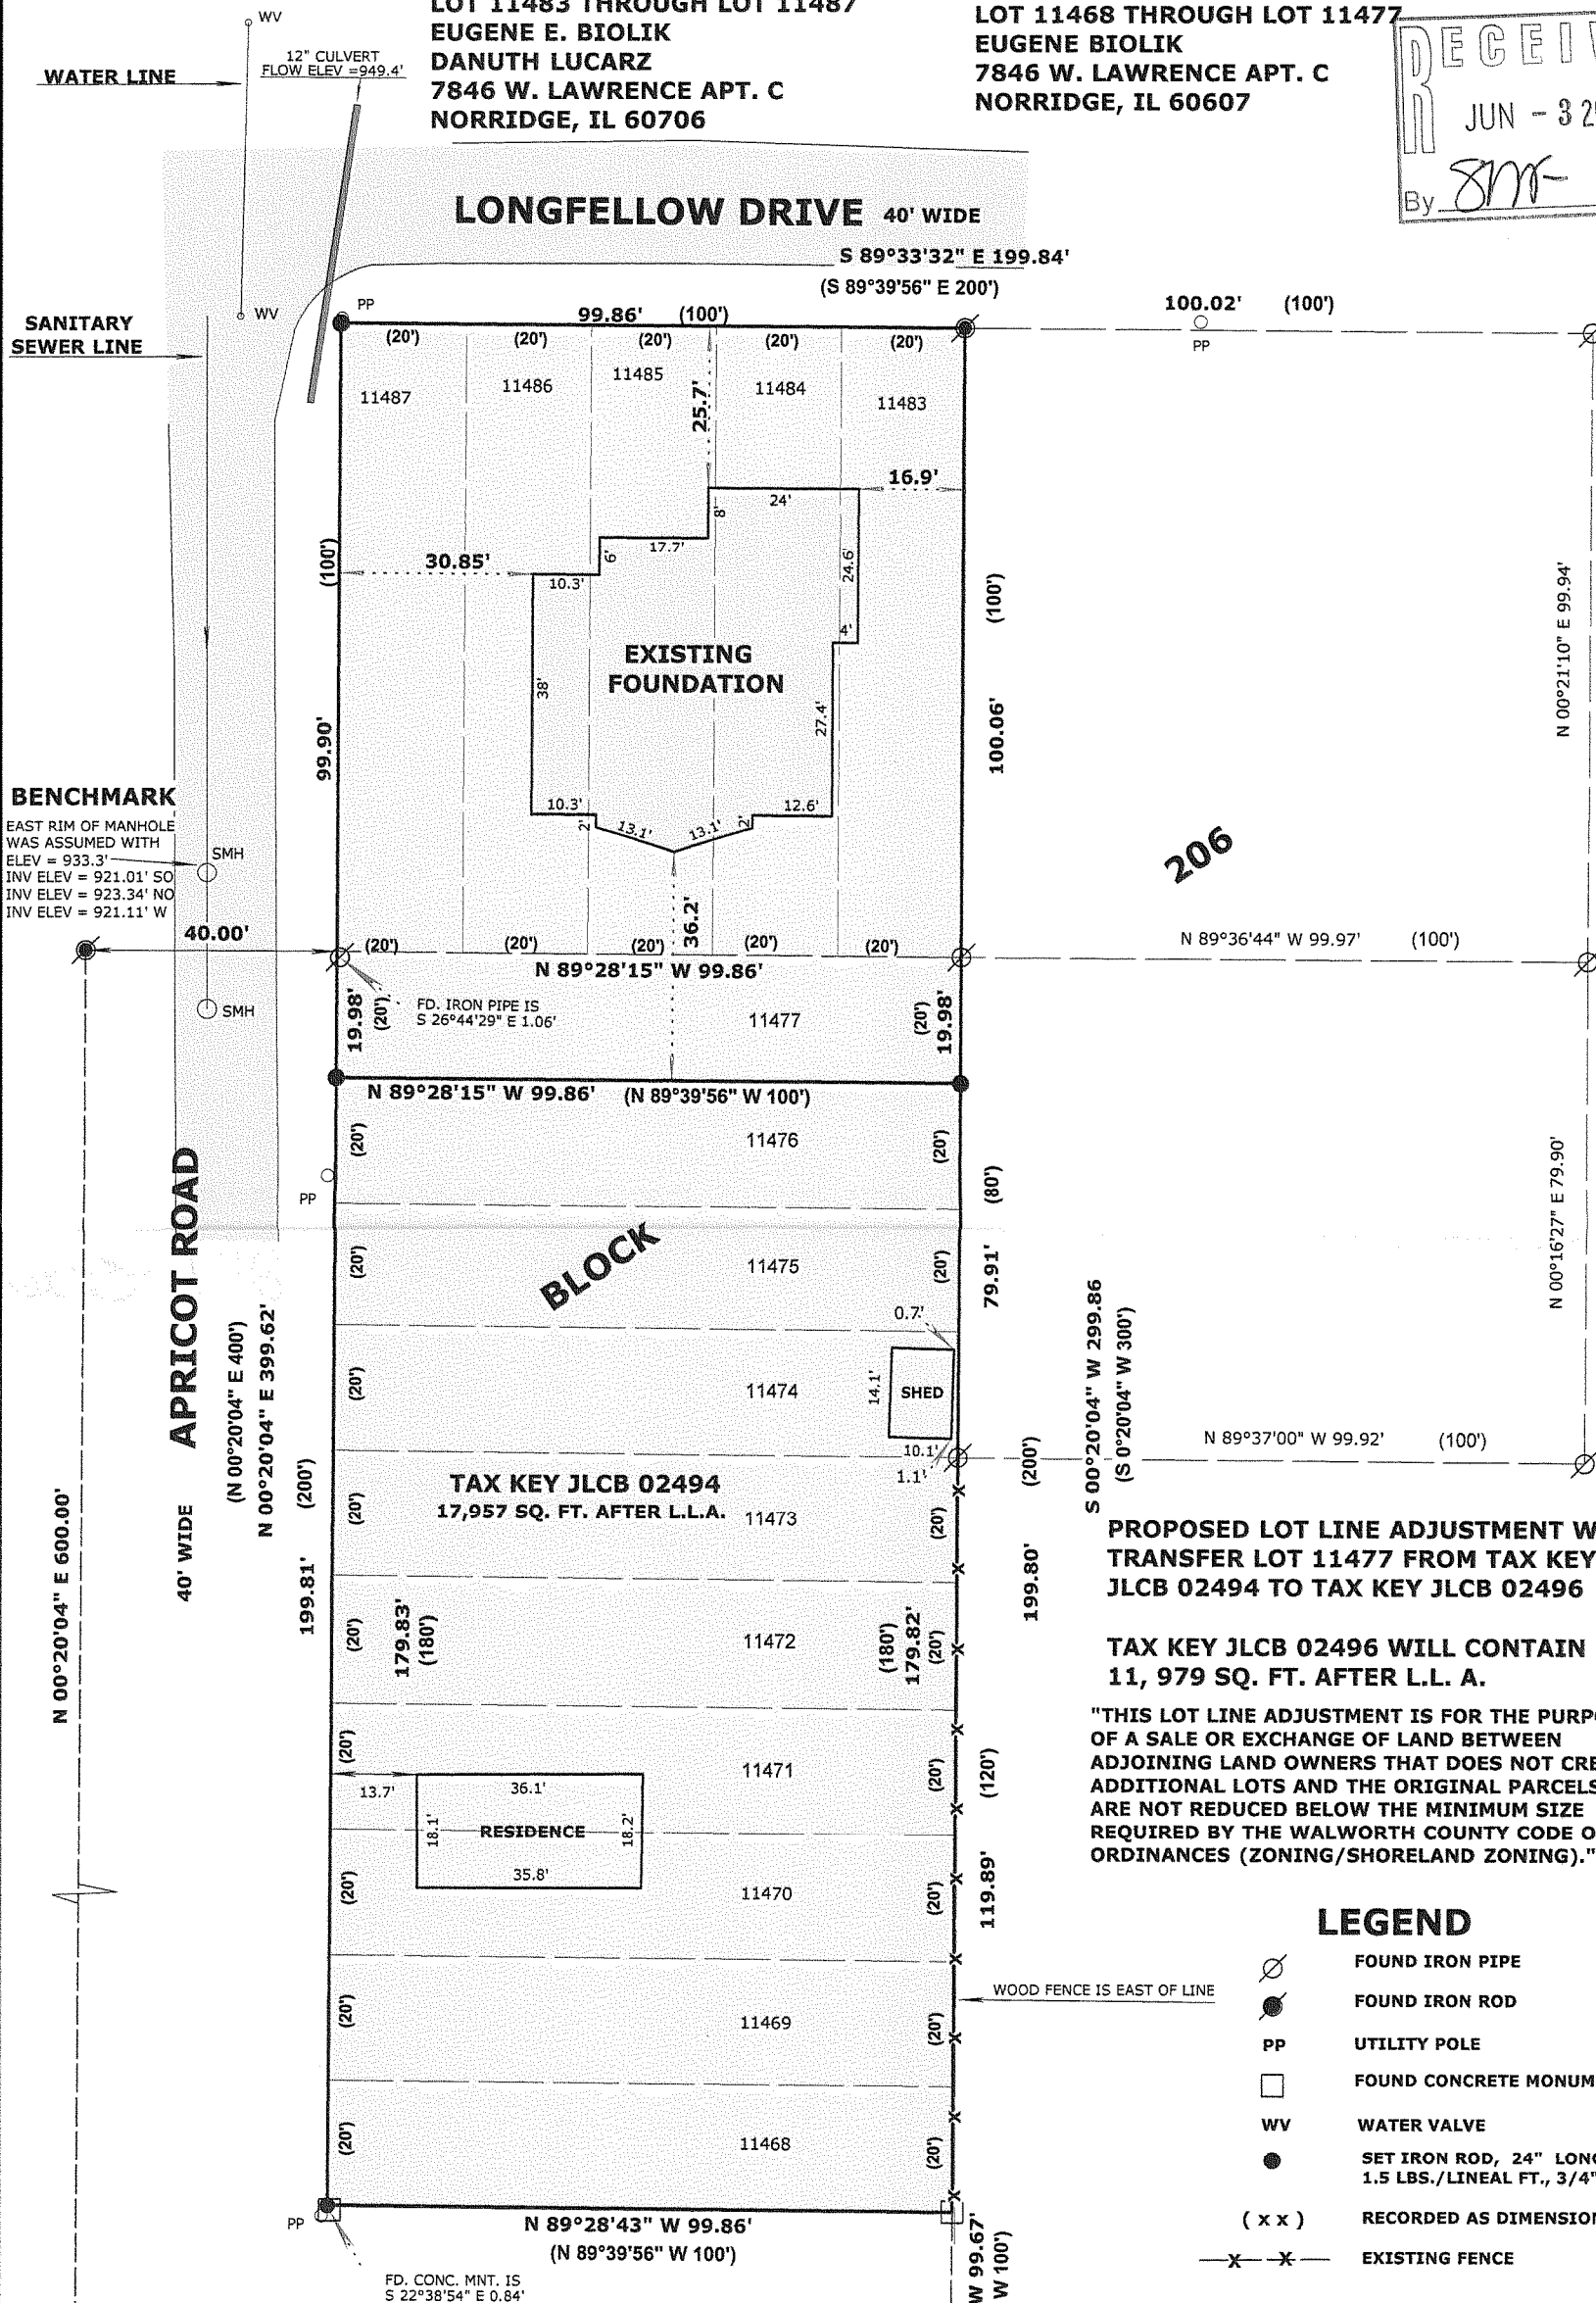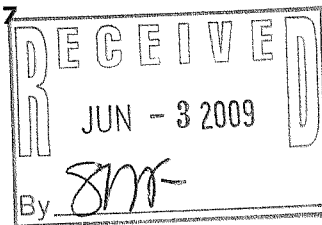

PROPOSED LOT LINE ADJUSTMENT WILL
TRANSFER LOT 11477 FROM TAX KEY
JLCB 02494 TO TAX KEY JLCB 02496

TAX KEY JLCB 02496 WILL CONTAIN
11, 979 SQ. FT. AFTER L.L. A.

"THIS LOT LINE ADJUSTMENT IS FOR THE PURPOSE
OF A SALE OR EXCHANGE OF LAND BETWEEN
ADJOINING LAND OWNERS THAT DOES NOT CREATE
ADDITIONAL LOTS AND THE ORIGINAL PARCELS
ARE NOT REDUCED BELOW THE MINIMUM SIZE
REQUIRED BY THE WALWORTH COUNTY CODE OF
ORDINANCES (ZONING/SHORELAND ZONING)."

LEGEND

- FOUND IRON PIPE
- FOUND IRON ROD
- UTILITY POLE
- FOUND CONCRETE MONUMENT
- WATER VALVE
- SET IRON ROD, 24" LONG, WEIGHING
1.5 LBS./LINEAL FT., 3/4" DIA.
- (x x) RECORDED AS DIMENSION
- EXISTING FENCE

SCALE: 1 INCH = 30 FEET

"I hereby certify that the above described property has
been surveyed by me or under my direction and that the
above map is a true representation thereof and shows the
size and location of the property, its exterior boundaries,
the location of all visible structures and dimensions of all
principal buildings thereon, boundary fences, apparent
easements, roadways and visible encroachments, if any."
"This survey is made for the use of the present owners of
the property, and also those who purchase, mortgage, or
guarantee the title thereto within one year from date
hereof."

Mark L. Miritz
MARK L. MIRITZ
WISCONSIN REGISTERED
LAND SURVEYOR S-2582

REVISED FEB. 13, 2009 TO
SHOW FOUNDATION "AS BUILT"

DATE: NOV. 18, 2008 JOB NO. 08.1101

PLATTED NORTH



JLCB-2496 JLCB 2494

217-35100