

PREPARED FOR:
DIANE COCROFT
KEEFE REAL ESTATE, INC.
751 GENEVA PARKWAY
LAKE GENEVA, WI 53147

PLAT OF SURVEY

-OF-




KROTT SURVEYING INC.

N3705 WILLOW BEND LANE
LAKE GENEVA WI. 53147
PHONE # (262)248-3697
FAX # (262)249-0639


PARCEL "A" LOTS 817 THRU 823 AND THE NORTH 1/2 OF LOT 824, BLOCK 14 LAKE COMO BEACH SUBDIVISION, LOCATED IN T.2.N., R.17.E., WALWORTH COUNTY, WISCONSIN. SAID PARCEL CONTAINS 15016 SQUARE FEET.

PARCEL "B" THE SOUTH 1/2 OF LOT 824 AND LOTS 825 THRU 831, BLOCK 14 LAKE COMO BEACH SUBDIVISION, LOCATED IN T.2.N., R.17.E., WALWORTH COUNTY, WISCONSIN. SAID PARCEL CONTAINS 14994 SQUARE FEET.

NOTE: THIS IS A PARCEL SPLIT

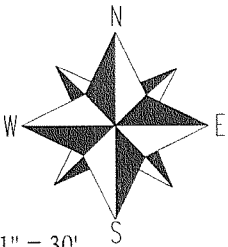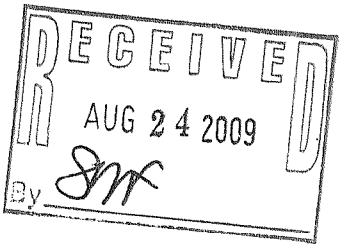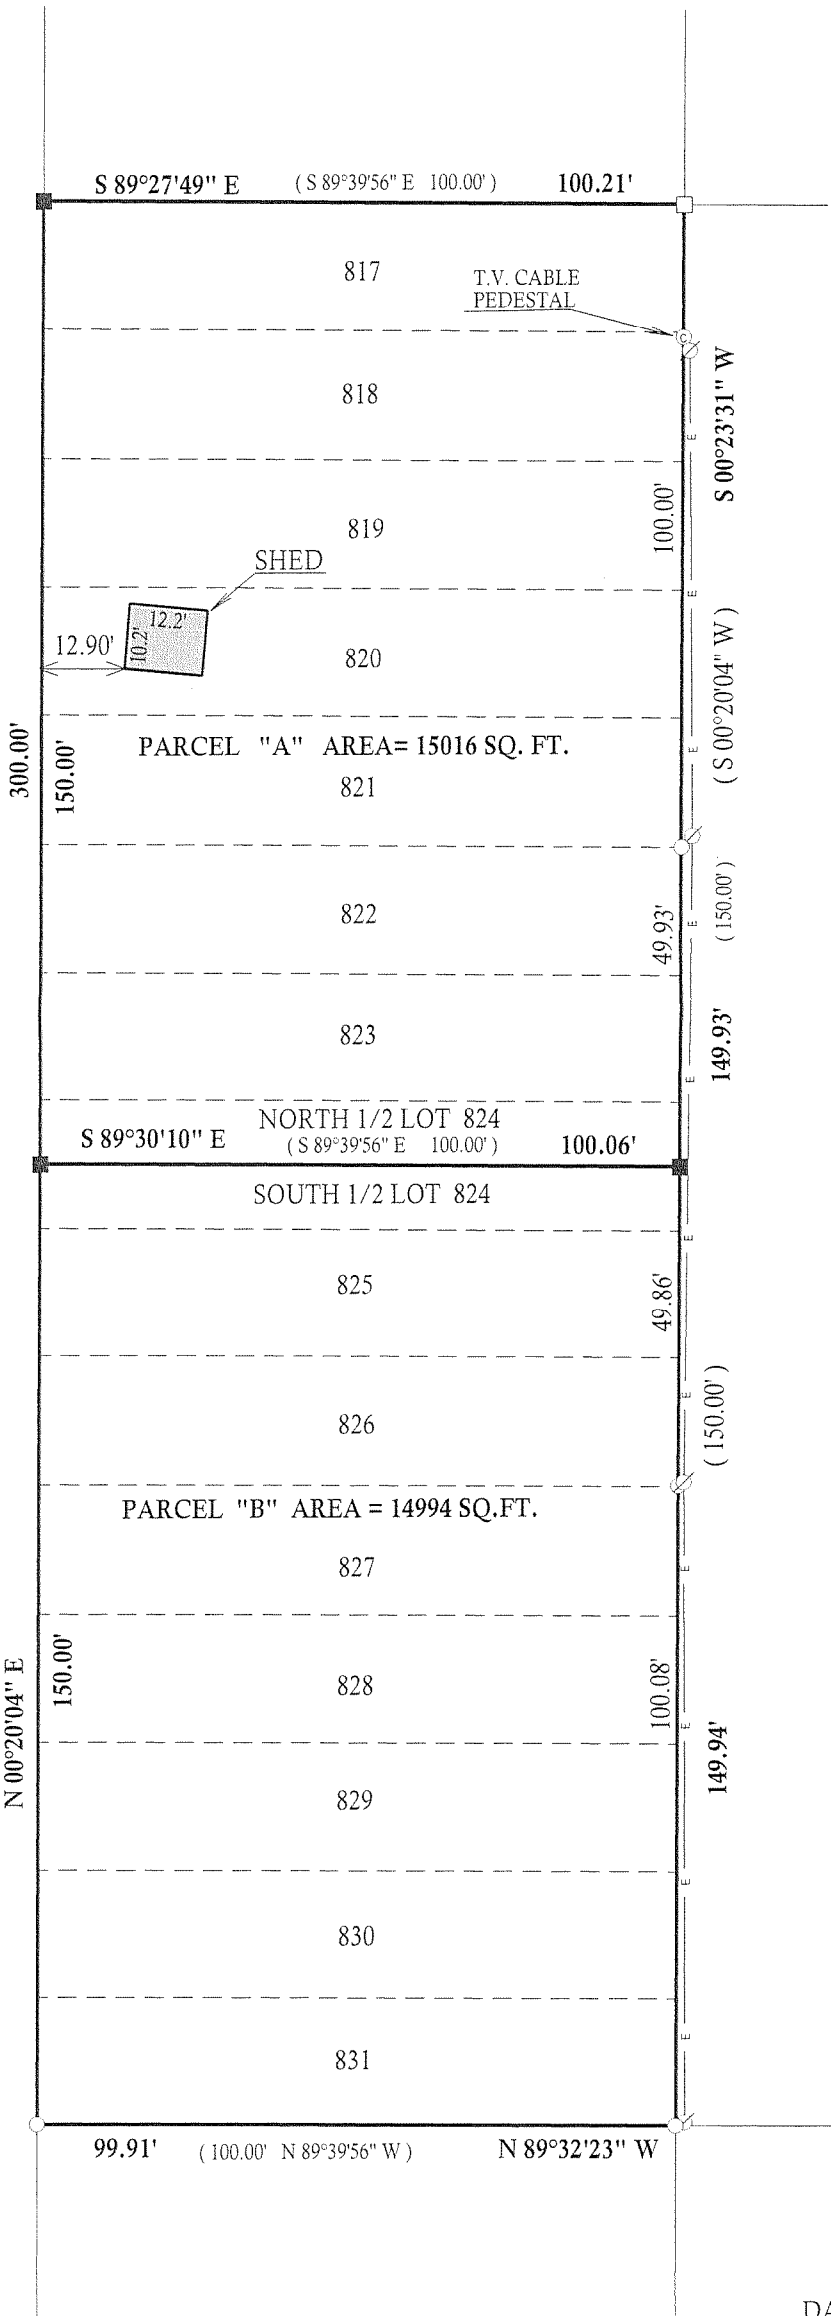

SCALE 1" = 30'

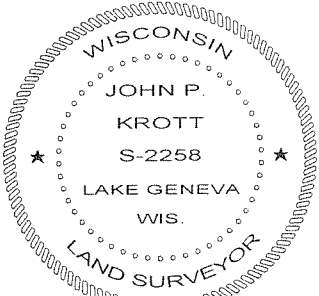

DATED THIS 21st, DAY OF JULY, 2009

John P. Krott

JOHN KROTT S - 2258
Wisconsin Registered Land Surveyor
(original if signed in red)

JOB # 09-093 TAX ID # JLCB00093A

"I hereby certify that I have surveyed the above described property and that the above map is a true representation thereof and shows the size and location of all visible structures, apparent easements and encroachments if any."
This survey is made for the present owners of the property, and those who purchase, mortgage, or guarantee the title thereto, within one year from the date hereof.

217-3576