


PLAT OF SURVEY


LOT 20, GENEVA OAKS, a subdivision located in the Northwest ¼ of Section 4, Township 1 North, Range 17 East, Walworth County, Wisconsin.

Surveyed for: Beckwith -Design LLC

Survey address: N2395 Geneva Oaks Trail

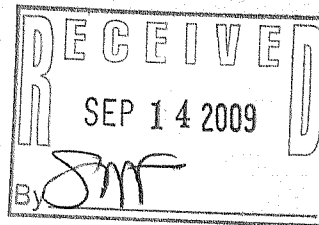

MAIN ROADWAY

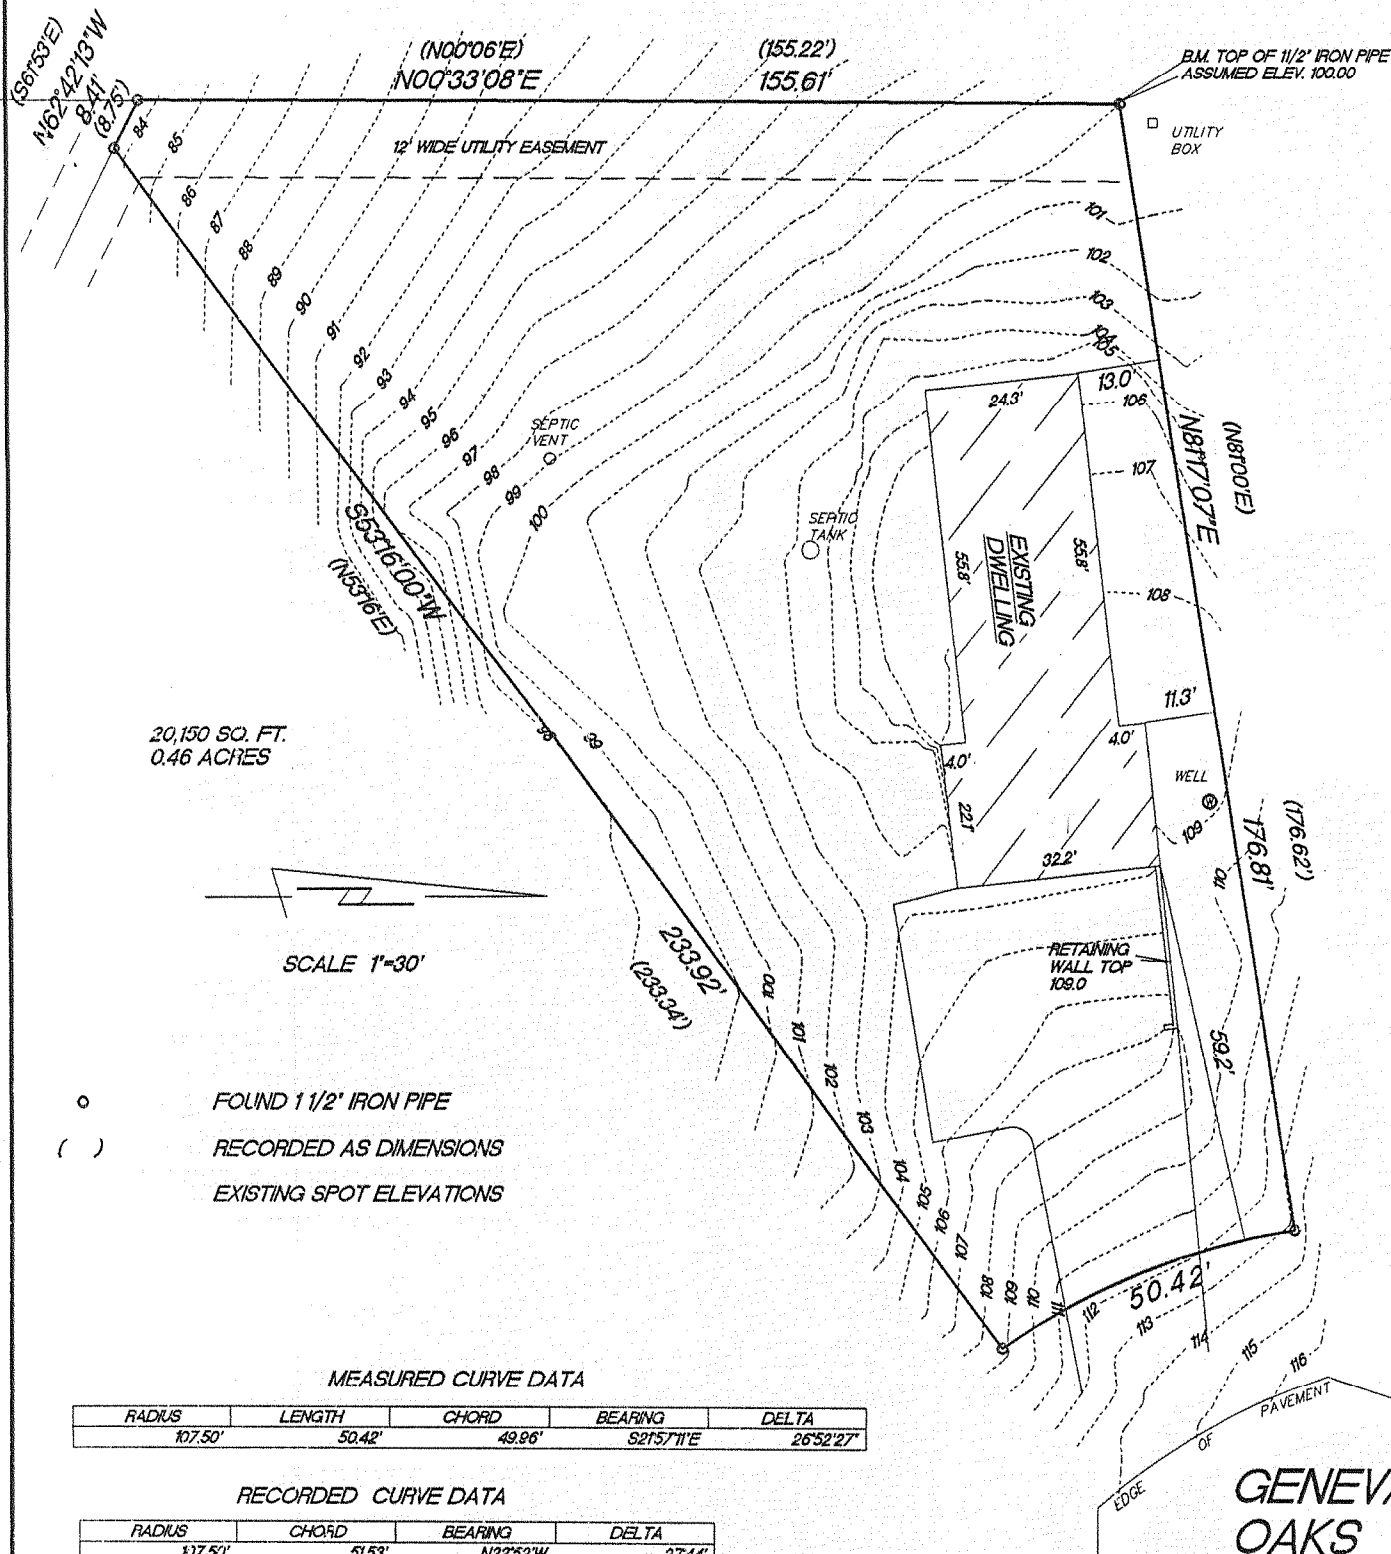

20,150 SQ. FT.
0.46 ACRES

SCALE 1"=30'

- FOUND 1 1/2" IRON PIPE
- () RECORDED AS DIMENSIONS
- EXISTING SPOT ELEVATIONS

MEASURED CURVE DATA

RADIUS	LENGTH	CHORD	BEARING	DELTA
107.50'	50.42'	49.96'	S21°57'11"E	26°52'27"

RECORDED CURVE DATA


RADIUS	CHORD	BEARING	DELTA
107.50'	51.53'	N22°52'W	27°44'

"I hereby certify that I have surveyed the above described property and that the above map is a true representation thereof and shows the size and location of the property, its exterior boundaries, the location of all visible structures and dimension of all principal buildings thereon, boundary fences, apparent easements, roadways and encroachments if any."

"This survey is made for the use of the present owners of the property, and also those who purchase, mortgage or guarantee the title thereto within one year from date hereof."

KETTLE MORaine SURVEYING INC.
S75 W36245 Wilton Road
Eagle Wisconsin 53119
P.O. Box 357
(262) 594-3484

Terrance E. Pisarek R.L.S.

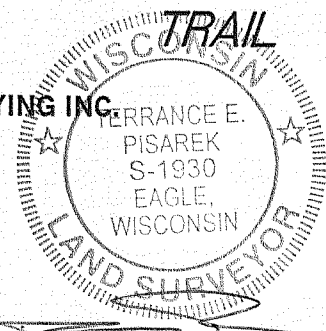

THIS IS NOT AN ORIGINAL SURVEY UNLESS THE SEAL IS RED.

9/3/09

TEP

TEP

09084

DATE

FIELD WORK BY

DRAWN BY

JOB NUMBER

IG10-20

117-3080