

PREPARED FOR
DIANE COCROFT
KEEFE REAL ESTATE
PO. BOX 460
751 GENEVA PARKWAY
LAKE GENEVA WI 53147

PLAT OF SURVEY

-OF-

LOTS 3878 THRU 3887 BLOCK 67 OF LAKE COMO BEACH SUBDIVISION LOCATED IN
TOWN 2 NORTH, RANGE 17 EAST, WALWORTH COUNTY, WISCONSIN.


KROTT SURVEYING INC.

N3705 WILLOW BEND LANE
LAKE GENEVA WI. 53147
PHONE # (262)248-3697
FAX # (262)249-0639

C.L. LINCOLN DRIVE
(50' WIDE)

C.L. WALNUT ROAD
(40' WIDE)


C.L. VINE ROAD
(40' WIDE)

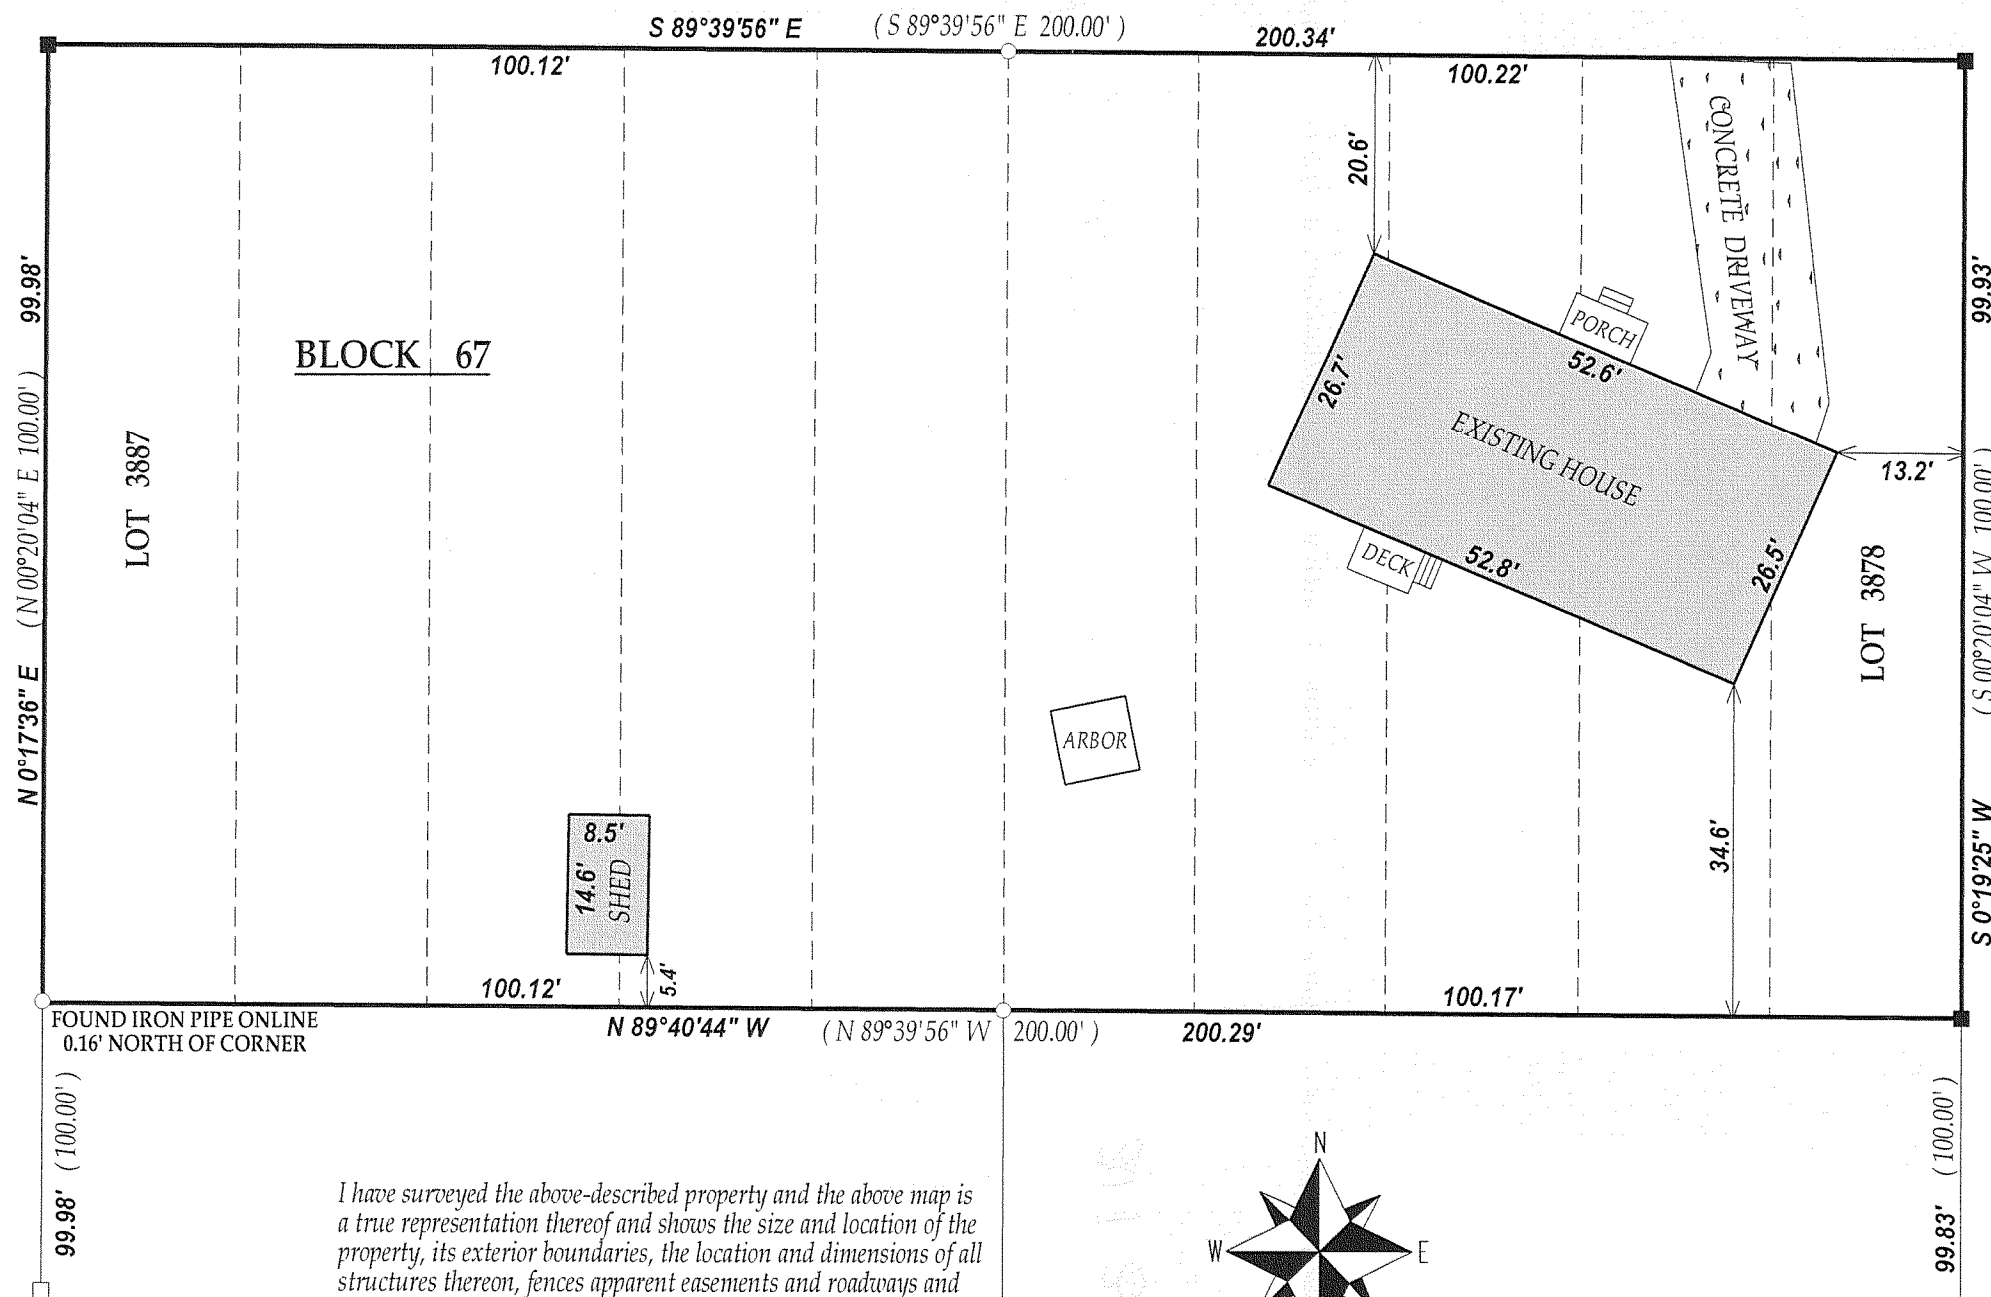

LEGEND
○ FOUND IRON PIPE
□ FOUND IRON BAR
■ SET IRON BAR
(xx) RECORDED AS
TAX ID # JLCB00741
JOB # 09-131

I have surveyed the above-described property and the above map is a true representation thereof and shows the size and location of the property, its exterior boundaries, the location and dimensions of all structures thereon, fences apparent easements and roadways and visible encroachments, if any.



This survey is made for the exclusive use of the present owners of the property, and also those who purchase, mortgage, or insure the title thereto within one (1) year from date hereof; and as to them I warrant the accuracy of said survey map.

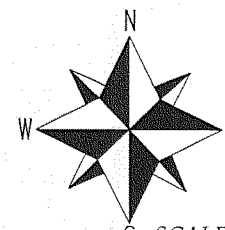

SCALE 1"=20'



NOTE : BASIS OF BEARINGS ARE REFERENCED TO THE RECORDED PLAT

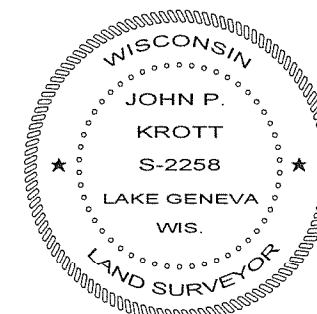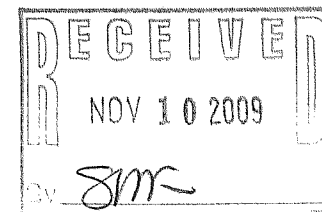

John P. Krott

JOHN KROTT S - 2258
Wisconsin Registered Land Surveyor
(original if signed in red)

DATED THIS 17th DAY OF SEPTEMBER 2009.

217 - 3591