


PREPARED FOR
NORMAN PEANDRO
5678 PARLIAMENT
DELAVAN WI. 53115



PLAT OF SURVEY
-OF-

KROTT SURVEYING INC.
N3705 WILLOW BEND LANE
LAKE GENEVA WI. 53147
PHONE # (262)248-3697
FAX # (262)249-0639

LOTS 9805 THRU 9809 , BLOCK 179 OF LAKE COMO BEACH SUBDIVISION,
LOCATED IN TOWN 2 NORTH, RANGE 17 EAST, WALWORTH COUNTY,
WISCONSIN.

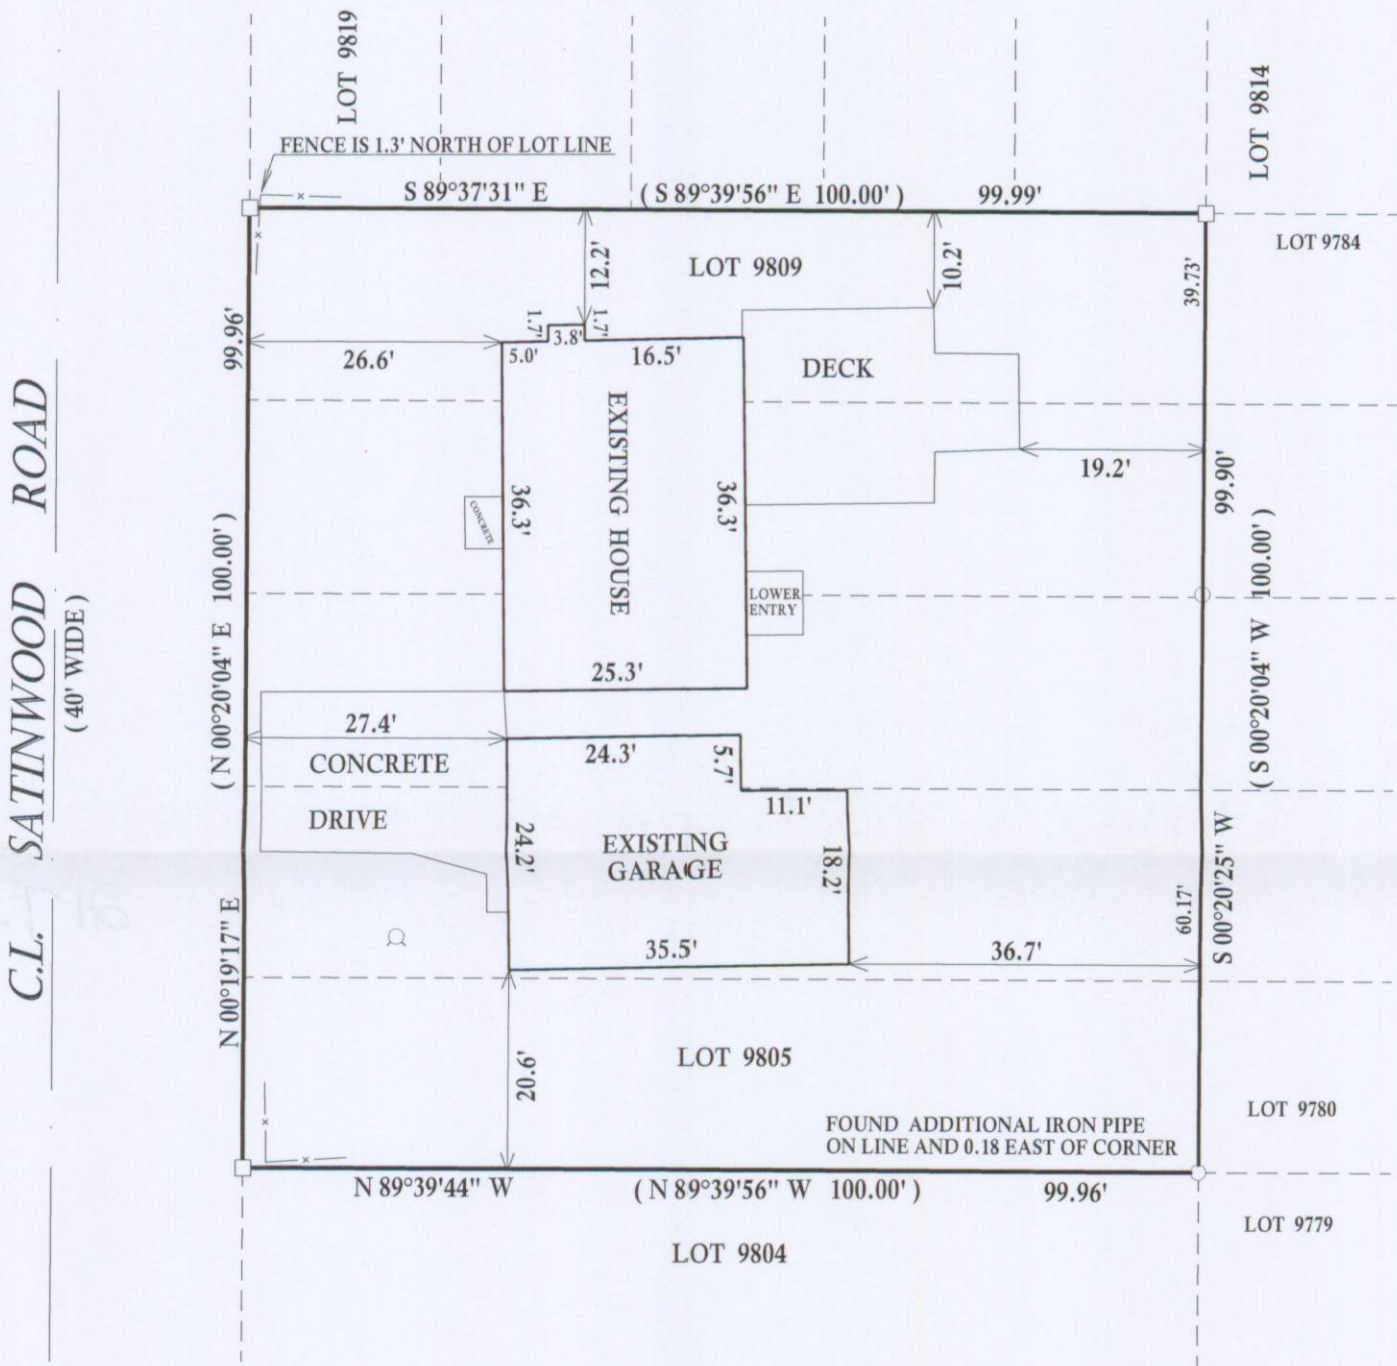

SCALE 1" = 20'
0 20 40 60

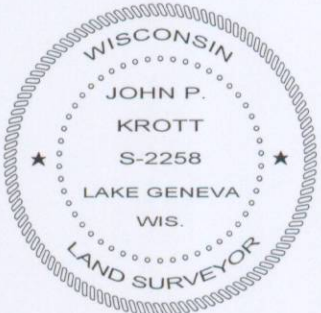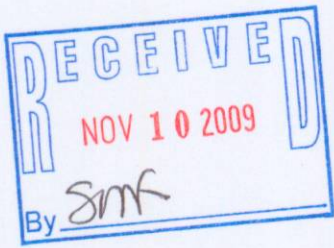

DATED THIS 9th, DAY OF NOVEMBER, 2009

John P. Krott
JOHN KROTT S - 2258
Wisconsin Registered Land Surveyor
(original if signed in red)

LEGEND
○ FOUND IRON PIPE
□ FOUND IRON BAR
Q WELL
(XX) RECORDED AS
TAX ID # JLCB02117
JOB # 09-164

I have surveyed the above-described property and the above map is a true representation thereof and shows the size and location of the property, its exterior boundaries, the location and dimensions of all structures thereon, fences apparent easements and roadways and visible encroachments, if any.

This survey is made for the exclusive use of the present owners of the property, and also those who purchase, mortgage, or insure the title thereto within one (1) year from date hereof; and as to them I warrant the accuracy of said survey map.

NOTE : BEARINGS ARE REFERENCED TO THE
RECORD PLAT OF LAKE COMO BEACH SUB.

217-3596