

PLAT OF SURVEY -OF-

LOTS 1621-1626 AND LOTS 1635-1636, BLOCK 26 IN THE 3RD MAP OF LAKE COMO BEACH SUBDIVISION, LOCATED IN TOWNSHIP 2 NORTH, RANGE 17 EAST, TOWN OF GENEVA, WALWORTH COUNTY, WISCONSIN.

SURVEY FOR: SOUTHEASTERN WISCONSIN HOUSING CORP.


TOP OF FOUNDATION: 106.0

PROPOSED ADDRESS: _____ OAK ROAD

PROPOSED GARAGE FLOOR: 105.5

I HEREBY CERTIFY THAT THE EXISTING FOUNDATION SHOWN ON THIS PLAT OF SURVEY IS LOCATED AS SHOWN THUS (). DATED THIS 26TH DAY OF AUGUST 2009.


Robert J. Wetzel
ROBERT J. WETZEL S-1778

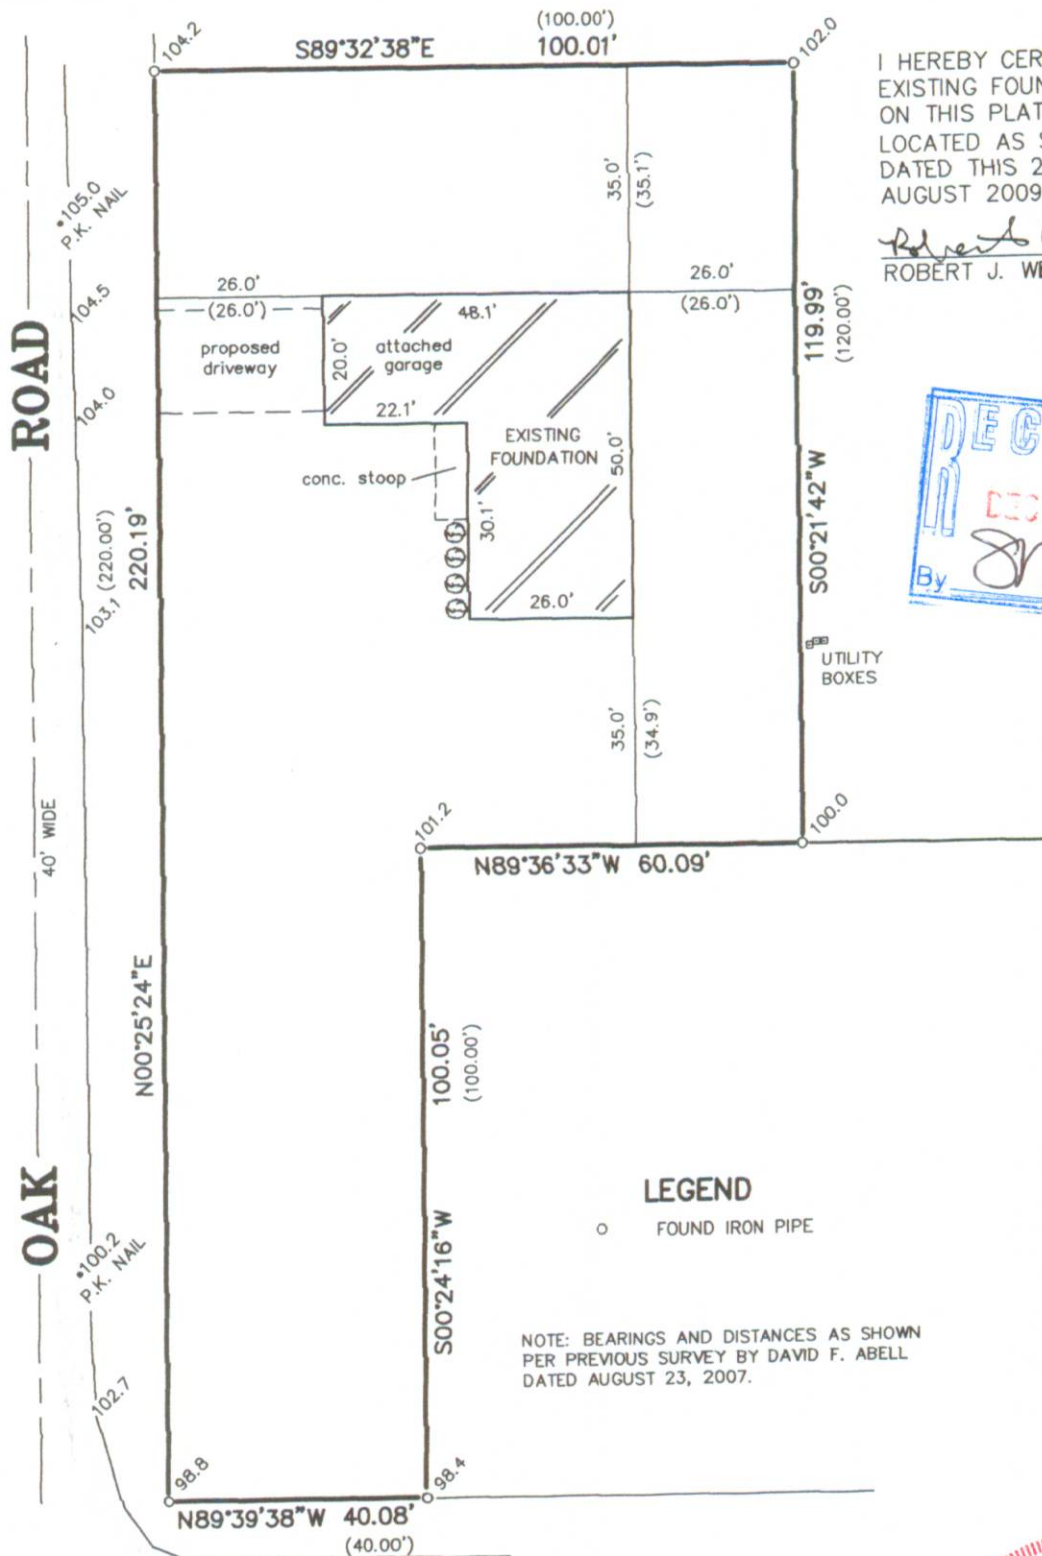

-WOODLAND DRIVE- 40' WIDE

"I hereby certify that I have surveyed the above described property and that the above map is a correct representation thereof and shows the size and location of the property, its exterior boundaries, the location of all visible structures and dimensions of all principal buildings thereon, boundary fences, apparent easements, roadways and encroachments, if any."

"This survey is made for the use of the present owners of the property, and those who purchase, mortgage, or guarantee the title thereto within one year from date hereof."

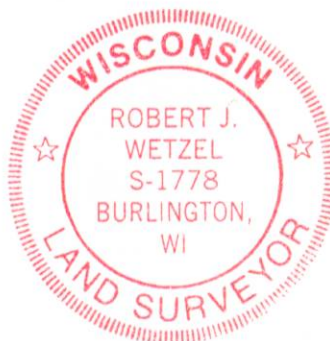

THIS IS NOT AN ORIGINAL PRINT
UNLESS THIS SEAL IS RED.

B.W. SURVEYING, INC.

412 N. PINE STREET
BURLINGTON, WI 53105
(262)-767-0225

Robert J. Wetzel
ROBERT J. WETZEL S-1778

REVISED: JULY 15, 2009
JANUARY 26, 2009

7992
JOB NUMBER

REVISED: AUGUST 5, 2009

DATE



JLCB-253

217-3600