

LAND-MARK SURVEYING
Mark L. Miritz


Wisconsin Registered Land Surveyor S-2582

N9330 Knuteson Drive
Whitewater, WI 53190
Phone: (262) 495-3284
FAX : (262) 495-8421
LAND-MARKSURVEYING.COM

PLAT OF SURVEY

LOTS 11766 THRU 11770, BLOCK 211, THE FIFTH MAP
OF LAKE COMO BEACH SUBDIVISION, LOCATED IN
TOWN 2 NORTH, RANGE 17 EAST, GENEVA TOWNSHIP,
WALWORTH COUNTY, WISCONSIN.

ORDERED BY: GENE DECKER
N3072 BEGONIA ROAD
LAKE GENEVA, WI 53147

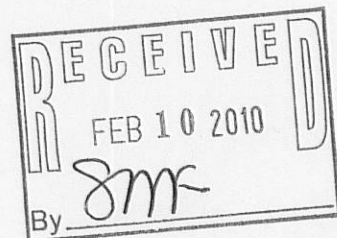


BLOCK 211

HEMLOCK DRIVE

(40' WIDE)

UTILITY POLE 0.7' NORTH OF CORNER

(S 89°39'56" E 100.00')
S 89°44'30" E 100.01'

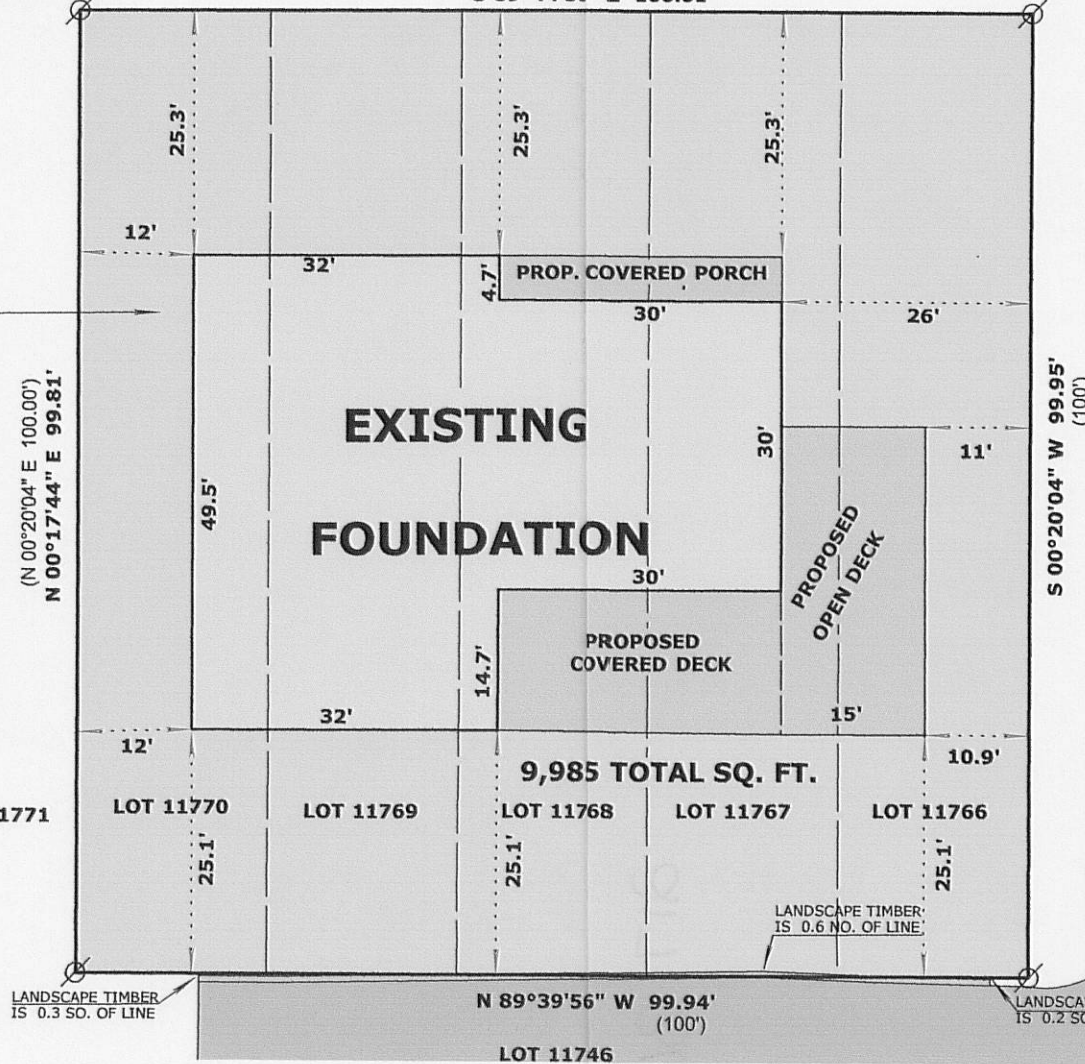


BEGONIA ROAD

(40' WIDE)

BENCHMRK

SANITARY SEWER MH RIM ELEV=864.5'
1E SOUTH=851.1'
1E NORTH=853.1'

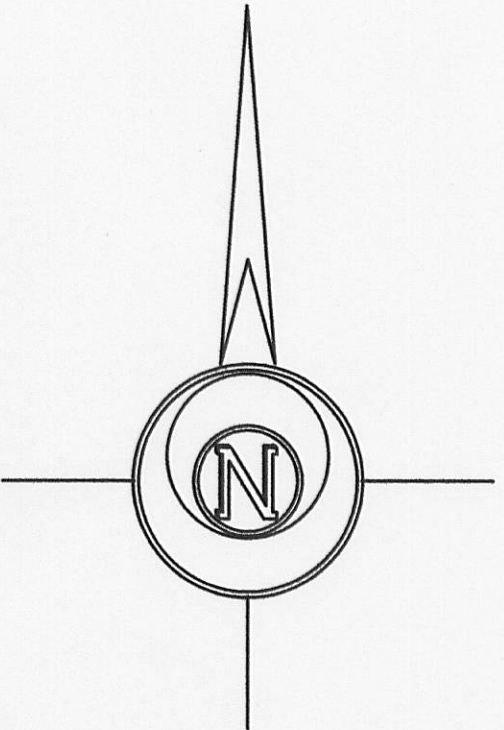

LEGEND

- FOUND IRON PIPE
- FOUND IRON ROD
- (x x) RECORDED AS DIMENSION

SCALE: 1 INCH = 20 FEET

"I hereby certify that the above described property has been surveyed by me or under my direction and that the above map is a true representation thereof and shows the size and location of the property, its exterior boundaries, the location of all visible structures and dimensions of all principal buildings thereon, boundary fences, apparent easements, roadways and visible encroachments, if any."
"This survey is made for the use of the present owners of the property, and also those who purchase, mortgage, or guarantee the title thereto within one year from date hereof."

Mark L. Miritz
MARK L. MIRITZ
WISCONSIN REGISTERED
LAND SURVEYOR S-2582

REVISED JUNE 3, 2009 TO SHOW FOUNDATION "AS BUILT" DATE: AUGUST 24, 2008 JOB NO. 08.808

JLCB-2559

217-3611