



PLAT OF SURVEY





UNIT 3-19
GENEVA NATIONAL CONDOMINIUM
NO. 3
LOCATED IN TOWN 2 NORTH, RANGE 17 EAST
WALWORTH COUNTY, WISCONSIN

WORK ORDERED BY
MIKE McCABE
W5381 ANGELS LANE
FONTANA, WI. 53125

FARRIS, HANSEN & ASSOCIATES, INC.
Engineering, Architecture, Surveying
7 Ridgway Court P.O. Box 437
ELKHORN, WISCONSIN 53121
Office: (262) 723-2098
Fax: (262) 723-5886

REVISIONS
05-04-2004
ADD TOPO-
GRAPHICAL
FEATURES

PROJECT NO.
3269.03.19
DATE:
10/16/03
SHEET NO.
1 OF 1

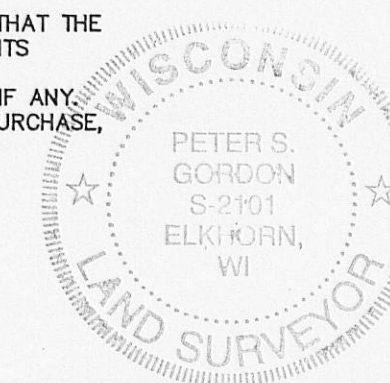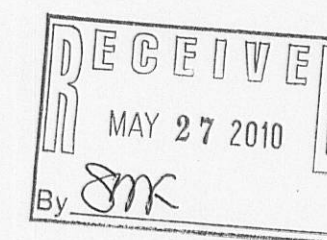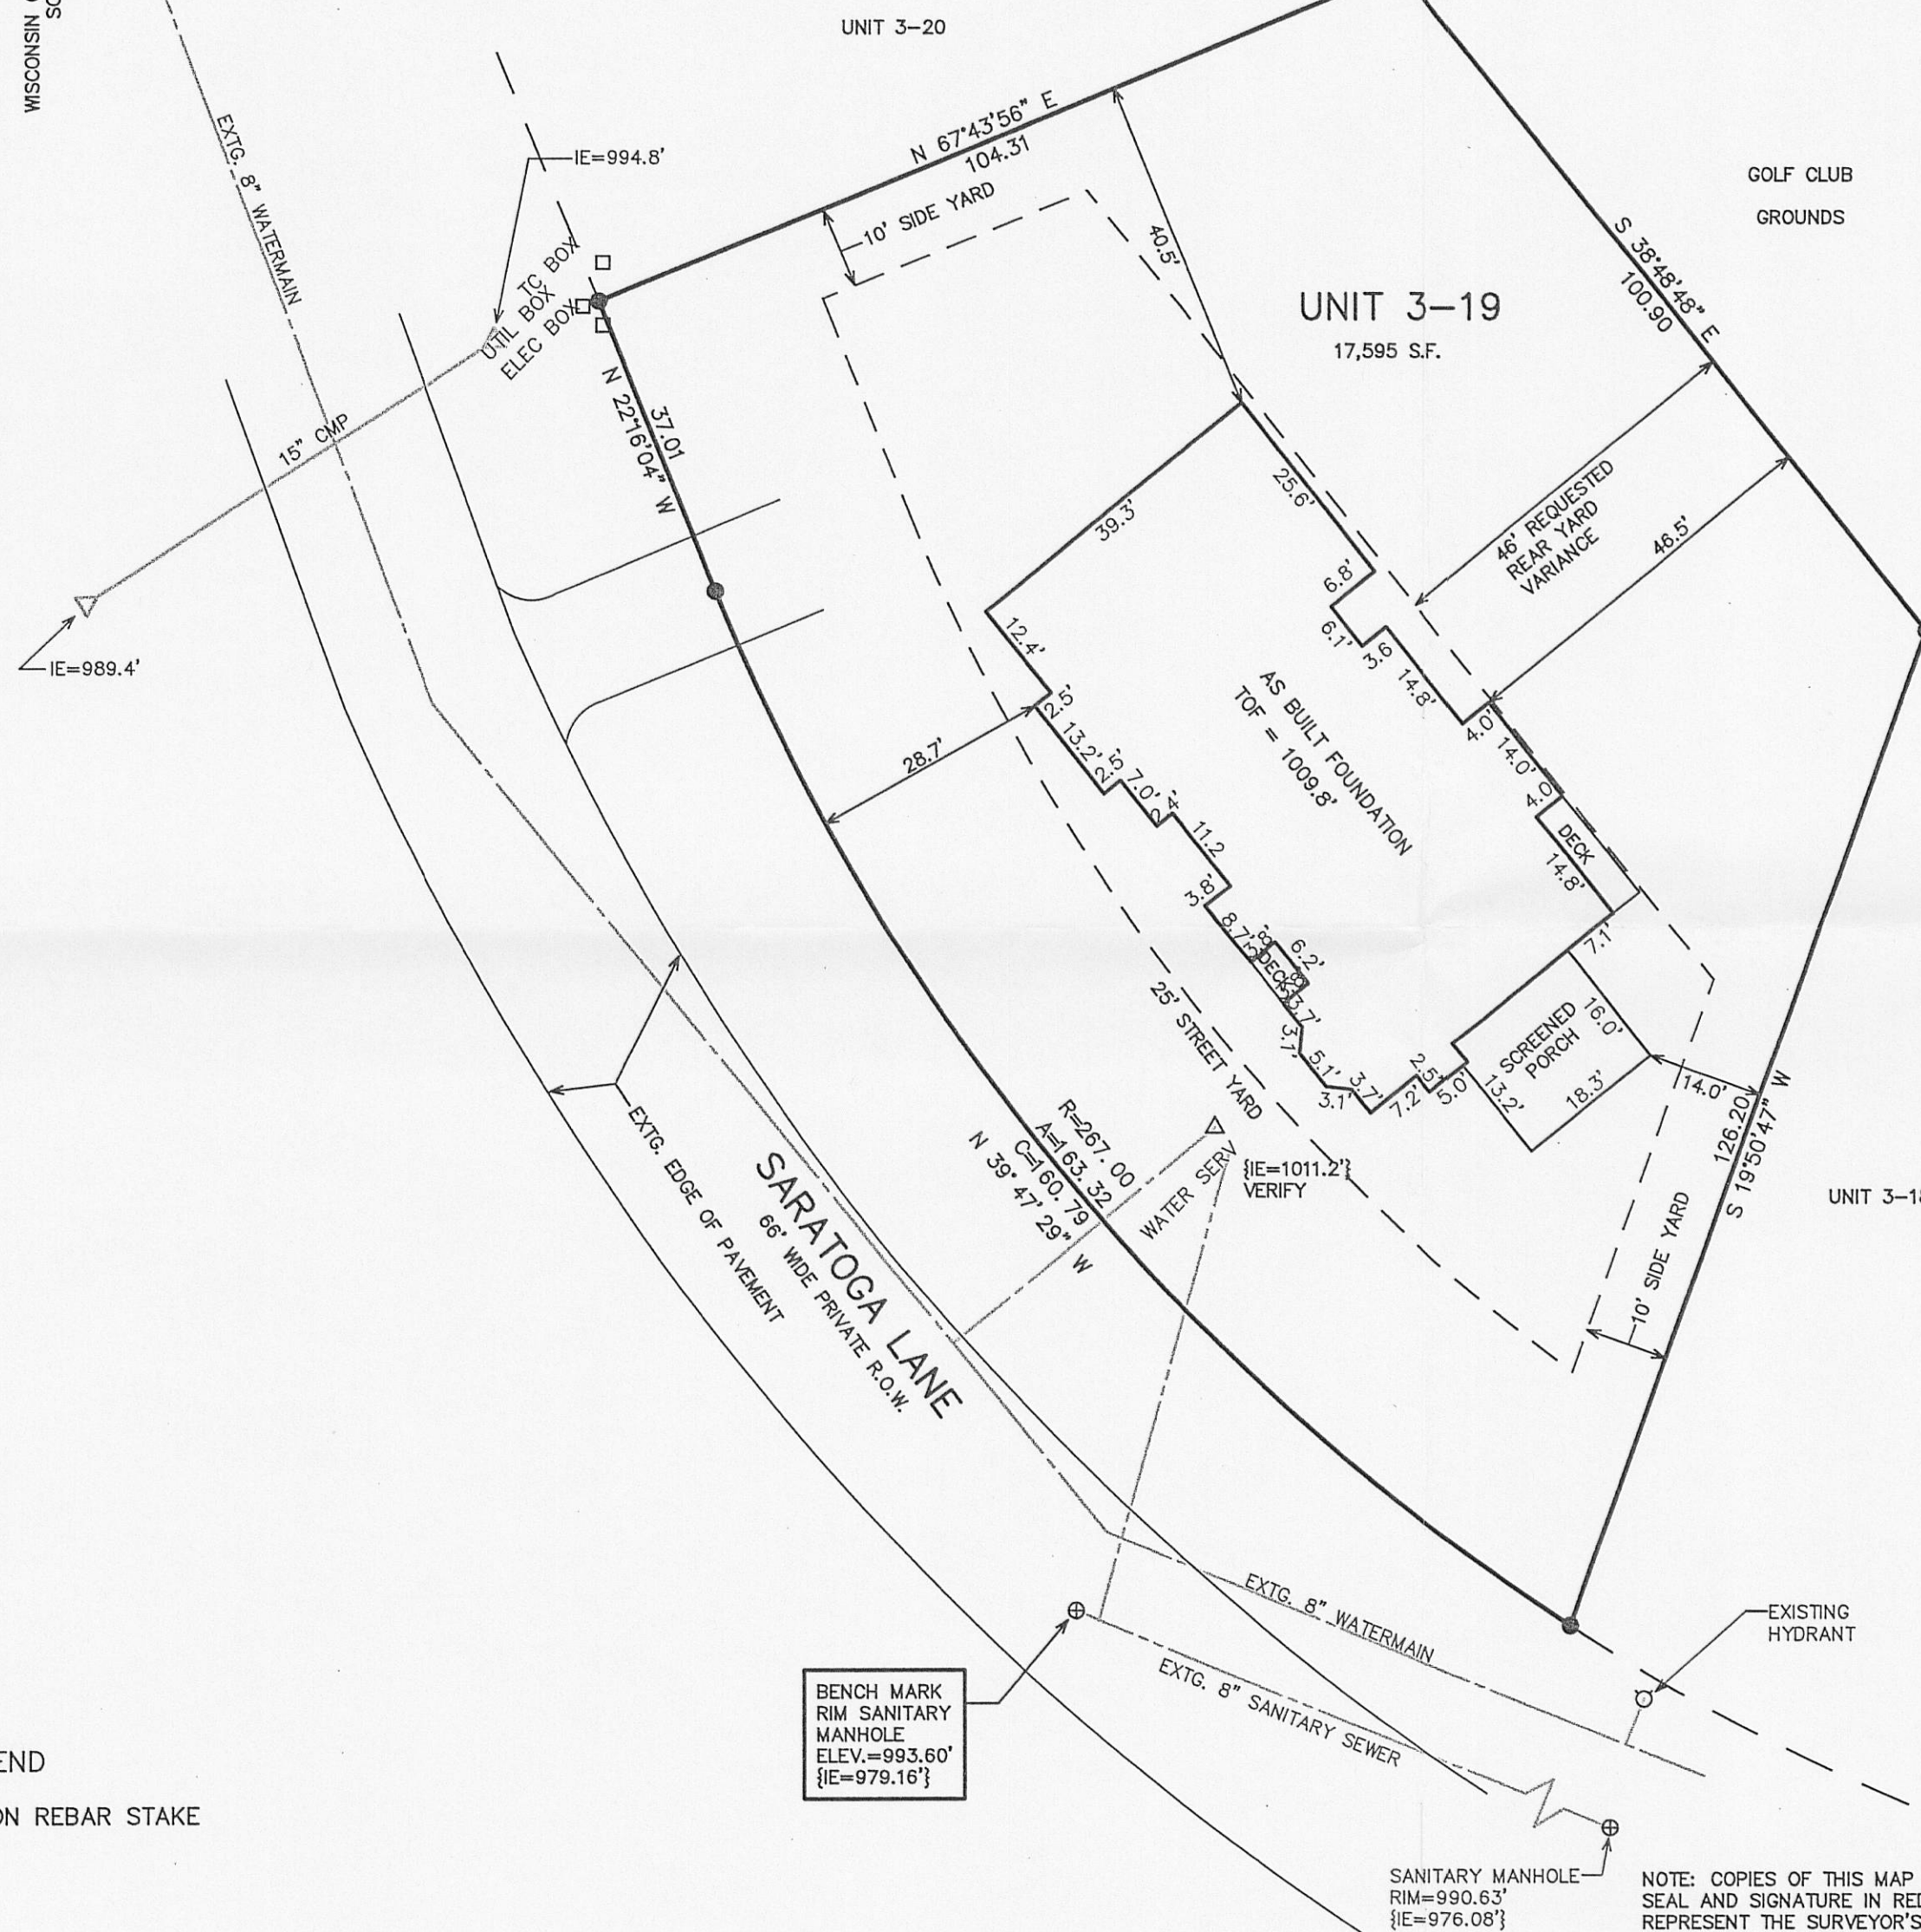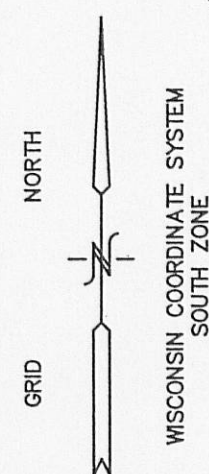

MAR 30 2010

JCN 3-19

217-3636