

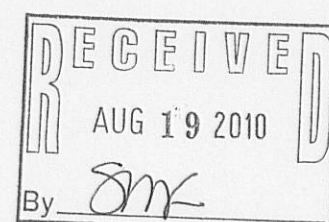


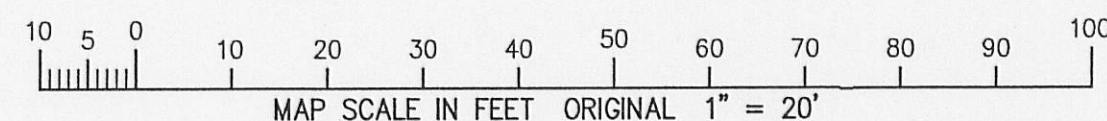

PLAT OF SURVEY
LOTS 42 & 43 OF
CONSUMERS COMPANY SUBDIVISION
TOGETHER WITH LANDS DESCRIBED IN VOL. 39 OF RECORDS, PAGES 184 & 185

LOCATED IN THE NW 1/4 SECTION 33
TOWN 2 NORTH, RANGE 17 EAST
WALWORTH COUNTY, WISCONSIN

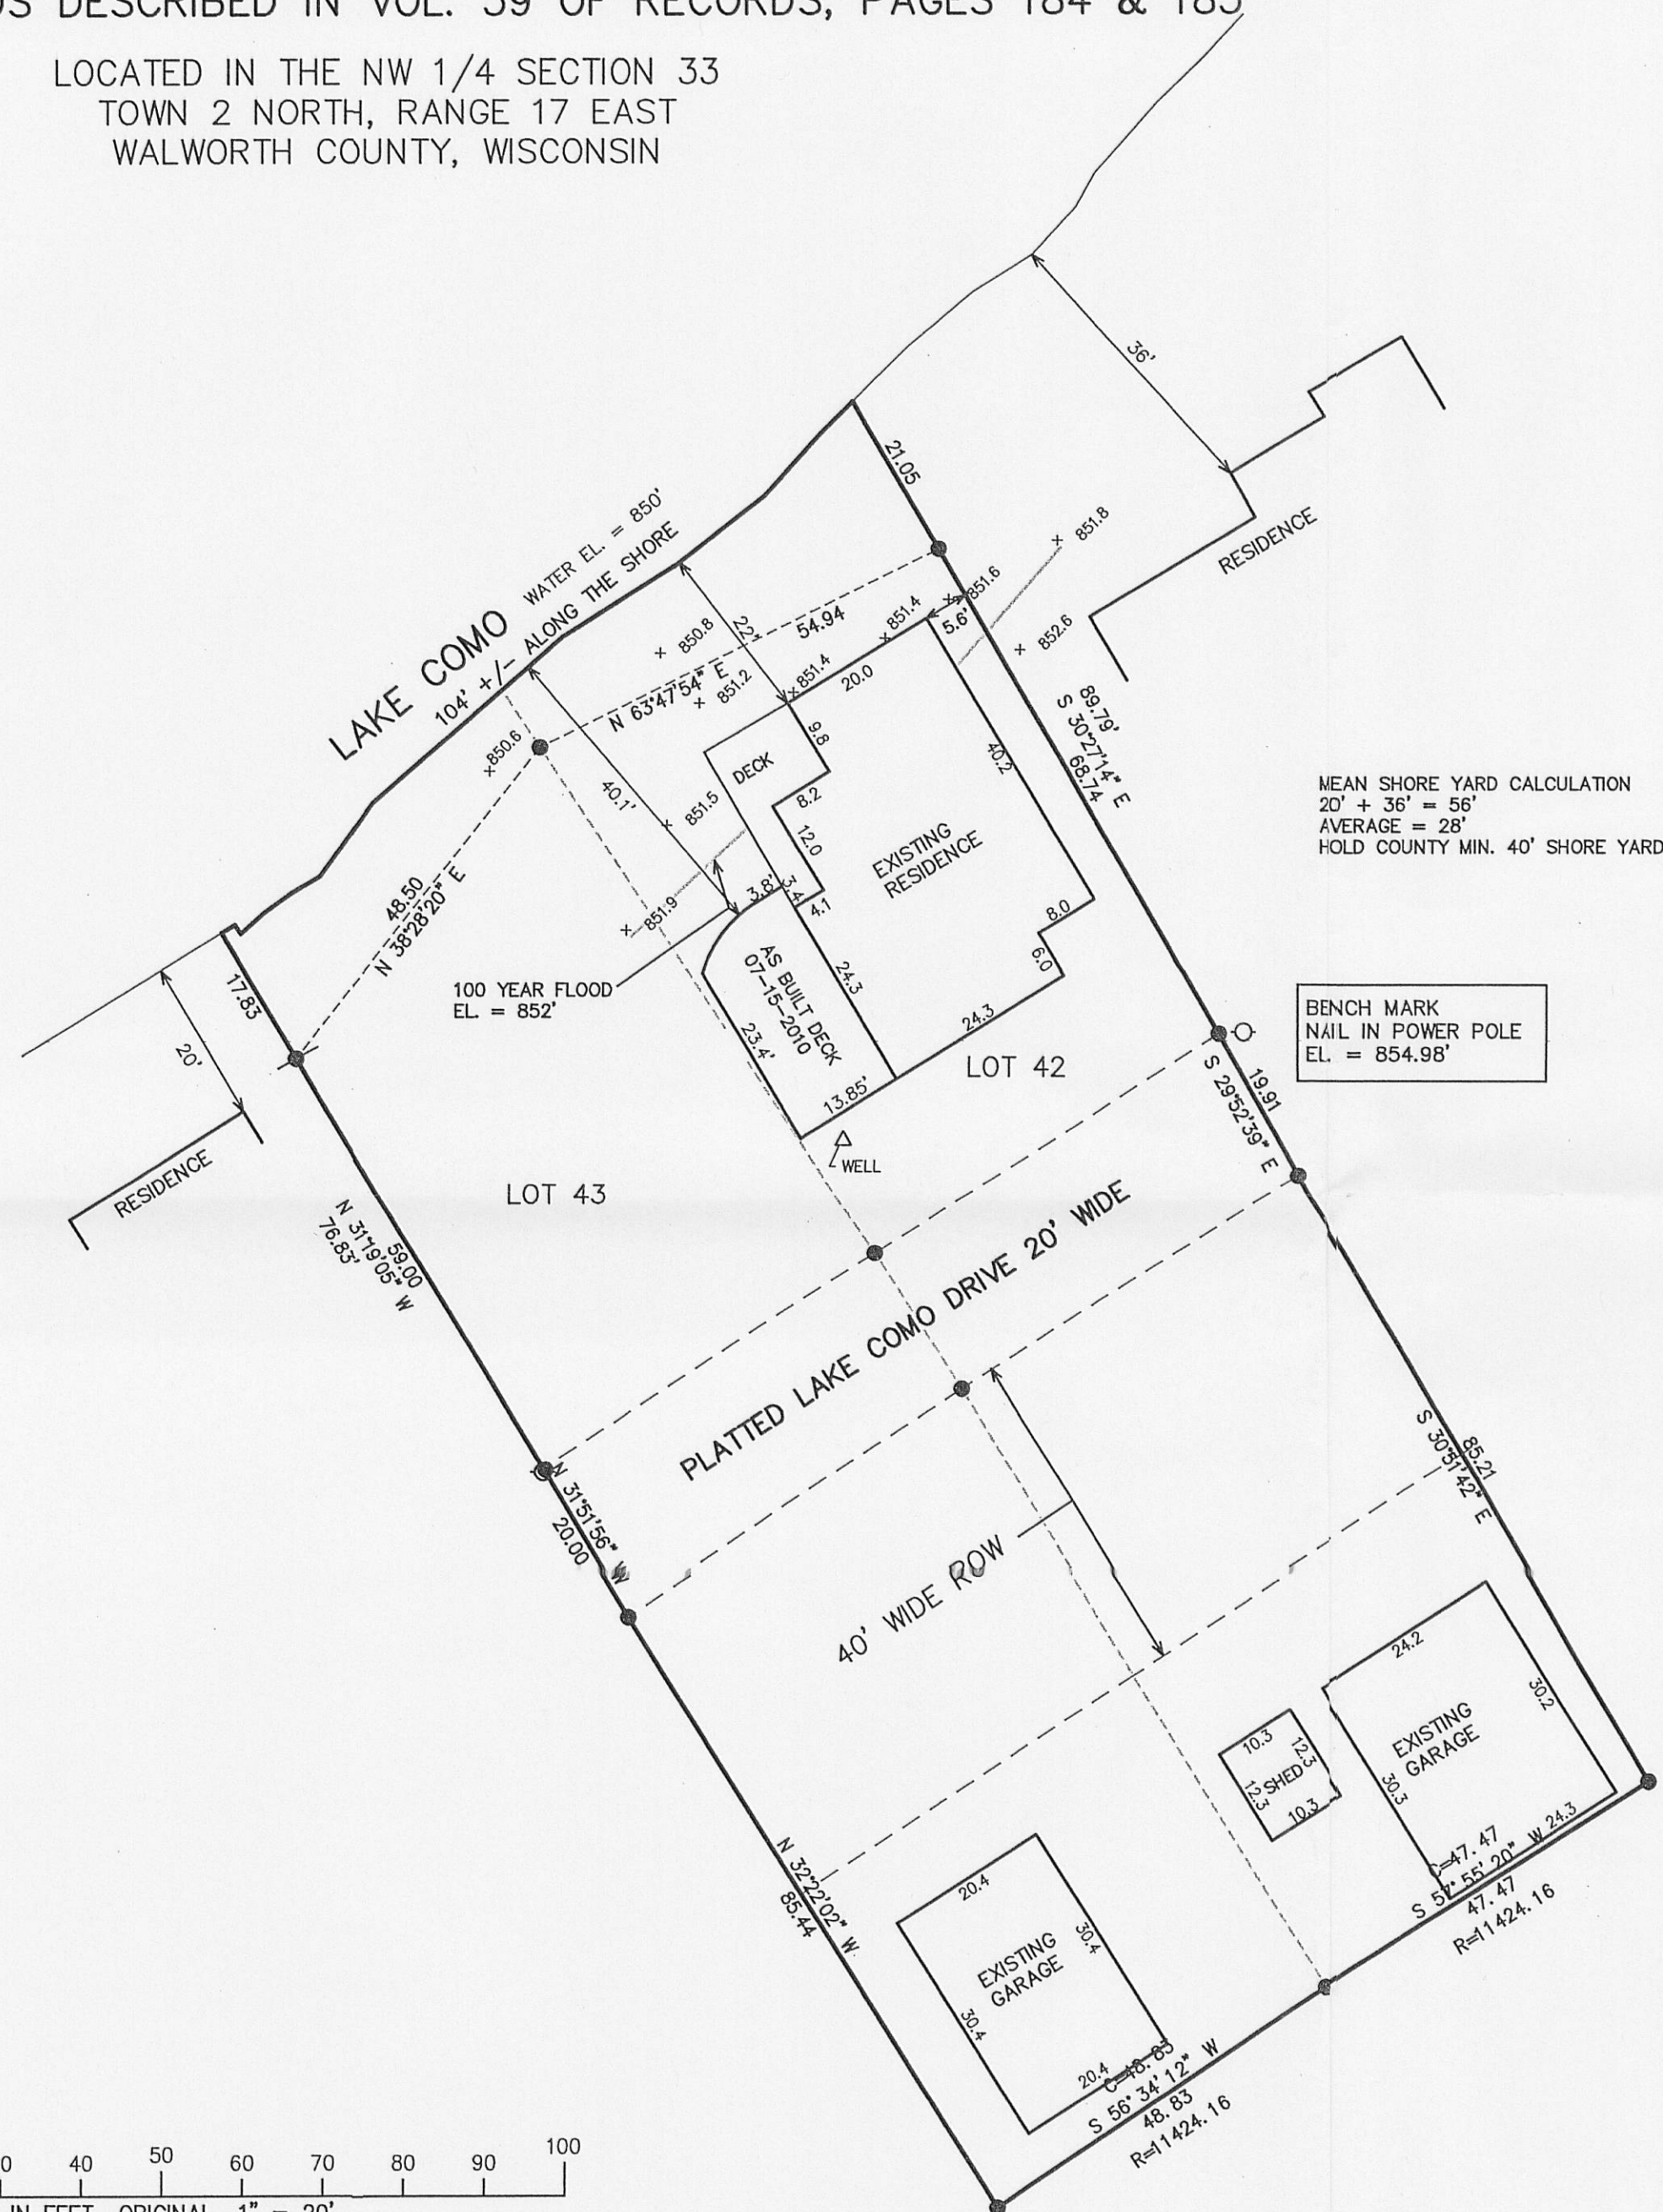

- LEGEND
- = SET IRON REBAR STAKE
 - = FOUND IRON REBAR STAKE
 - (XXX) = RECORDED AS

PARCEL AREA = 18,467 S.F. (0.42 ACRES)
VERTICAL DATUM USGS 1929ADJ



NOTE: COPIES OF THIS MAP TO WHICH THE FOLLOWING CERTIFICATE WILL APPLY SHOW SURVEYOR'S ORIGINAL SEAL AND SIGNATURE IN RED INK. COPIES BY ANY OTHER MEANS MAY HAVE ALTERATIONS WHICH DO NOT REPRESENT THE SURVEYOR'S WORK PRODUCT.

I HEREBY CERTIFY THAT THE ABOVE DESCRIBED PROPERTY HAS BEEN SURVEYED UNDER MY DIRECTION AND THAT THE ABOVE MAP IS A TRUE REPRESENTATION THEREOF AND SHOWS THE SIZE AND LOCATION OF THE PROPERTY AND ITS EXTERIOR BOUNDARIES. THIS SURVEY IS MADE FOR THE USE OF THE PRESENT OWNERS OF THE PROPERTY, AND ALSO THOSE WHO PURCHASE, MORTGAGE, OR GUARANTEE THE TITLE THERETO WITHIN ONE YEAR FROM THE DATE HEREOF.

DATE: MAY 20, 2010

REVISED 07-16-2010
TO SHOW SIZE & LOCATION OF
AS BUILT DECK

PETER S. GORDON R.L.S. 2101

WORK ORDERED BY:
MICHAEL REHBERG
W3464 SOUTH SHORE DRIVE
LAKE GENEVA, WI. 53147

FARRIS, HANSEN & ASSOCIATES, INC.
ENGINEERING - ARCHITECTURE - SURVEYING
7 RIDGWAY COURT P.O. BOX 437
ELKHORN, WISCONSIN 53121
OFFICE: (262) 723-2098 FAX: (262) 723-5886

REVISIONS

PROJECT NO.
8146
DATE:
05-18-2010
SHEET NO.
1 OF 1