

ordered by:
Sharon Sequin
for
Frank Curiale


PLAT OF SURVEY

- OF -

LOTS 12538 thru 12552 BLOCK 223 OF LAKE COMO BEACH SUBDIVISION;
LOCATED IN TOWN 2 NORTH, RANGE 17 EAST, WALWORTH COUNTY,
WISCONSIN

OVERLOOK DRIVE
(PLATTED AS 40' WIDE)
(this portion unimproved)

PATHFINDER SURVEYING INC.
(formerly)
J.K. SURVEYING INC.
P.O. BOX 322
LAKE GENEVA, WI, 53147
262-248-8303

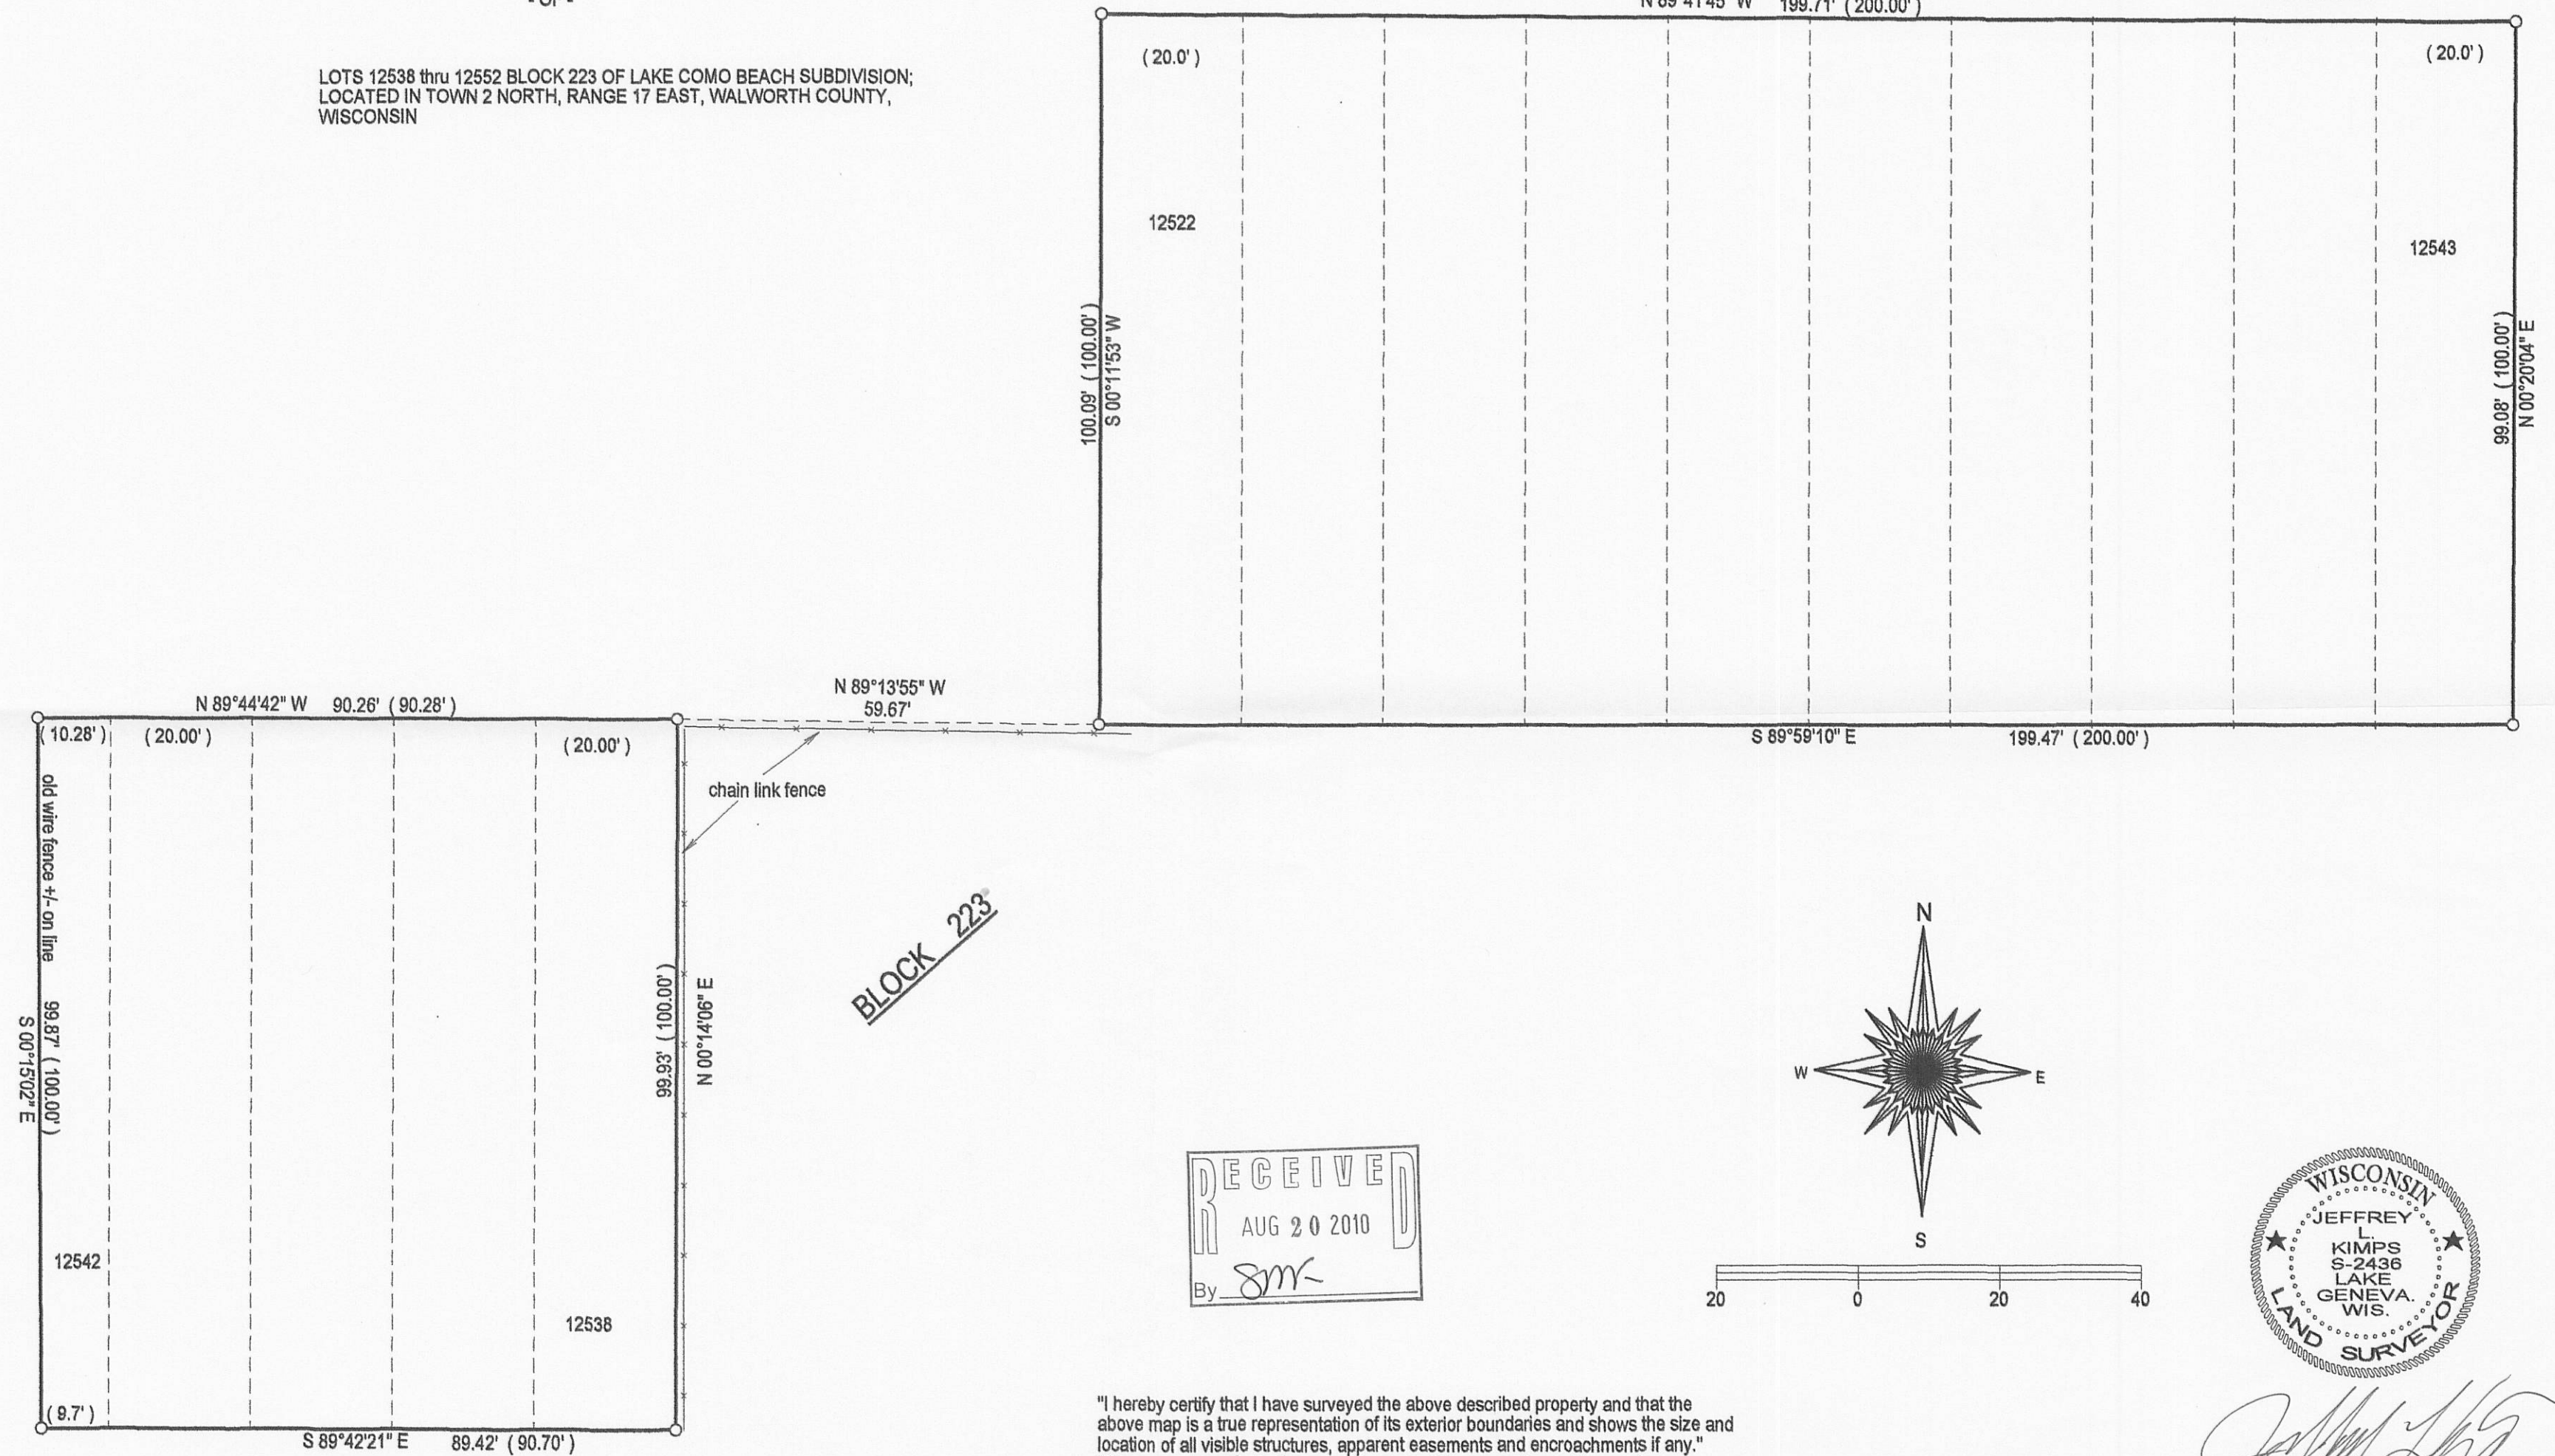

- () = recorded as
- = found iron bar
- = found iron pipe
- = set iron pipe
- = set iron bar

SCALE 1" = 20'

JOB # 10-77

TAX ID #

JLCB 02734

LINCOLN AVE.
(PLATTED AS 50' WIDE)
(this portion unimproved)

"I hereby certify that I have surveyed the above described property and that the above map is a true representation of its exterior boundaries and shows the size and location of all visible structures, apparent easements and encroachments if any." This survey is made for the present owners of the property, and those who purchase, mortgage, or guarantee the title thereto, within one year from the date hereof.

DATED THIS 4TH DAY OF JUNE, 2010.

JEFFREY L KIMPS S - 2436
Wisconsin Registered Land Surveyor
(original if signed in red)

217-3658