

Plat of Survey


of

Lots 6876 through 6880 in Block 117 of Lake Como Beach Subdivision,

located in the Southwest 1/4 of Section 28, Town 2 North, Range
17 East, Town of Geneva, Walworth County, Wisconsin.

Surveyed for: **Rebuild & Restore, LLC.**


N6884 Avataia Trail
Elkhorn, Wisconsin. 53121

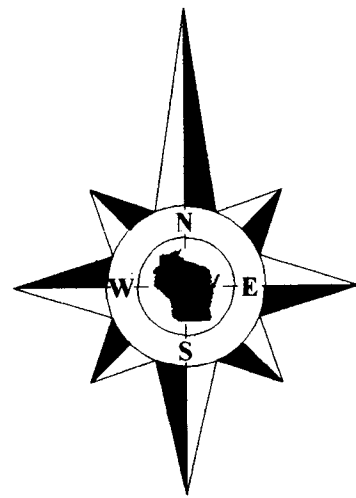

Bearings reference to the Wisconsin State
Plane Coordinate System, South Zone.

Detail

1"=10'

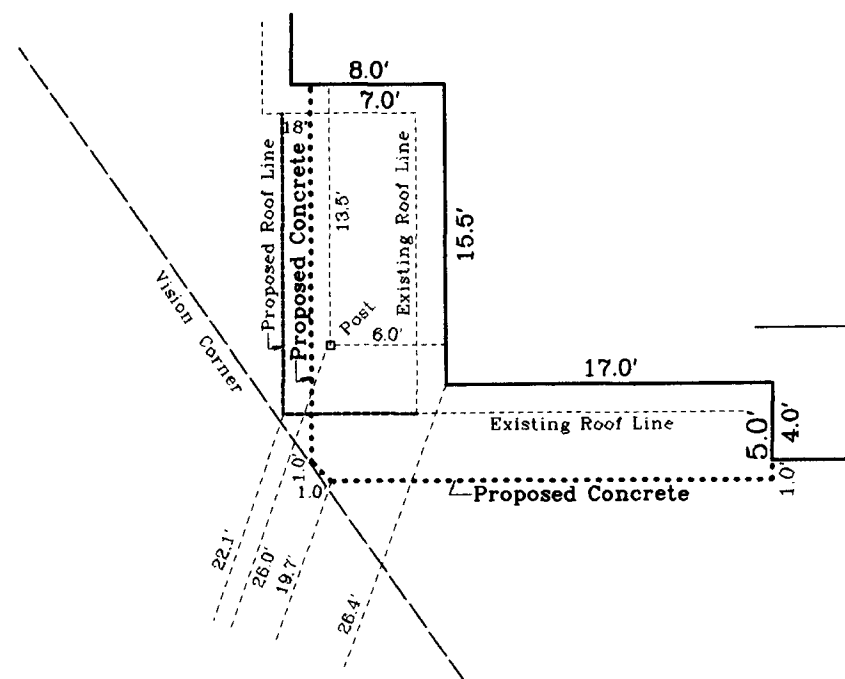


Copyright 2009 by Jensen & Olson Land Surveying, LLC.

All rights reserved. No part of this survey plat may be reproduced or transmitted in
any form by any means - graphic, electronic, or mechanical, including photocopying,
tracing, or information storage and retrieval systems - without permission in writing
from Douglas G. Olson, Jensen & Olson Land Surveying, LLC.

I hereby certify that I have surveyed the above described property and the map
hereon is correct to the best of my professional knowledge and belief and shows the size
and location of the property, its exterior boundaries, the location and dimensions of all
visible structures thereon, boundary fences, apparent easements and roadways and
visible encroachments, if any.


This survey is made for the exclusive use of the present owners of the property,
and also those who purchase, mortgage or guarantee title thereto, within one year from
the date hereof.

Douglas G. Olson
Wisconsin Registered Land Surveyor - 2093

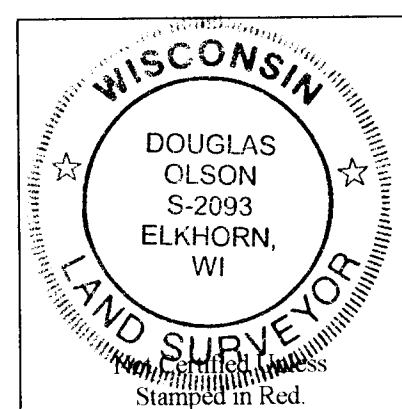

Notes:

- 1) This survey plat is not
certified unless signed
and sealed in red ink.
- 2) This survey is subject to Wisconsin lien laws.
This Plat of Survey is the notice of intent
to file lien. Lien waiver required.

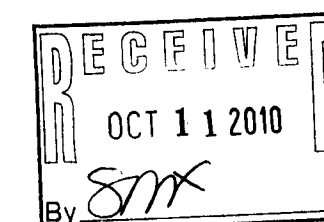

Mistle Road
(40' Wide)

Lot 6873

Lot 6874

Lot 6875

(S89°39'56"E 100.00')
S89°50'37"E 100.37'

Lot 6876

Lot 6877

Poured
Concrete
Foundation

Tax Parcel
JLCB 01447

0.200 Acre
8,717 Sq.Ft.

Lot 6878

Lot 6879

Lot 6880

Lot 6847

Lot 6848

Lot 1

Lot 2

Longfellow Drive
(40' Wide)

Survey Date: February 26, 2010
Revisions: No. 1 - Topographic Data
No. 2 - Proposed House
No. 3 - Foundation
No. 4 - Grading Info
No. 5 - House staked on
No. 6 - Footings
No. 7 - Foundation
No. 8 - Prop. Concrete

Scale in Feet
1" = 20'



Jensen & Olson Land Surveying, LLC
45 South Wisconsin Street * P.O. Box 322 * Elkhorn, Wisconsin. 53121
Telephone: (262) 723-3434 * Facsimile: (262) 723-8044
Email: jensen.olson@elknet.net

Legend

- Found Iron Pipe
- Set Iron Rod, 3/4" dia.
- Recorded Information
- Manhole
- Utility Pole
- Asphalt Surface
- Water Valve

Sheet 1 of 1 Sheets
Job Reference Number
2010.019

2010.019

217-3673