

LAND-MARK SURVEYING

Mark L. Miritz

Wisconsin Registered Land Surveyor S-2582

N9330 Knuteson Drive
Whitewater, WI 53190
Phone: (262) 495-3284
FAX : (262) 495-8421
LAND-MARKSURVEYING.COM

PLAT OF SURVEY

LOTS 2915, 2916, 2917, 2918, 2919 AND 2920, BLOCK 50, LAKE COMO BEACH SUBDIVISION, LOCATED TOWN 2 NORTH, RANGE 17 EAST, GENEVA TOWNSHIP, WALWORTH COUNTY, WISCONSIN.

Ordered by:
Schauder Homes
4115 U.S. Hwy "51" North
Janesville, WI 53545-9674

SITE ADDRESS: N3236 TULIP ROAD (S 89°39'56" E 100.00')

BENCHMARK
SANITARY SEWER RIM
ELEV ASSUMED 874.00'
INVERT ELEV = 860.36'


TULIP ROAD

40' WIDE

EDGE OF BLACKTOP

BENCHMARK
TOP NUT OF FIRE
HYDRANT ELEV = 869.18'

SANITARY SEWER RIM ELEV = 864.39'
INVERT ELEV = 850.91'

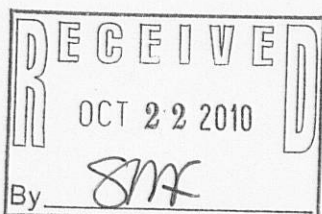

LEGEND

- FOUND IRON PIPE
- FOUND IRON ROD
- UTILITY POLE
- (x x) RECORDED AS DIMENSION
- EXISTING FENCE

SCALE: 1 INCH = 20 FEET

"I hereby certify that the above described property has been surveyed by me or under my direction and that the above map is a true representation thereof and shows the size and location of the property, its exterior boundaries, the location of all visible structures and dimensions of all principal buildings thereon, boundary fences, apparent easements, roadways and visible encroachments, if any."
"This survey is made for the use of the present owners of the property, and also those who purchase, mortgage, or guarantee the title thereto within one year from date hereof."

MARK L. MIRITZ
WISCONSIN REGISTERED
LAND SURVEYOR S-2582

REVISED 9/24/2010 TO SHOW FOUNDATION "AS BUILT"

DATE: JULY 14, 2010

JOB NO. 10.703