


PLAT OF SURVEY

N3705 WILLOW BEND LANE
LAKE GENEVA WI. 53147
PHONE # (262)248-3697
FAX # (262)249-0639

-OF-


UNIT 26-13 GENEVA NATIONAL CONDOMINIUM NO. 26
LOCATED IN SECTION 29, TOWN 2 NORTH, RANGE 17 EAST,
WALWORTH COUNTY, WISCONSIN.

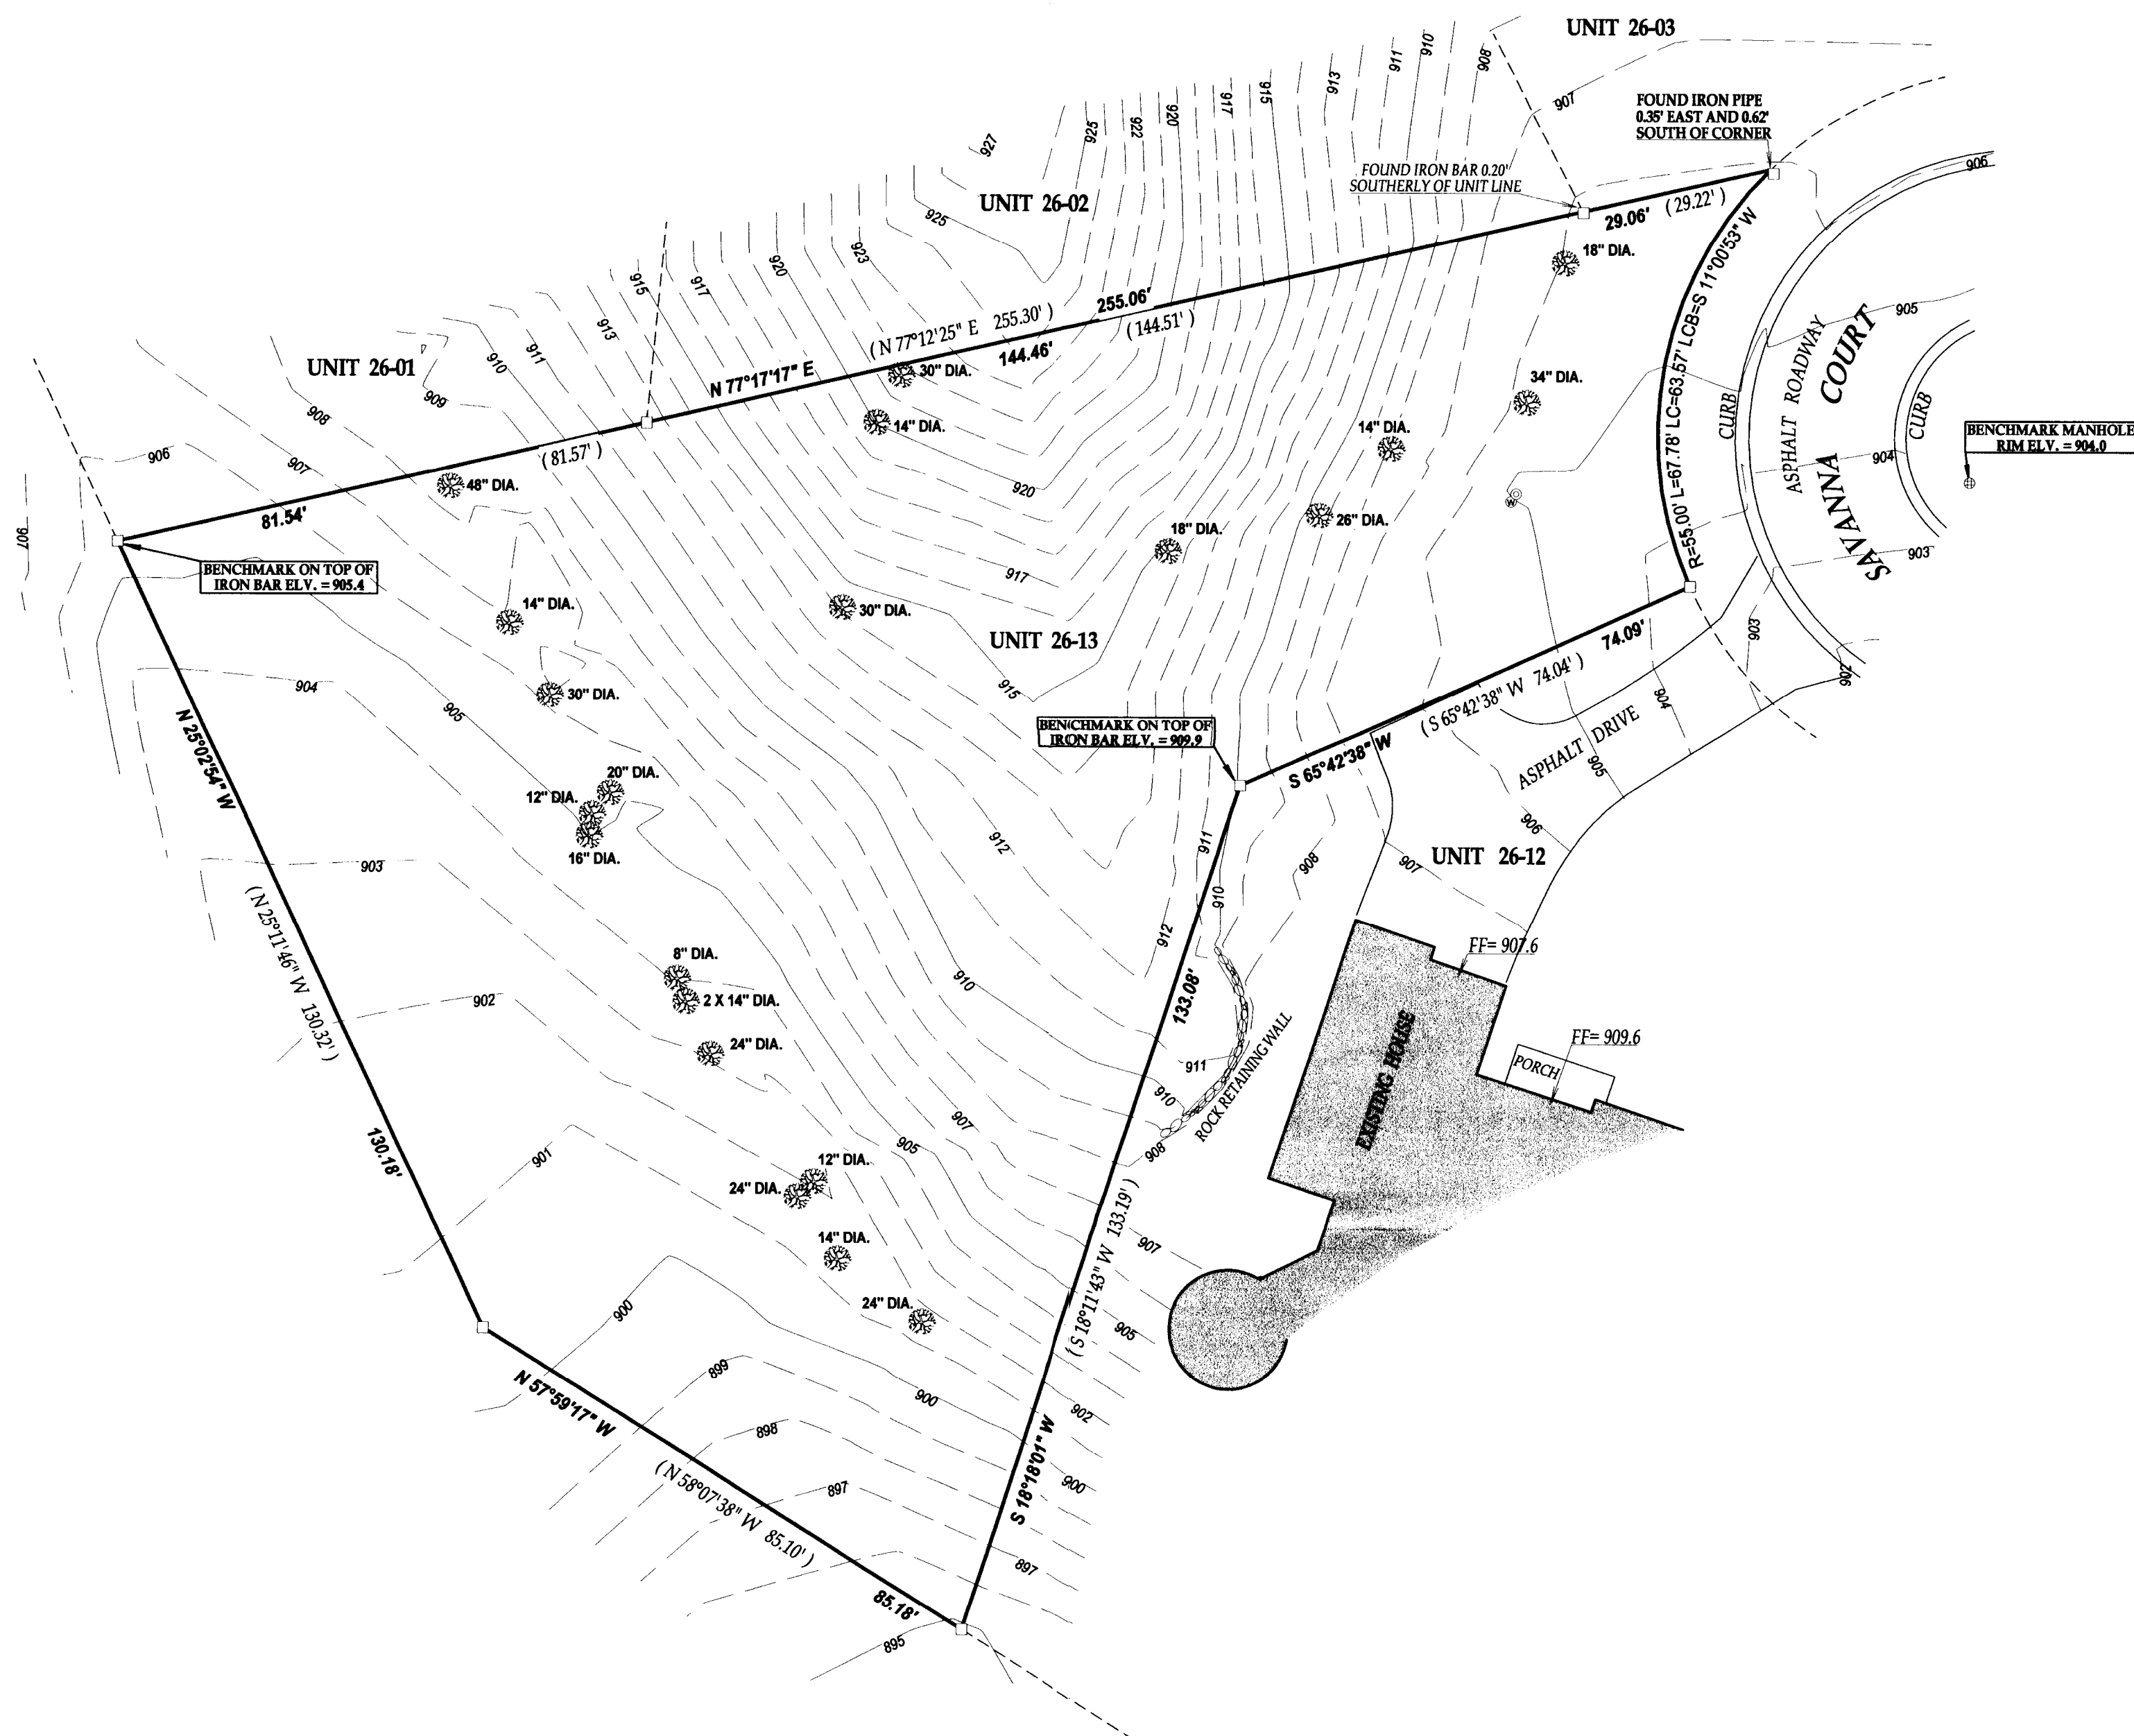

LEGEND

-  **FOUND IRON BAR**
 WATER VALVE
 **SEWER LATERAL**
 **DECIDUOUS TREE**

(XX) RECORDED AS
TAX ID # JGN2600013
JOB # 10-178


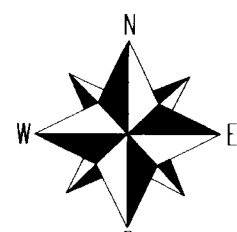


SCALE 1"=20'

NOTE : BEARINGS ARE REFRENCED TO THE RECORD PLAT

I have surveyed the above-described property and the above map is a true representation thereof and shows the size and location of the property, its exterior boundaries, the location and dimensions of all structures thereon, fences apparent easements and roadways and visible encroachments, if any.

This survey is made for the exclusive use of the present owners of the property, and also those who purchase, mortgage, or insure the title thereto within one (1) year from date hereof; and as to them I warrant the accuracy of said survey map.

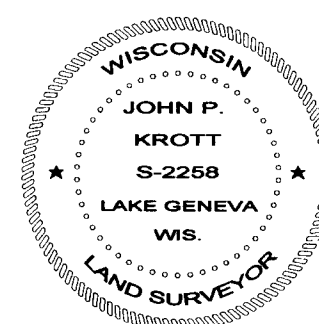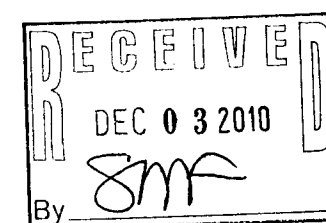

DATED THIS 6th DAY OF NOVEMBER 2010.


JOHN KROTT S - 2258
Wisconsin Registered Land Surveyor
(original if signed in red)