

PREPARED FOR
DIANE COCROFT
KEEFE REALESTATE
751 GENEVA PARKWAY
LAKE GENEVA WI. 53147


PLAT OF SURVEY

-OF-



LOTS 8727 THRU 8731 AND LOTS 8756 THRU 8758, BLOCK 152 OF THE
FOURTH MAP OF LAKE COMO BEACH SUBDIVISION, LOCATED IN
SECTION 21, TOWN 2 NORTH, RANGE 17 EAST, WALWORTH COUNTY,
WISCONSIN.

KROTT SURVEYING INC.

N3705 WILLOW BEND LANE
LAKE GENEVA WI. 53147
PHONE # (262)248-3697
FAX # (262)249-0639

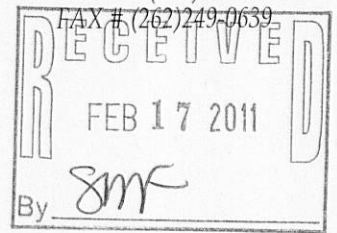


C.L. CHERRY ROAD
(40' WIDE)

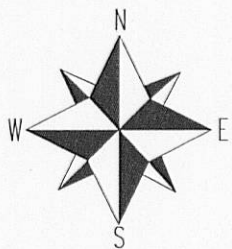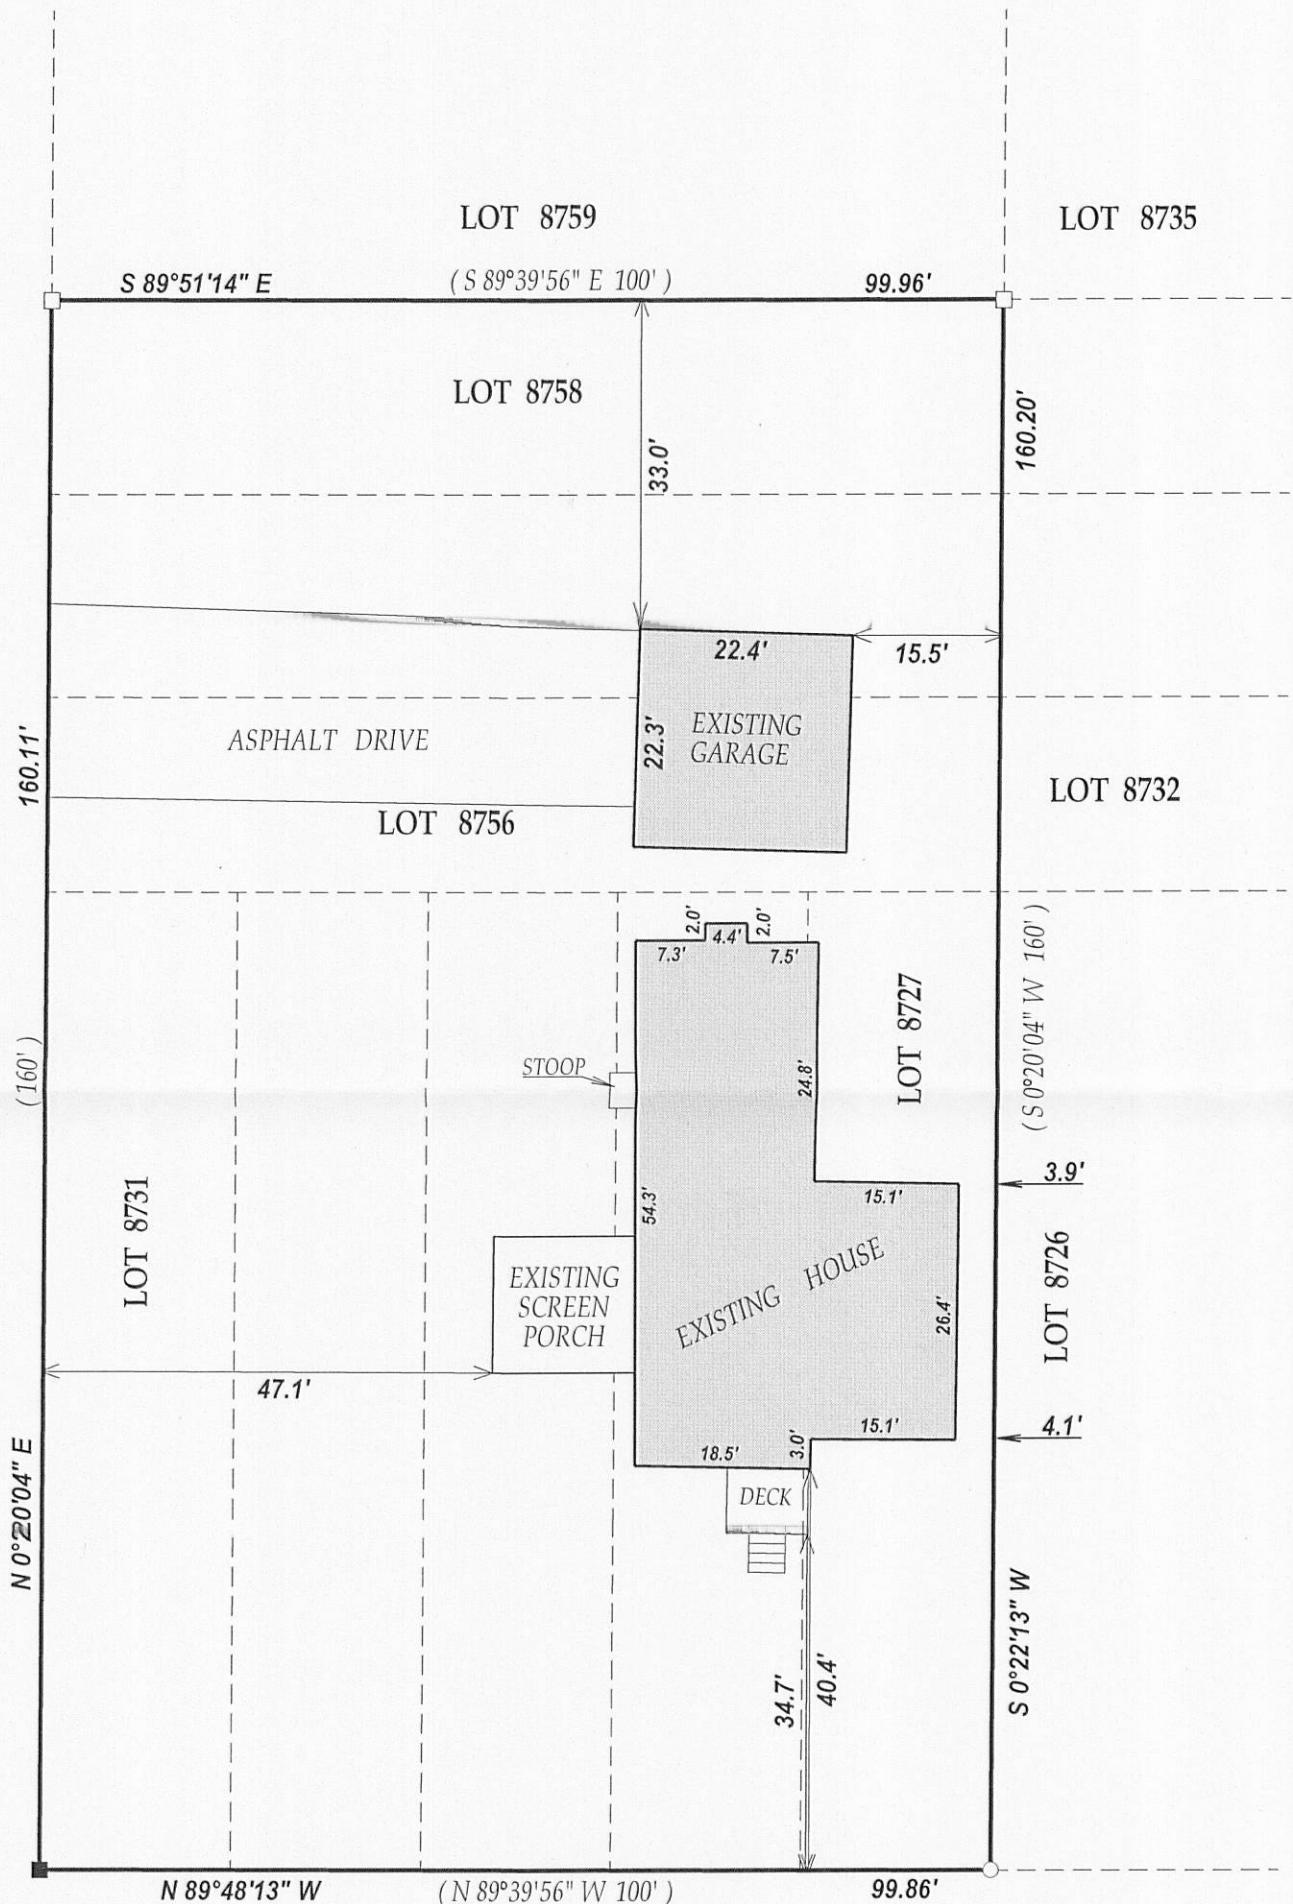

C.L. WASHINGTON DRIVE
(40' WIDE)

SCALE 1" = 20'

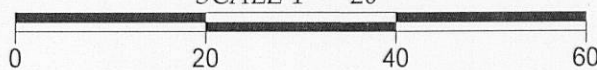

LEGEND

- FOUND IRON PIPE
- FOUND IRON BAR
- SET IRON BAR

(XX) RECORDED AS
TAX ID# JLCB01869
JOB # 11-020

I have surveyed the above-described property and the above map is
a true representation thereof and shows the size and location of the
property, its exterior boundaries, the location and dimensions of all
structures thereon, fences apparent easements and roadways and
visible encroachments, if any.

This survey is made for the exclusive use of the present owners of
the property, and also those who purchase, mortgage, or insure the
title thereto within one (1) year from date hereof; and as to them I
warrant the accuracy of said survey map.



DATED THIS 14th DAY OF FEBRUARY 2011.

John P. Krott

JOHN KROTT S - 2258
Wisconsin Registered Land Surveyor
(original if signed in red)