

FARRIS, HANSEN & ASSOCIATES, INC.

ENGINEERING - ARCHITECTURE - SURVEYING

7 RIDGWAY COURT - P.O. BOX 437 - ELKHORN, WISCONSIN 53121

PHONE: (262) 723-2098 FAX: (262) 723-5886

PLAT OF SURVEY

ASSIGNED THE WEST LINE OF BLOCK 50
NORTH

Parcel 1:


Lots 2925, 2926, 2927, 2928 and 2929, Block 50, as designated and delineated on the map entitled "Second Map of Lake Como Beach, Walworth County, Wisconsin" and recorded in the Office of the Register of Deeds in and for the County of Walworth and State of Wisconsin on the 1st day of May, 1926.

JLCB 00520

Parcel 2:

Lots 2923 and 2924, Block 50, as designated and delineated on the map entitled "Second Map of Lake Como Beach, Walworth County, Wisconsin" and recorded in the Office of the Register of Deeds in and for the County of Walworth and State of Wisconsin on the 1st day of May, 1926.

Tax Key No. JLCB 00512

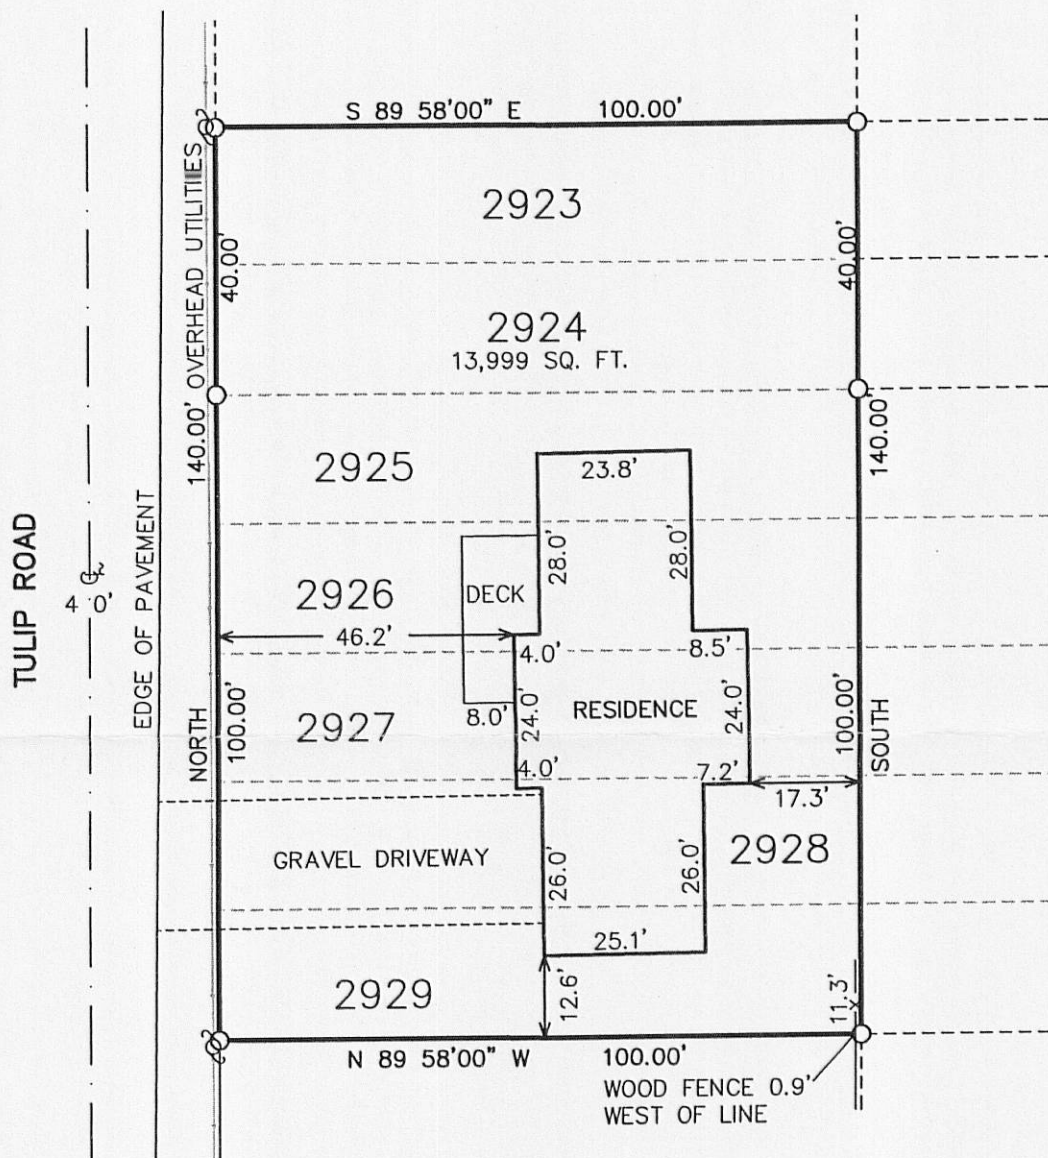


NOTE:
GAS MAIN EASEMENT RECORDED AS DOC. 475581 ALLOWS FOR GAS MAINS AND STRUCTURES
WITHIN THE ROADS, PATHS, WALKS, ALLEYS, PARKS, PLAYGROUNDS, AND TENNIS COURTS
WITHIN LAKE COMO BEACH.

- WORK ORDERED BY -
KEEFE REAL ESTATE
751 GENEVA PARKWAY
LAKE GENEVA, WI. 53147

LEGEND

O = FOUND IRON PIPE STAKE
○ - UTILITY POLE
(XXX) = RECORDED AS

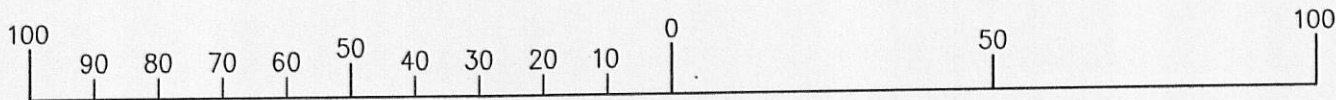



MAP SCALE IN FEET ORIGINAL 1" = 30'

NOTE: COPIES OF THIS MAP TO WHICH THE FOLLOWING CERTIFICATE WILL APPLY SHOW SURVEYOR'S ORIGINAL SEAL AND SIGNATURE IN RED INK. COPIES BY ANY OTHER MEANS MAY HAVE ALTERATIONS WHICH DO NOT REPRESENT THE SURVEYOR'S WORK PRODUCT.

I HEREBY CERTIFY THAT THE ABOVE DESCRIBED PROPERTY HAS BEEN SURVEYED UNDER MY DIRECTION AND THAT THE ABOVE MAP IS A TRUE REPRESENTATION THEREOF AND SHOWS THE SIZE AND LOCATION OF THE PROPERTY, ITS EXTERIOR BOUNDARIES, THE LOCATION OF ALL VISIBLE STRUCTURES, AND DIMENSIONS OF ALL PRINCIPLE BUILDINGS THEREON, BOUNDARY FENCES, APPARENT EASEMENTS, ROADWAYS, AND VISIBLE ENCROACHMENTS, IF ANY. THIS SURVEY IS MADE FOR THE USE OF THE PRESENT OWNERS OF THE PROPERTY, AND ALSO THOSE WHO PURCHASE, MORTGAGE, OR GUARANTEE THE TITLE THERETO WITHIN ONE YEAR FROM THE DATE HEREOF.

DATED: MAY 2, 2011

Peter S. Gordon
PETER S. GORDON R.L.S. 2101

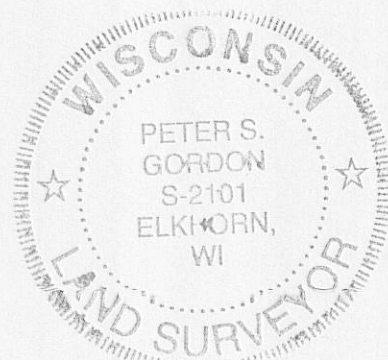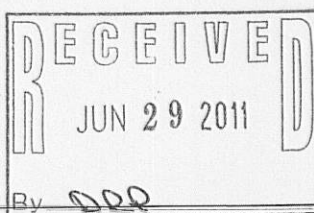

PROJECT: 8348
DATE: 05-02-2011
SHEET 1 OF 1

JLCB -512 JLCB -520

217-3720